


VALLEY VIEW #50 TUNNEL  
1"=100' HARMAN COAL CO.  
CROSS SECTION.

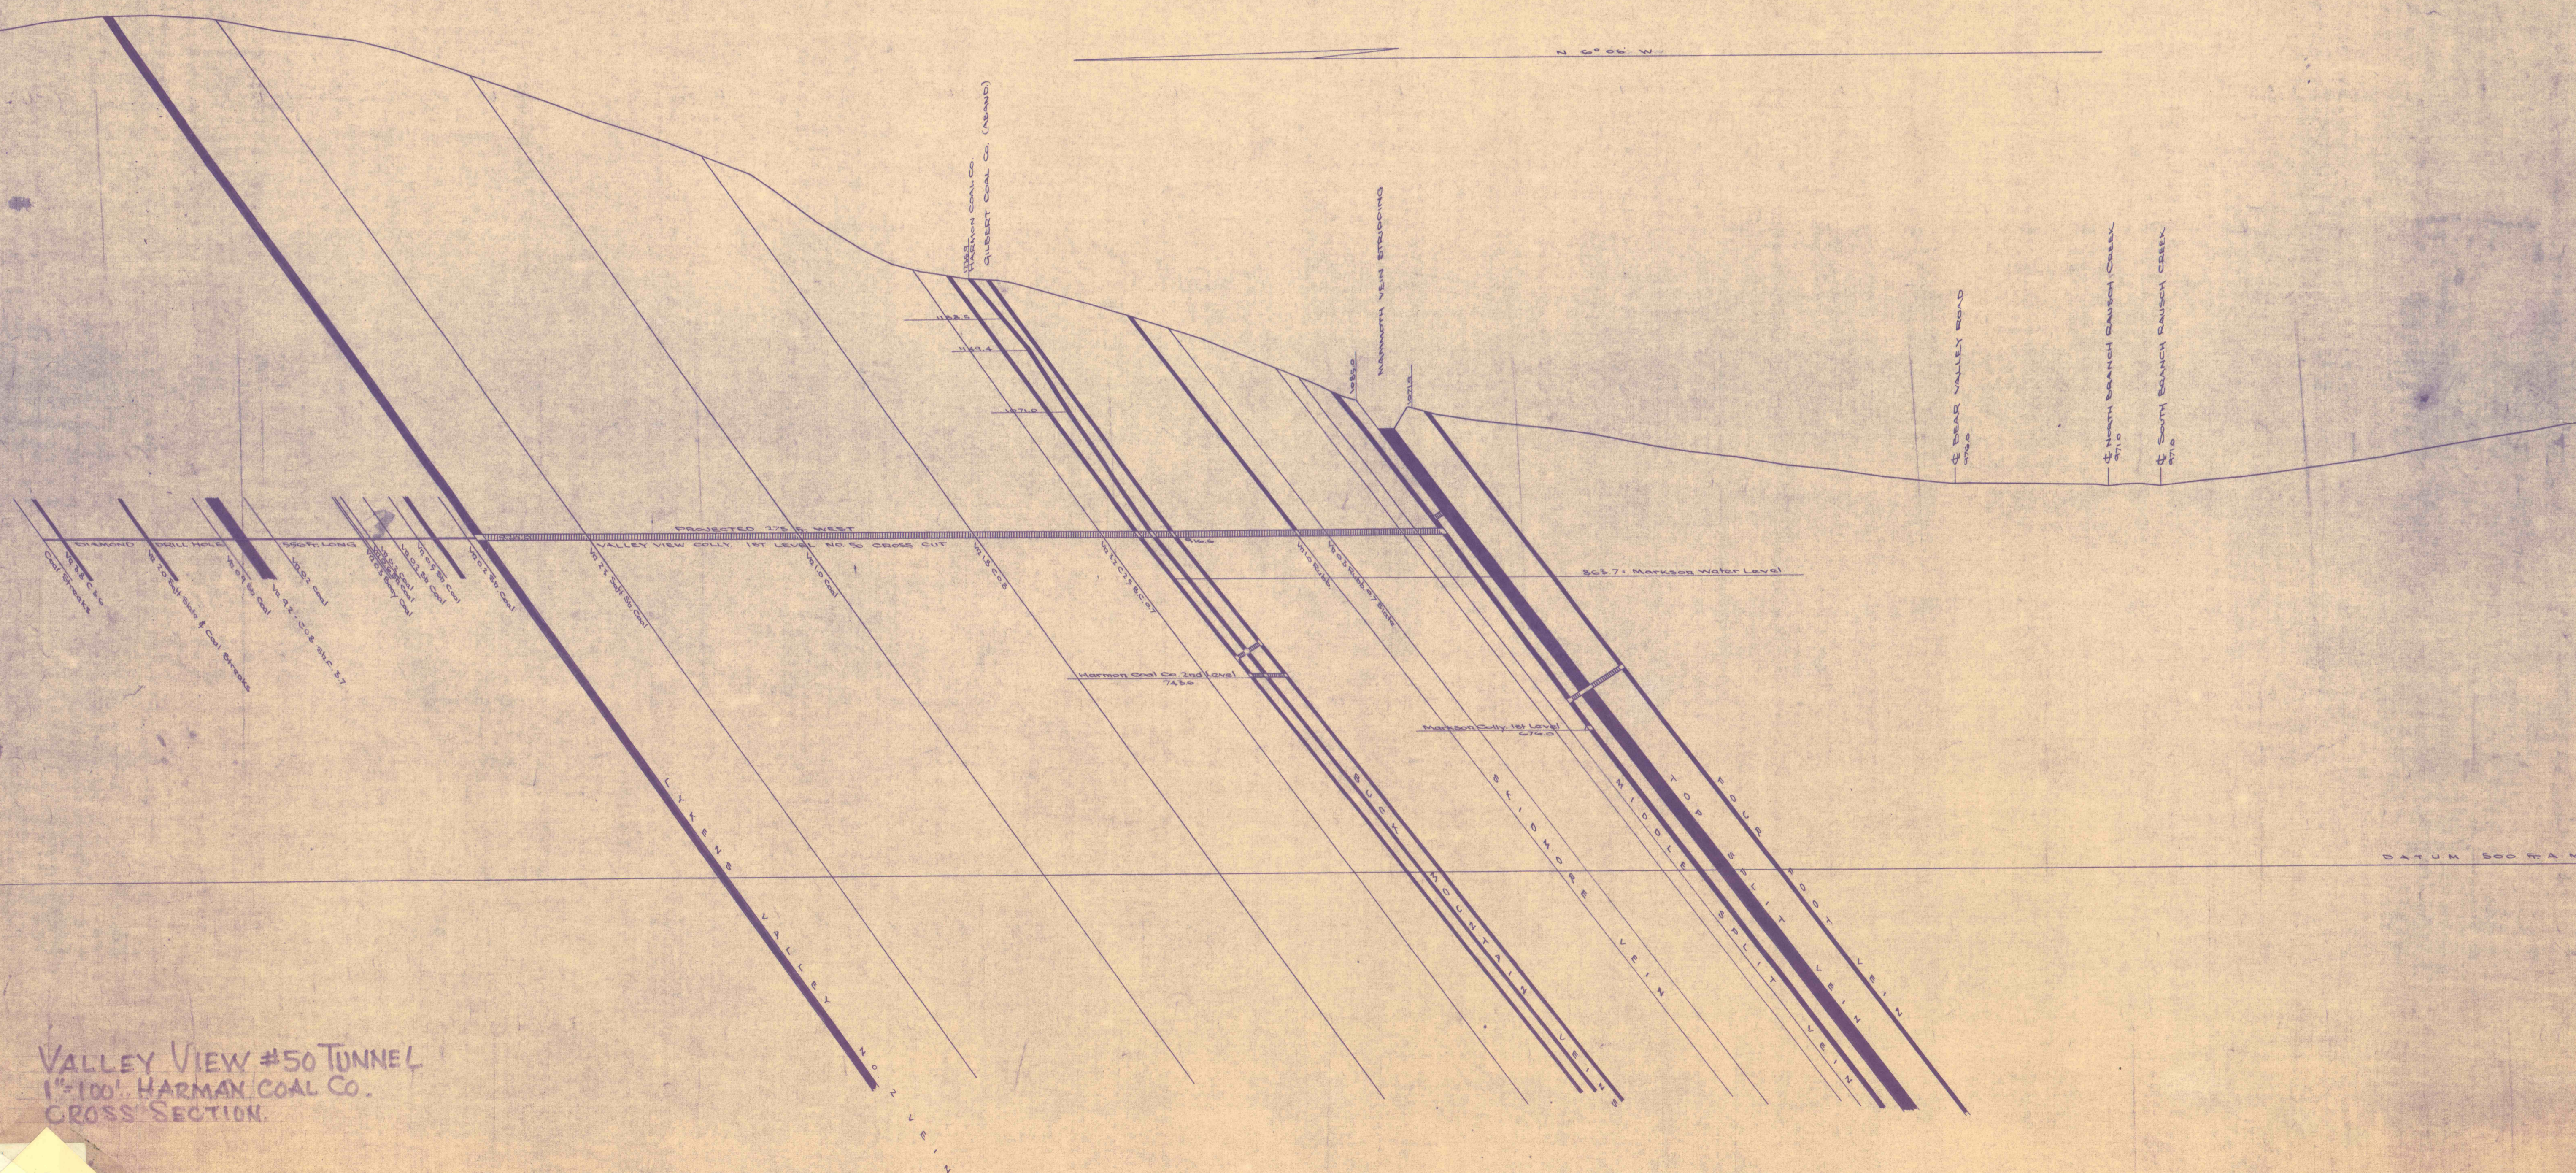

F. B. 13

8-30