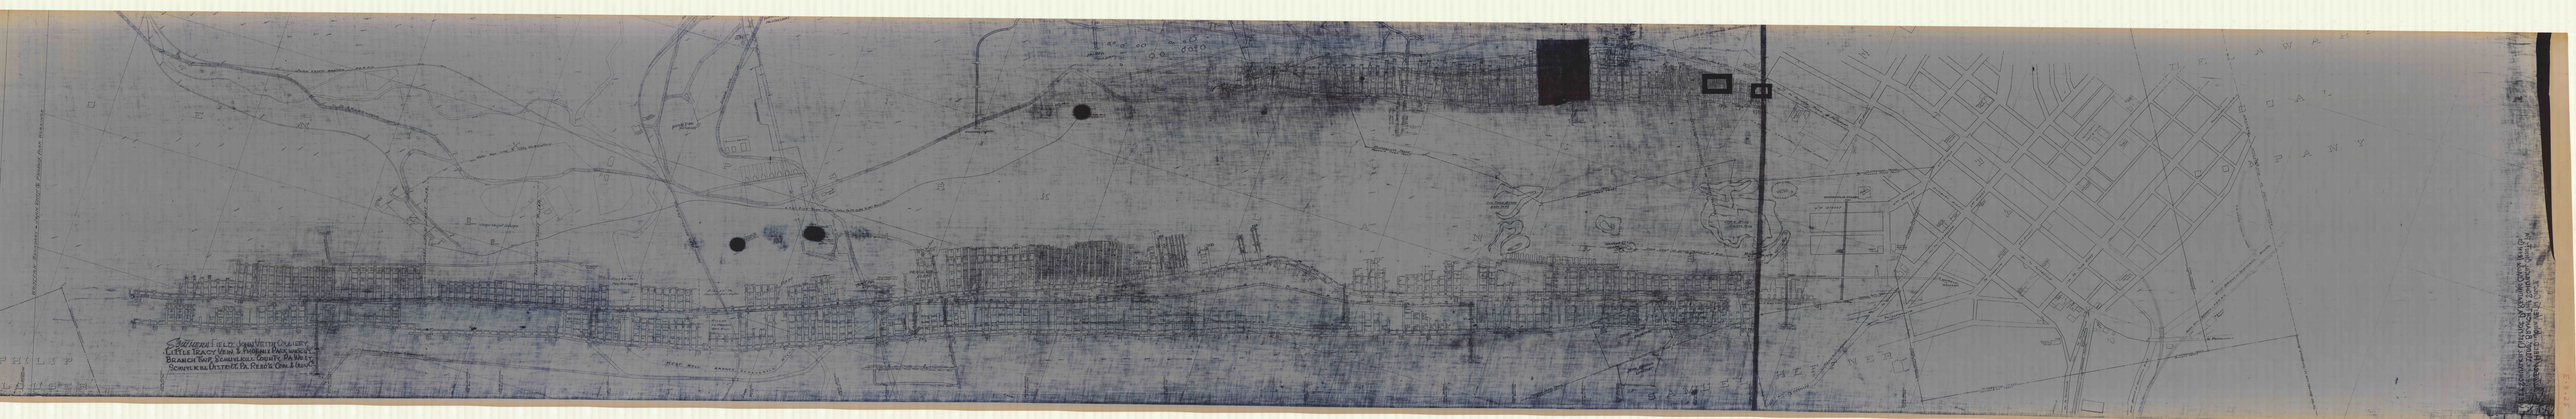

JOHN VEITH BRANCH P.&R.R.R.
TO BRANCHDALE
Water Pipe Line to John Veith Colliery
WEST LINE OF SHAFT PILLAR
EAST LINE OF SHAFT PILLAR
JOHN VEITH SHAFTS
PHOENIX PARK No.1 COLLIERY
PHOENIX PARK No.3 COLLIERY
STEAM LINE
BRANCH P.&R.R.R.
Air Pipe Line from John Veith Colly to No.1 Bore Hole
WESTERN BOUNDARY – JOHN VEITH COLLIERY – JOHN VEITH & PHOENIX PARK WORKINGS
PHOENIX TUNNEL
PALMER COLLIERY
CADBURY DRIFT
PILLAR TO PROTECT CREEK
PILLAR TO PROTECT RAILROAD
PILLAR TO PROTECT RAIL ROAD
DAM
TRACY AIR SHAFT
PERCIVAL SLOPE
TO BRANCHDALE – PUBLIC ROAD – TO MINERSVILLE
WEST WEST BRANCH SCHUYLKILL RIVER
MINERSVILLE TRACT
PHOENIX PARK TRACT
COAL FIELD BANKS 5,000 TONS
LEWIS BANK 210,000 TONS
KANTNER SLOPE
MULLEN SLOPE
MOUNT PEACE CEMETERY
IRISH CATHOLIC CEMETERY
NORTH SIDE OF MINERSVILLE BOROUGH
MINERSVILLE BOROUGH
TO PHOENIX PARK & PRIMROSE
CATHOLIC CEMETERY
UNION CEMETERY
MINERSVILLE TUNNEL
PUBLIC SCHOOL
4TH STREET
3RD STREET
2ND STREET
SUNBURY STREET
TO LLEWELLYN
TO POTTSVILLE
TO PINE KNOT
ROAD TO LLEWELLYN
SALEM AND WALLS GAP
WELSH CHURCH
ROAD TO HECKSCHERVILLE
BRANCH PENNA. R.R.
WEST BRANCH P.&R.R.R.
WEST BRANCH SCHUYLKILL RIVER
MINE HILL BRANCH
LITTLE BRANCH PENNA. R.R.
EASTERN LINE OF MINERSVILLE BOROUGH
EASTERN BOUNDARY LINE OF MINERSVILLE BOROUGH
BULLOCK TRACT
DELAWARE COAL COMPANY
PHILIP HOUSER
SAMUEL HEFFNER
DENKLA

[redacted]

SOUTHERN FIELD. JOHN VEITH COLLIERY.
LITTLE TRACY VEIN, & PHOENIX PARK WRK'G'S.
BRANCH TWP. SCHUYLKILL COUNTY, PA. WEST
SCHUYLKILL DISTRICT. PA. READ'G COAL & IRON CO.

E.8.25