DUMP ROAD RAUCH CREEK

SCALE 1"=20'

WEST 8+50 EAST

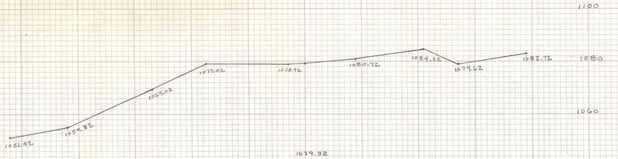

WEST 8+00 EAST

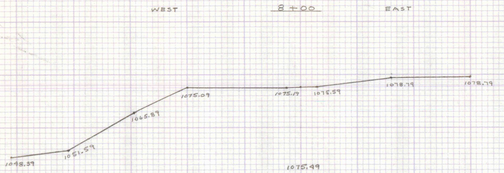

WEST 7+50 EAST

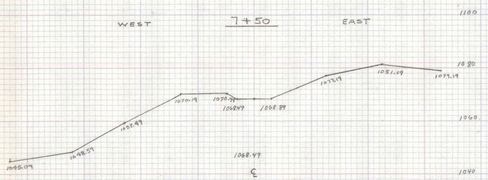

WEST 7+00 EAST

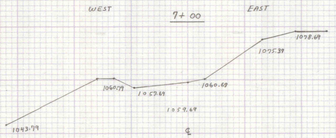

WEST 6+50 EAST

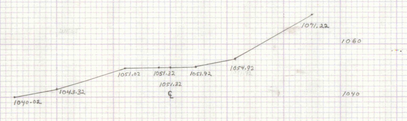

WEST 6+00 EAST

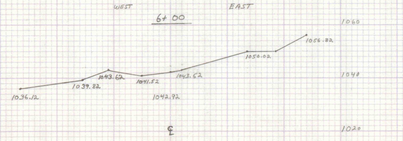

SOUTH 11+00 NORTH

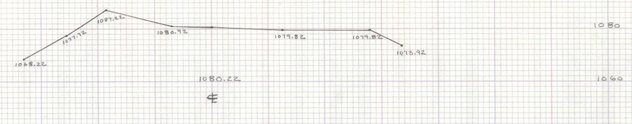

SOUTH 10+50 NORTH

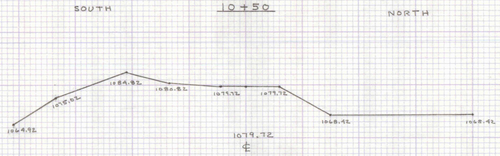

SOUTH 10+00 NORTH

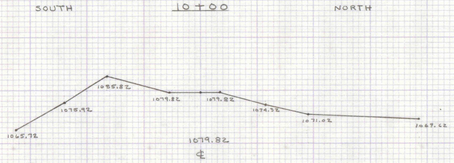

SOUTH 9+50 NORTH

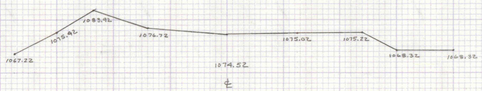

SOUTH 9+00 NORTH

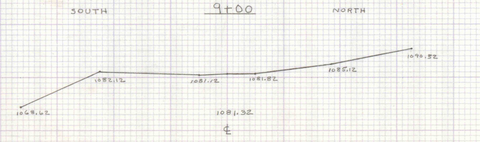

SOUTH 13+50 NORTH

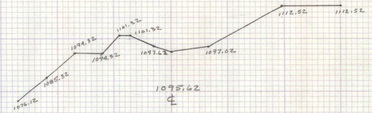

SOUTH 13+00 NORTH

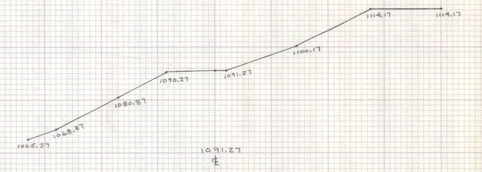

SOUTH 12+50 NORTH

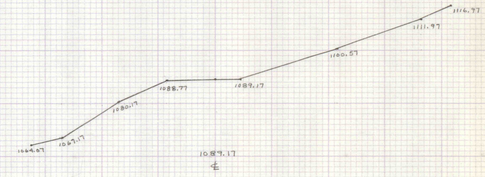

SOUTH 12+00 NORTH

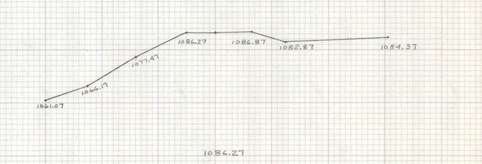
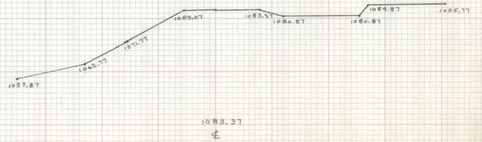
SOUTH 11+50 NORTH