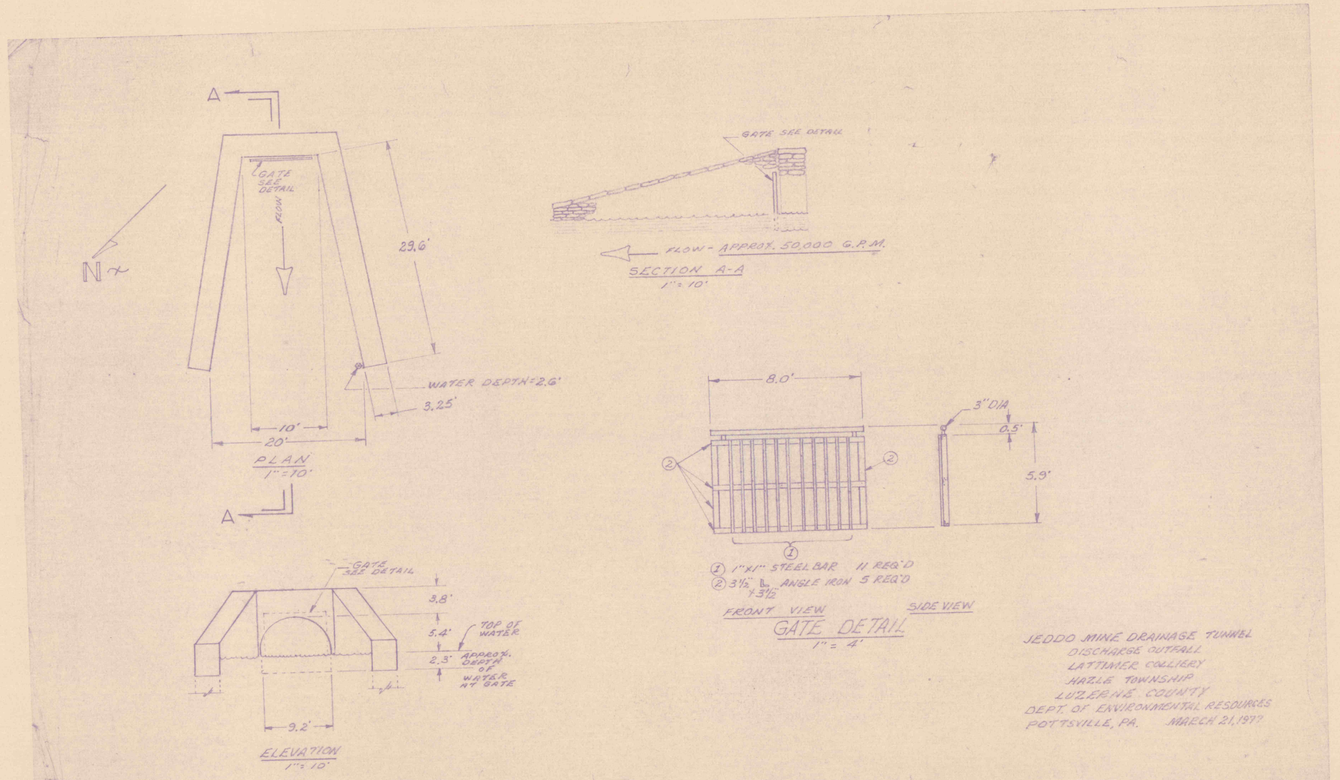

JEDDO MINE DRAINAGE TUNNEL
DISCHARGE OUTFALL
LATTIMER COLLIERY
HAZLE TOWNSHIP
LUZERNE COUNTY
DEPT. OF ENVIRONMENTAL RESOURCES
POTTSVILLE, PA. MARCH 21, 1977






