


- ① 1" x 1" STEEL BAR 11 REQ'D
- ② 3 1/2" L ANGLE IRON 5 REQ'D

GATE DETAIL  
1" = 4'

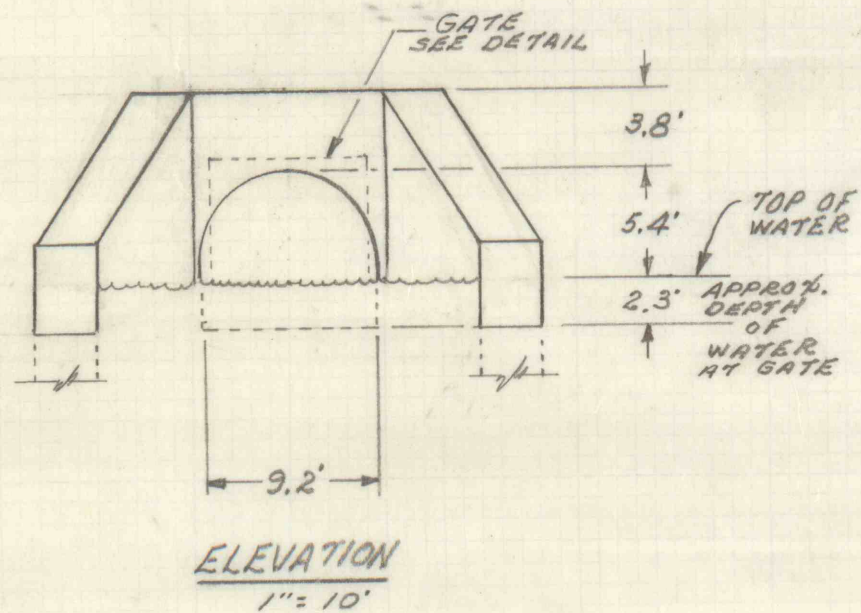

JEDDO MINE DRAINAGE TUNNEL  
DISCHARGE OUTFALL  
LATTIMER COLLIERY  
HAZLE TOWNSHIP  
LUZERNE COUNTY  
DEPT. OF ENVIRONMENTAL RESOURCES  
POTTSVILLE, PA. MARCH 21, 1977