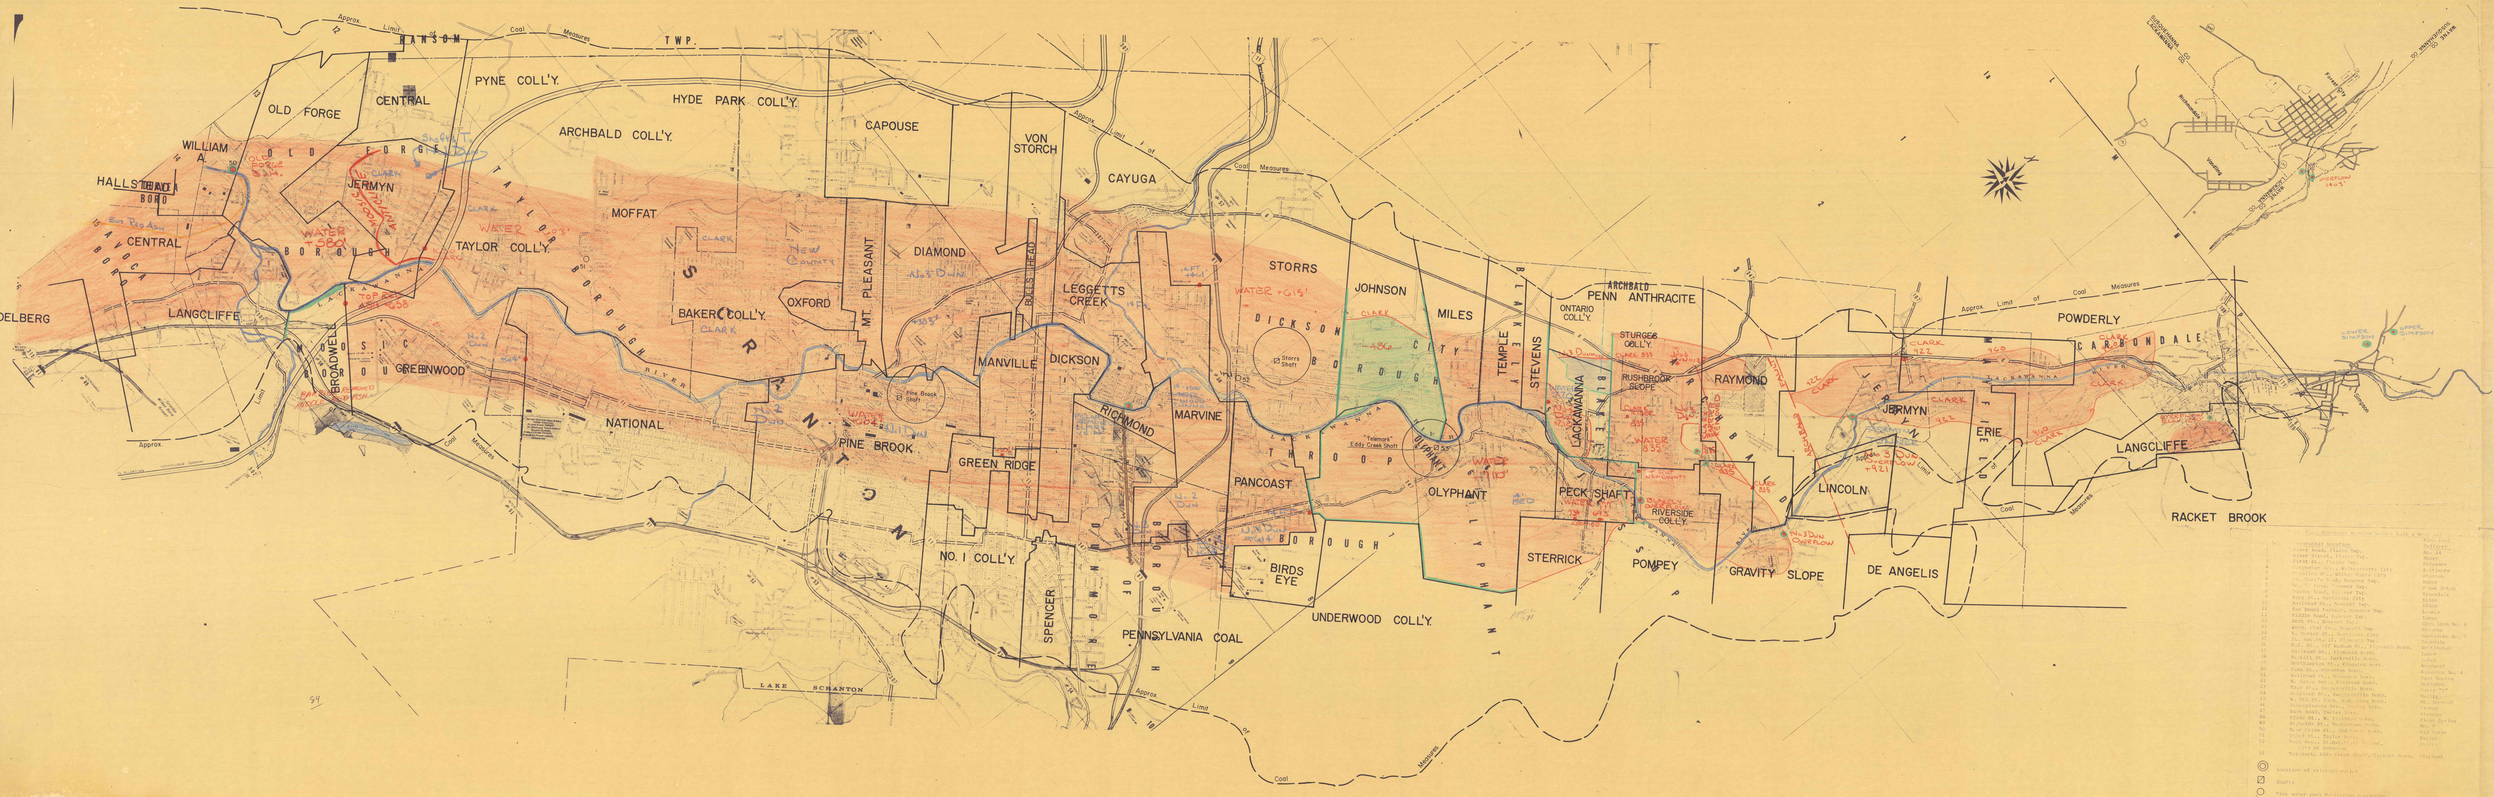
HANSON TWP.
OLD FORGE
CENTRAL
PYNE COLL'Y.
HYDE PARK COLL'Y.
ARCHBALD COLL'Y.
CAPOUSE
VON STORCH
CAYUGA
WILLIAM A.
HALLSTEAD BORO
JERMYN
MOFFAT
TAYLOR COLL'Y.
TAYLOR BOROUGH
DIAMOND
MT. PLEASANT
OXFORD
BAKER COLL'Y.
LEGGETTS CREEK
STORRS
JOHNSON
MILES
TEMPLE
STEVENS
ARCHBALD PENN ANTHRACITE
ONTARIO COLL'Y.
STURGES COLL'Y.
RUSHBROOK SLOPE
RAYMOND
POWDERLY
CARBONDALE
HEIDELBERG
LANGCLIFFE
CENTRAL
HAVOCA BORO
BROADWELL
MOOSIC
GREENWOOD
NATIONAL
PINE BROOK
MANVILLE
DICKSON
RICHMOND
MARVINE
GREEN RIDGE
PANCOAST
OLYPHANT
DICKSON CITY BOROUGH
BLAKELY
LACKAWANNA
PECK SHAFT
RIVERSIDE COLL'Y.
STERRICK
POMPEY
GRAVITY SLOPE
LINCOLN
DE ANGELIS
JERMYN
ERIE
LANGCLIFFE
RACKET BROOK
NO. 1 COLL'Y.
SPENCER
BIRDS EYE
UNDERWOOD COLL'Y.
PENNSYLVANIA COAL
LAKE SCRANTON
SCRANTON
LACKAWANNA RIVER
Approx. Limit of Coal Measures