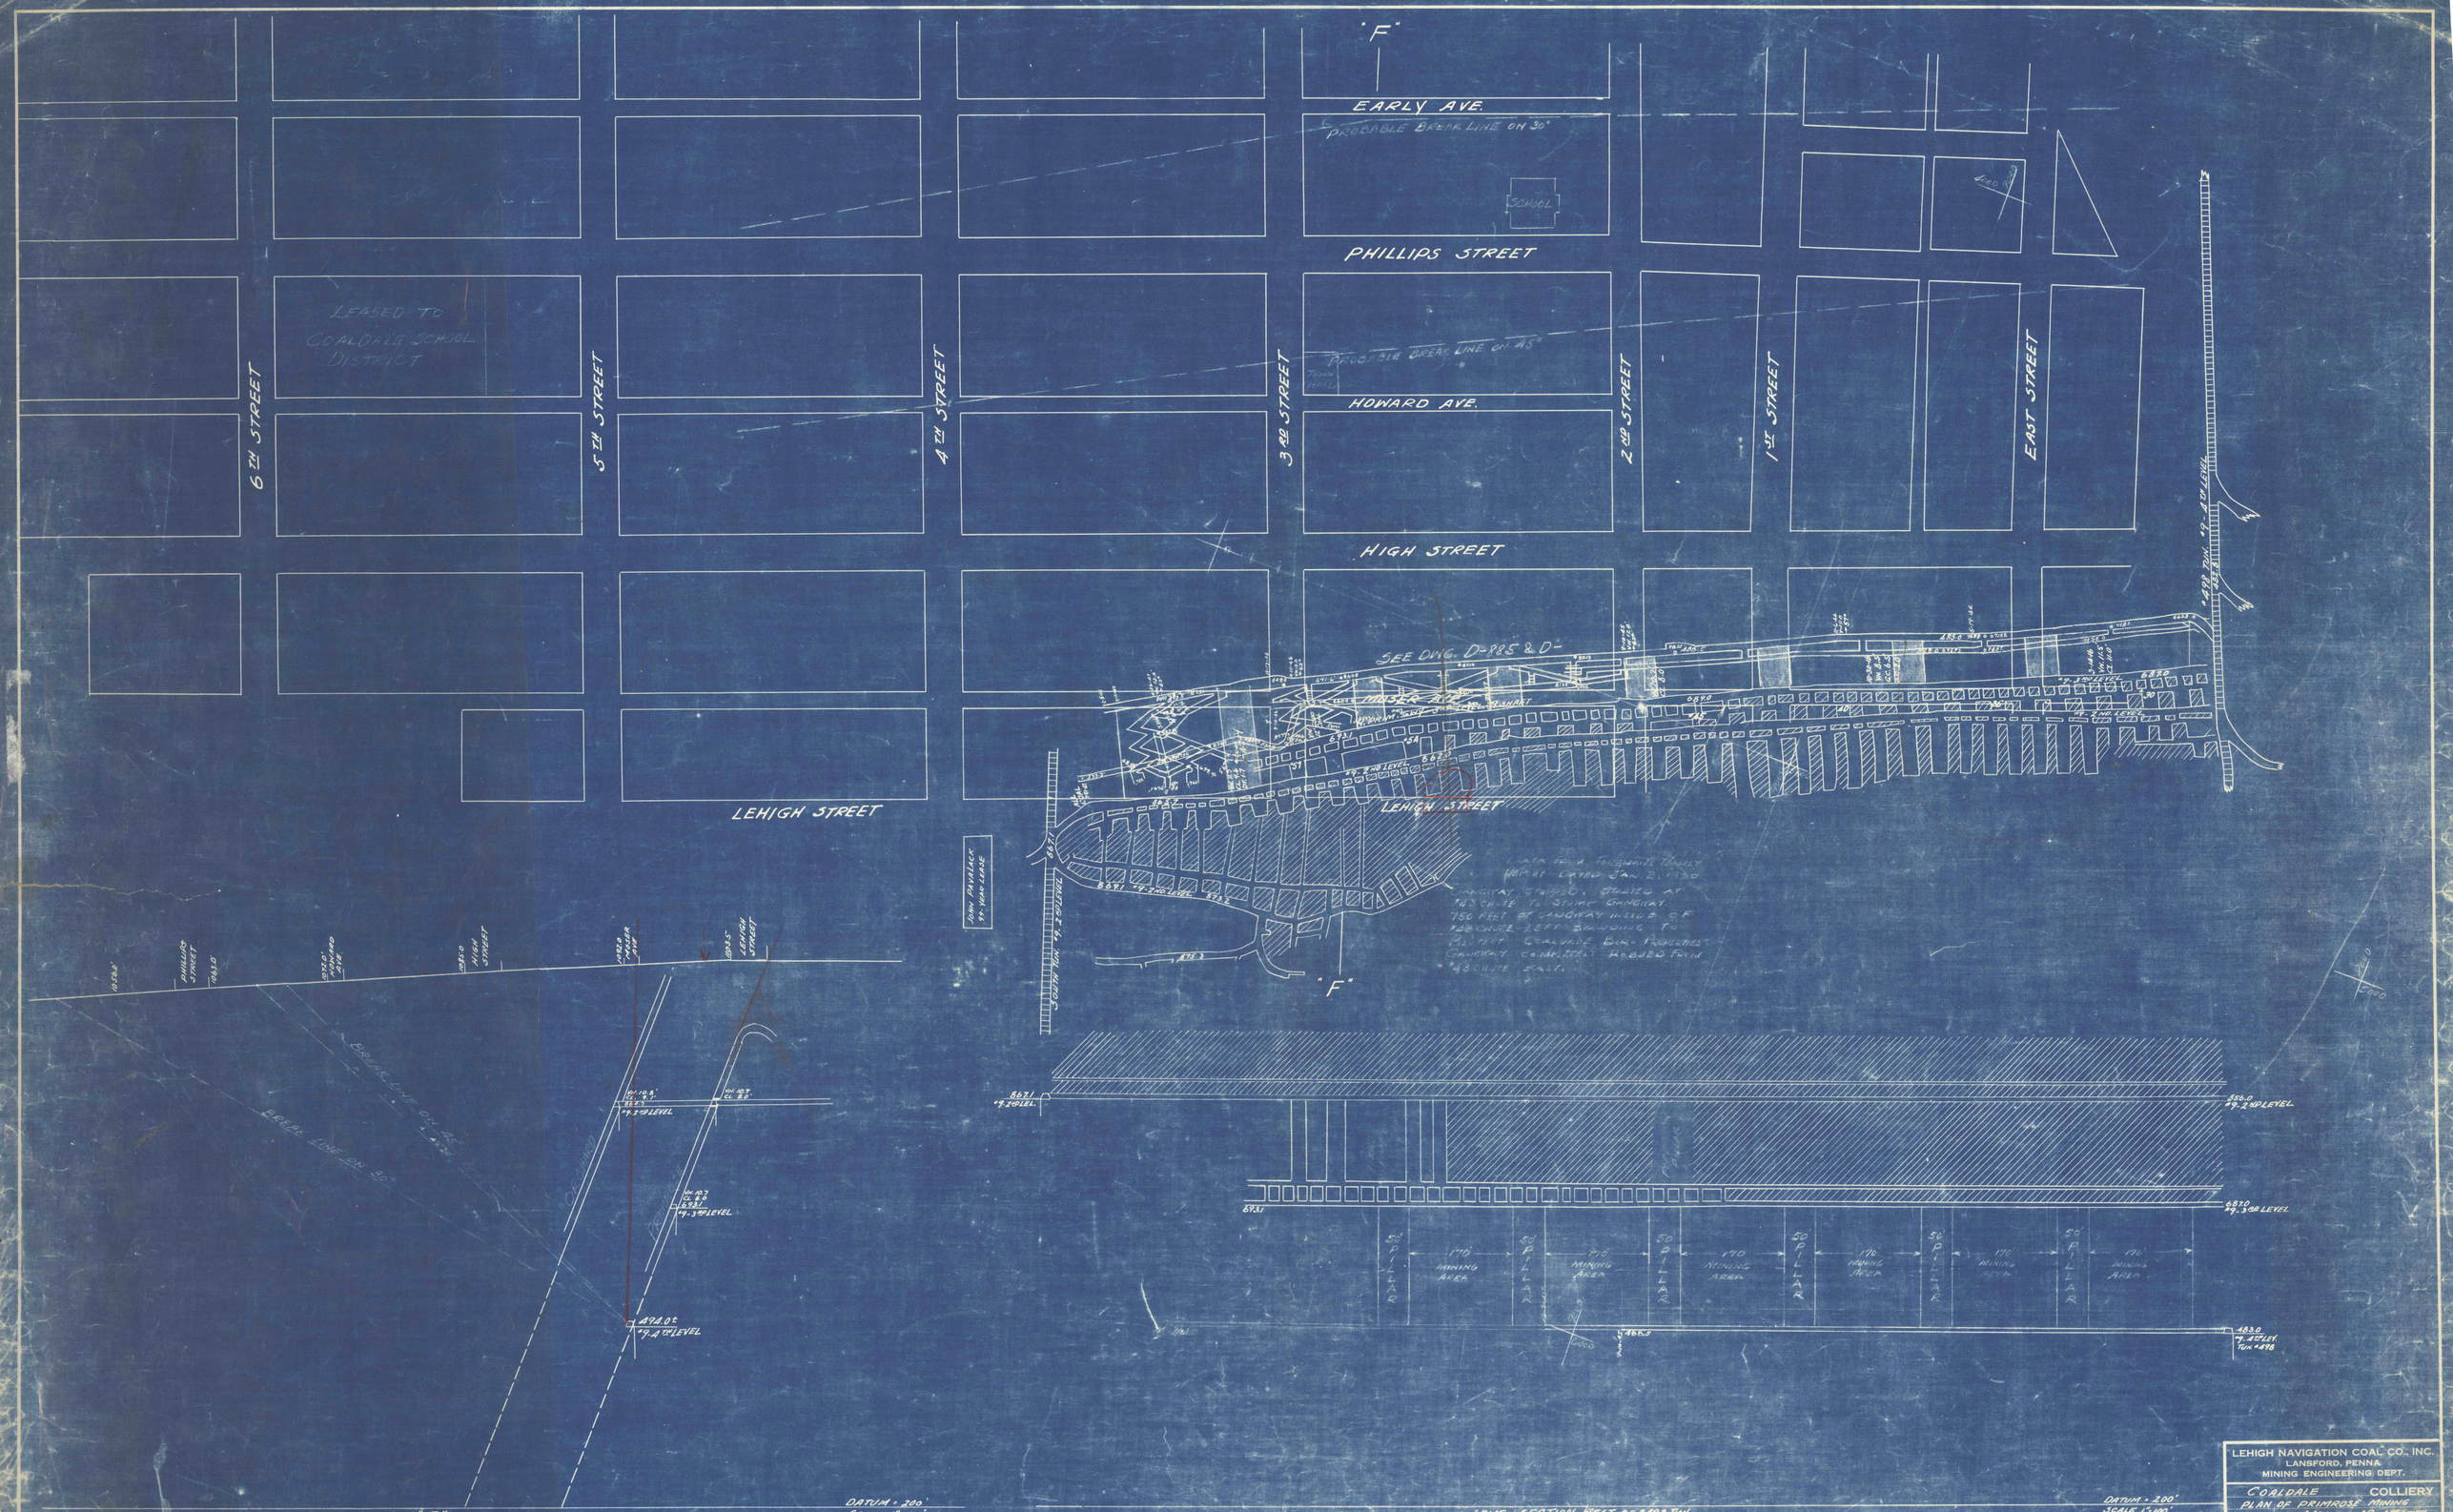

LEHIGH NAVIGATION COAL CO., INC.
LANSFORD, PENNA.
MINING ENGINEERING DEPT.

COALDALE COLLIERY
PLAN OF PRIMROSE MINING
WEST OFF "498 TUN. 19.4 LEVEL

SCALE 1" = 100' DATE 4-12-43
MADE BY D.R.S. TRACED BY CHECKED BY
REVISED
APPROVED
MIN. ENGR.
DIST. SUPR.
V.P. & GEN. MGR.

G 47