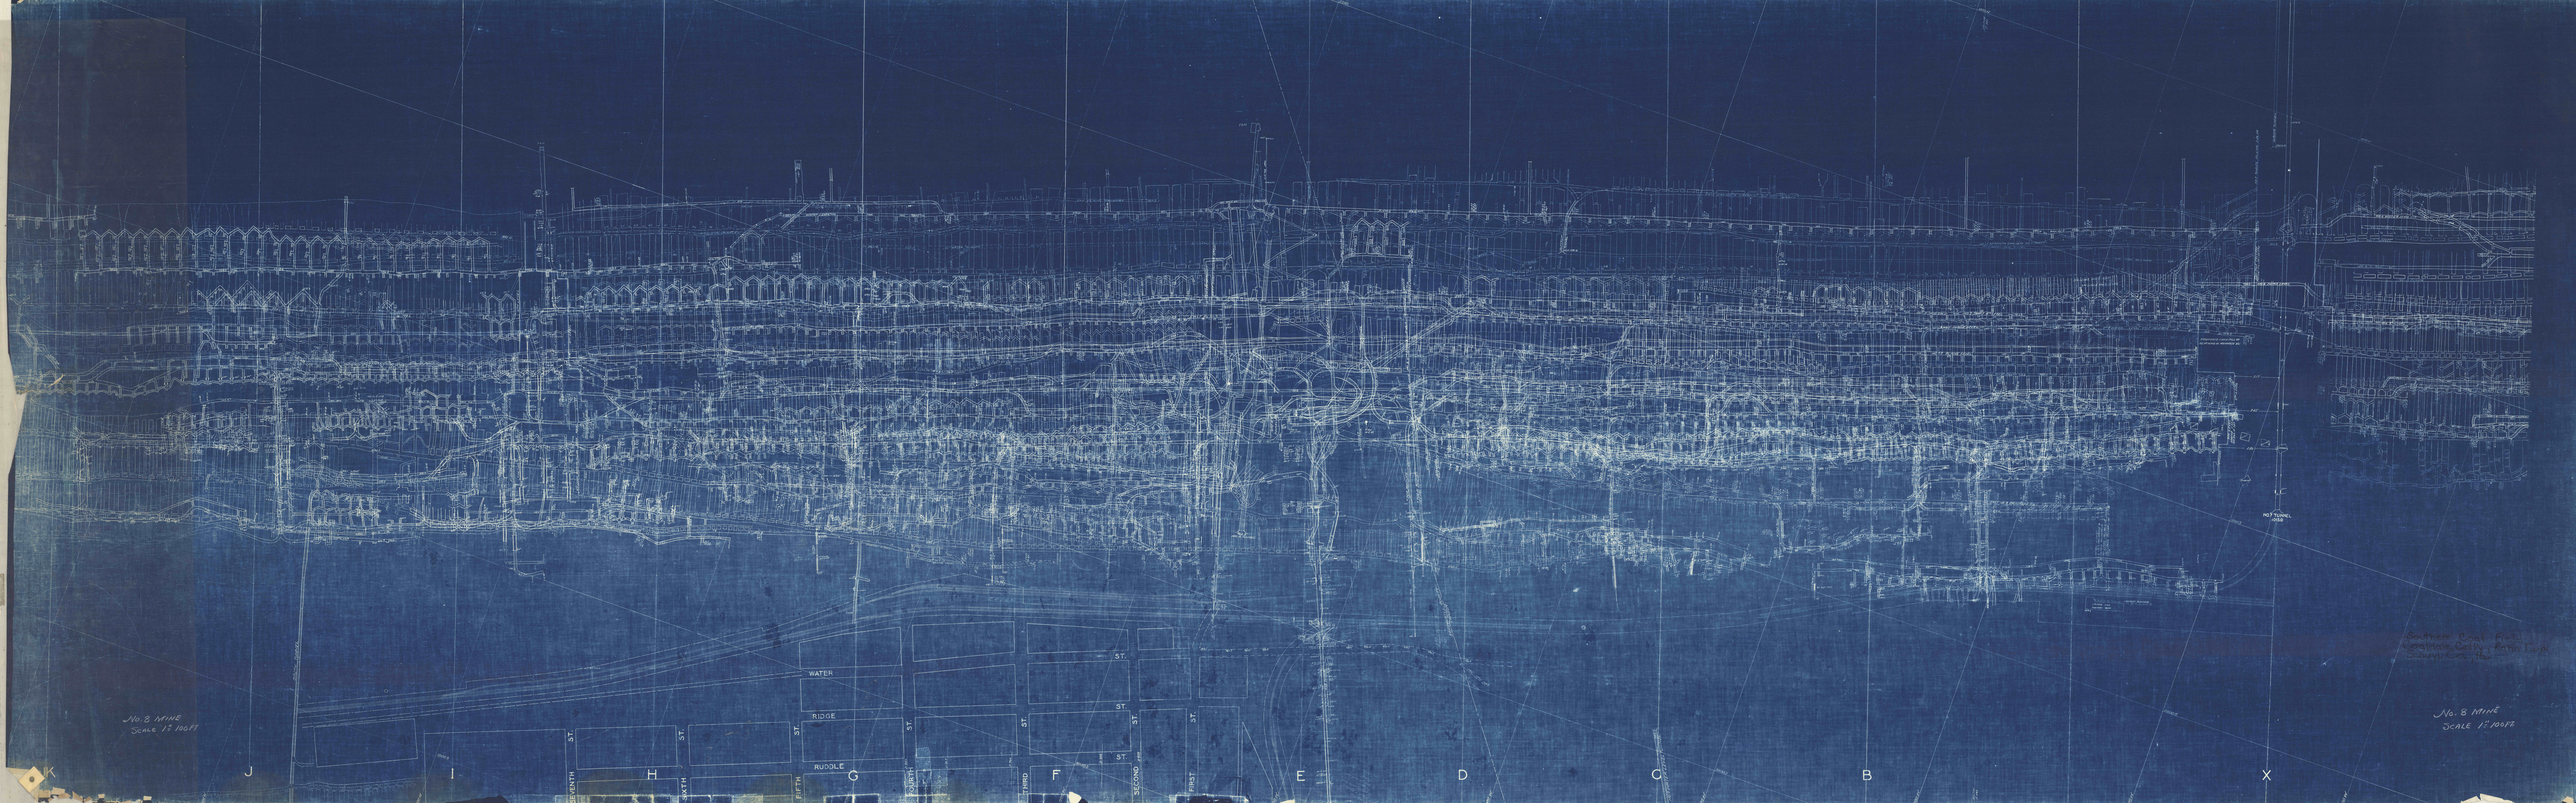
WATER
RIDGE
RUDDLE
ST.
SEVENTH
SIXTH
FIFTH
FOURTH
THIRD
SECOND
FIRST
K
J
I
H
G
F
E
D
C
B
X
No. 8 MINE
SCALE 1" 100FT
No. 8 MINE
SCALE 1" 100FT