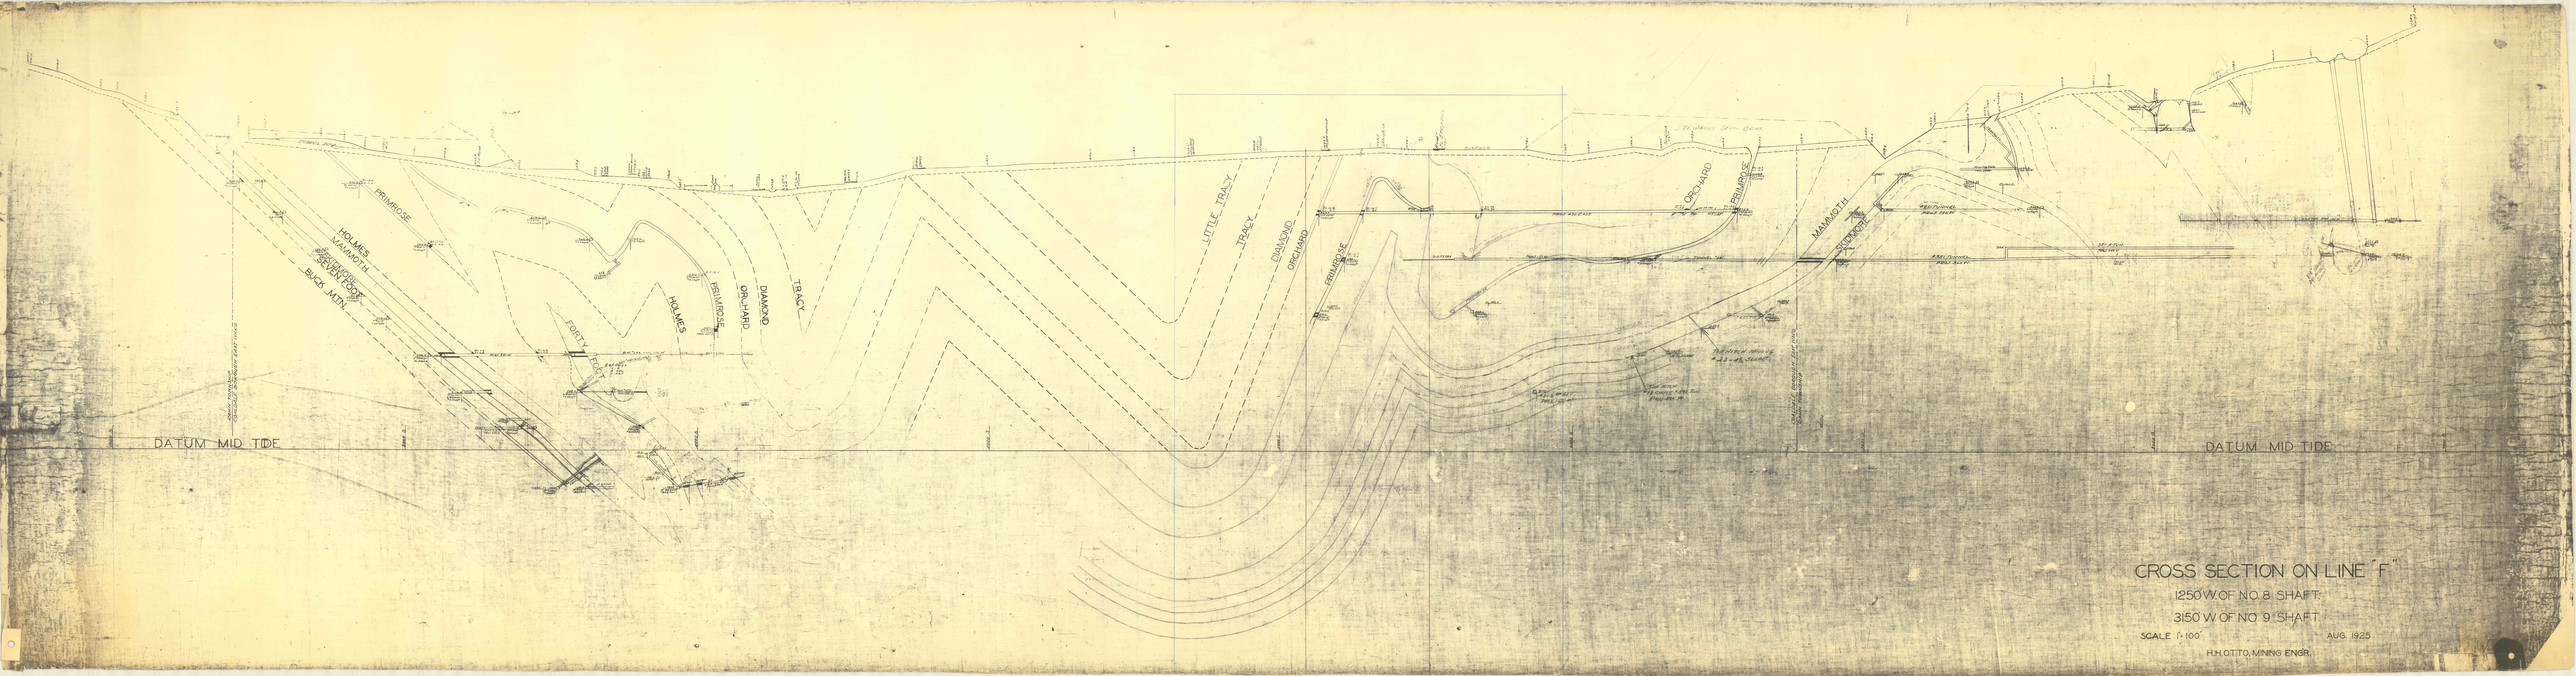
DATUM MID TIDE
DATUM MID TIDE
PRIMROSE
HOLMES
MAMMOTH
SILVER FOOT
BUCK MTN.
HOLMES
PRIMROSE
ORCHARD
DIAMOND
TRACY
FORTY FOOT
LITTLE TRACY
TRACY
DIAMOND
ORCHARD
PRIMROSE
ORCHARD
PRIMROSE
MAMMOTH
SILVER FOOT
CROSS SECTION ON LINE "F"
1250' W. OF NO. 8 SHAFT
3150' W. OF NO. 9 SHAFT
SCALE 1" = 100'
AUG. 1925
H.H. OTTO, MINING ENGR.