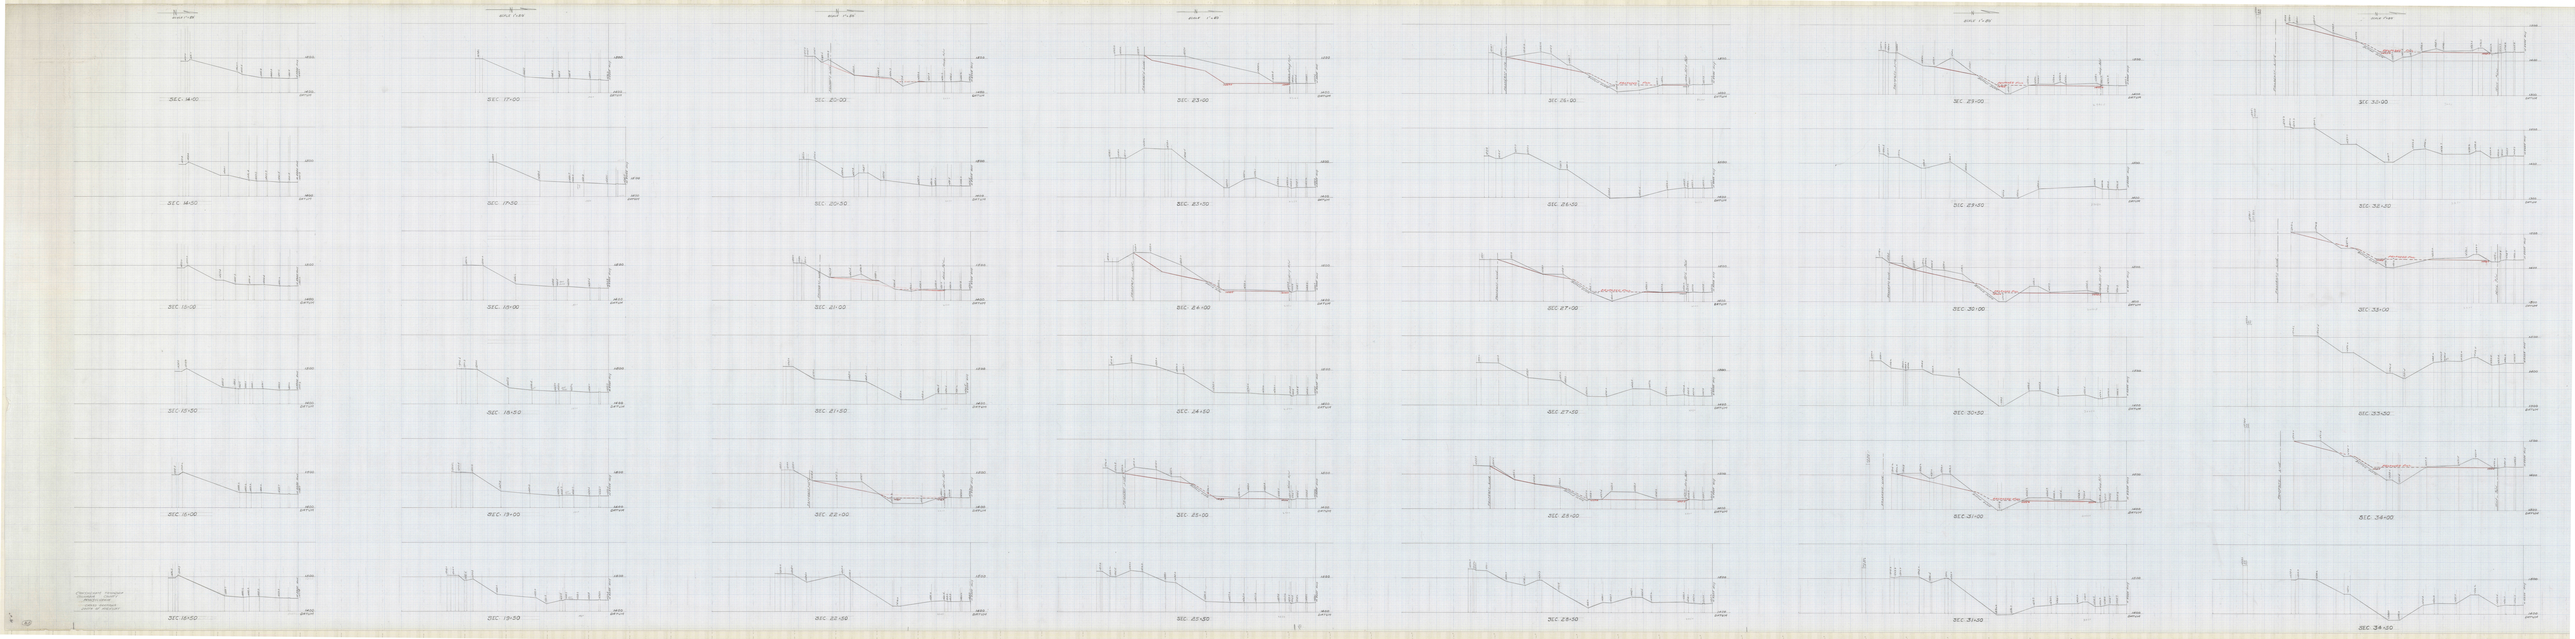
SEC. 14+00
SEC. 14+50
SEC. 15+00
SEC. 15+50
SEC. 16+00
SEC. 16+50
SEC. 17+00
SEC. 17+50
SEC. 18+00
SEC. 18+50
SEC. 19+00
SEC. 19+50
SEC. 20+00
SEC. 20+50
SEC. 21+00
SEC. 21+50
SEC. 22+00
SEC. 22+50
SEC. 23+00
SEC. 23+50
SEC. 24+00
SEC. 24+50
SEC. 25+00
SEC. 25+50
SEC. 26+00
SEC. 26+50
SEC. 27+00
SEC. 27+50
SEC. 28+00
SEC. 28+50
SEC. 29+00
SEC. 29+50
SEC. 30+00
SEC. 30+50
SEC. 31+00
SEC. 31+50
SEC. 32+00
SEC. 32+50
SEC. 33+00
SEC. 33+50
SEC. 34+00
SEC. 34+50