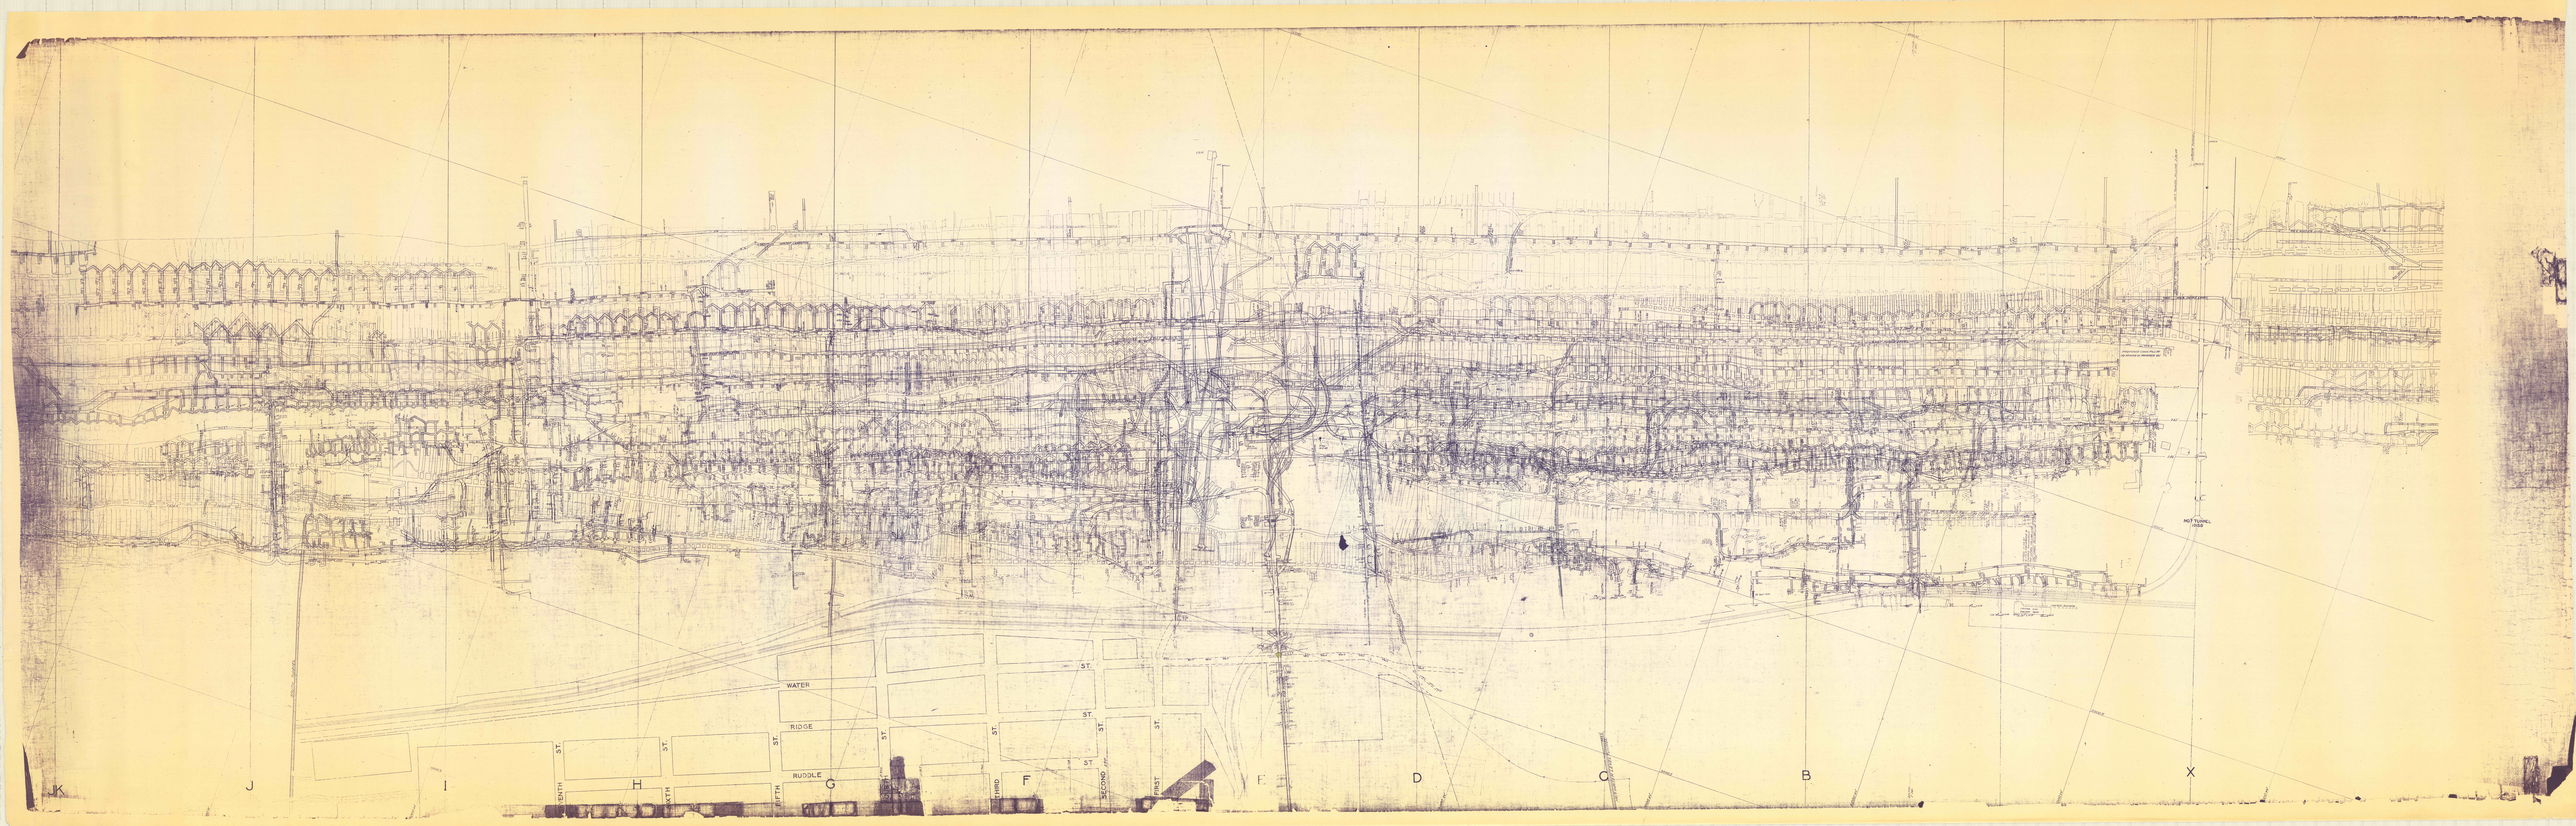

WATER
RIDGE
RUDDLE
ST.
SIXTH
FIFTH
THIRD
SECOND
FIRST
K
J
I
H
G
F
E
D
C
B
X
NO TUNNEL 1930