
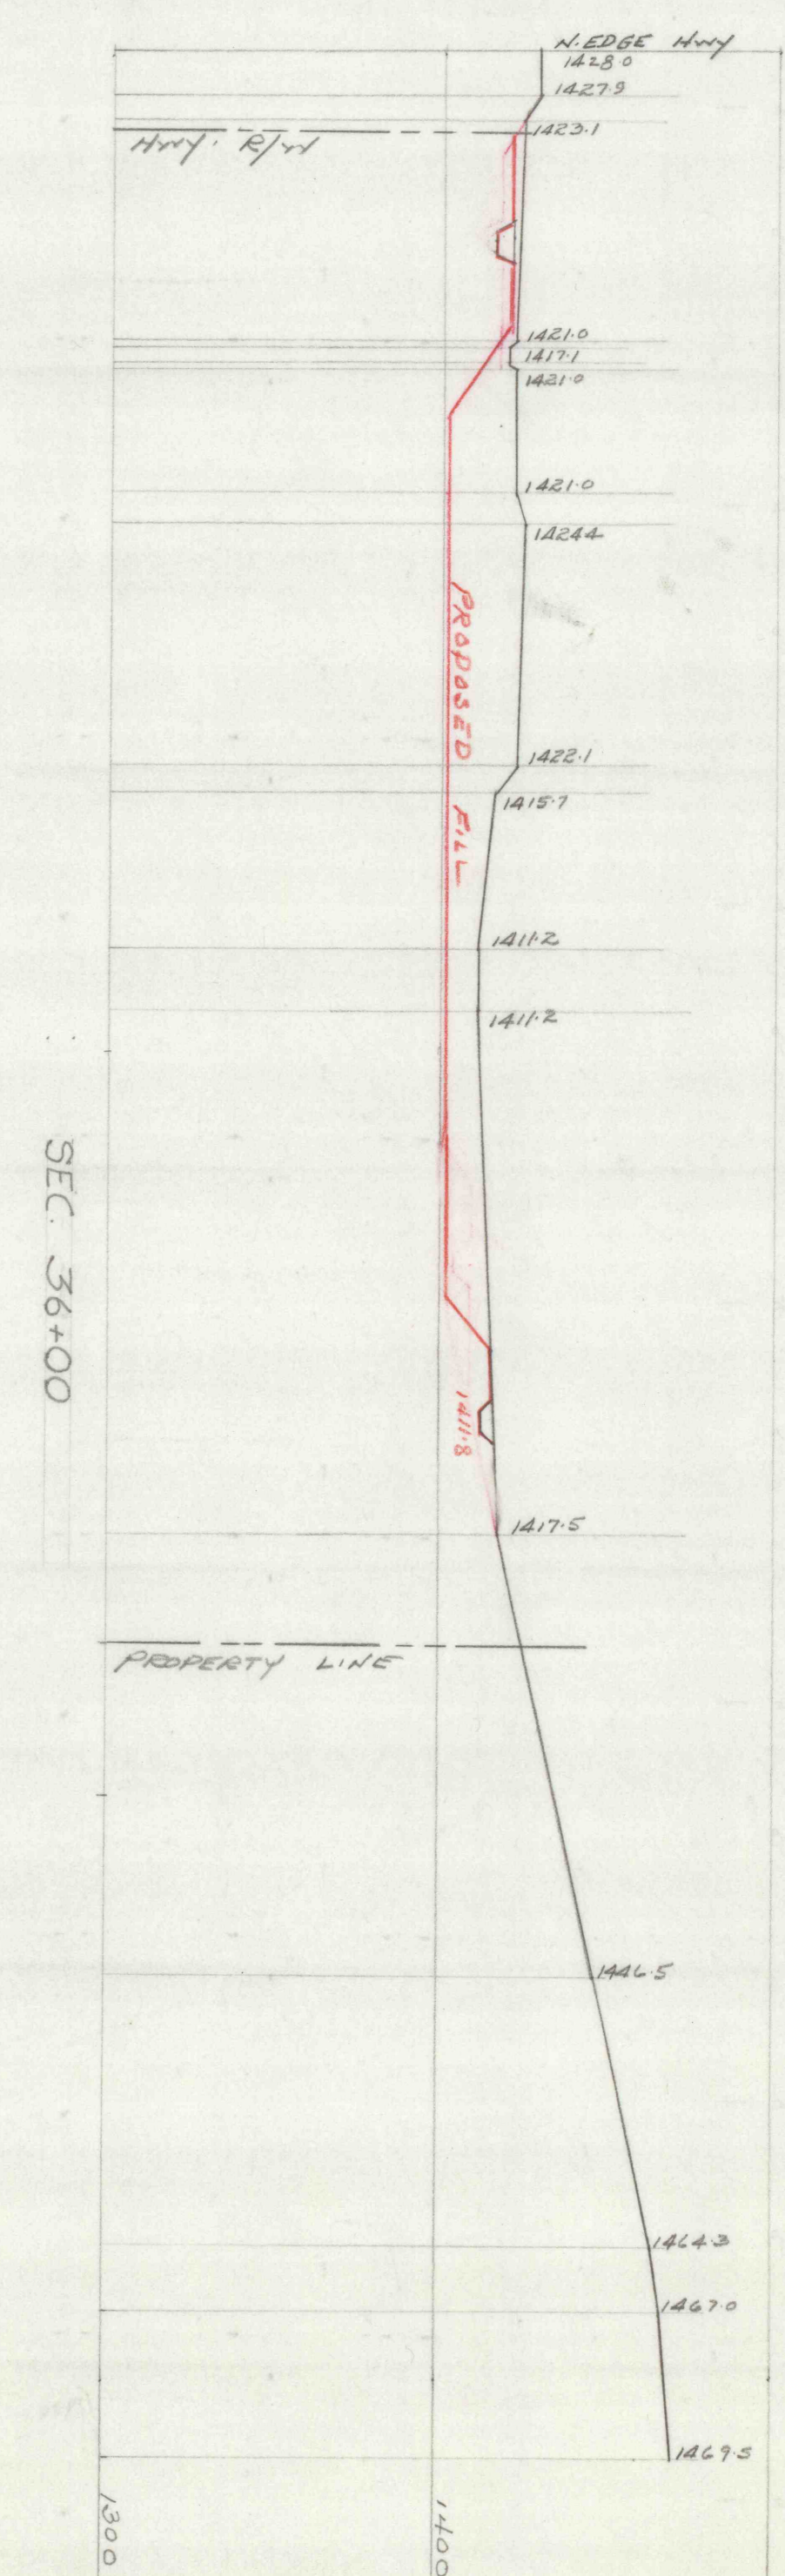
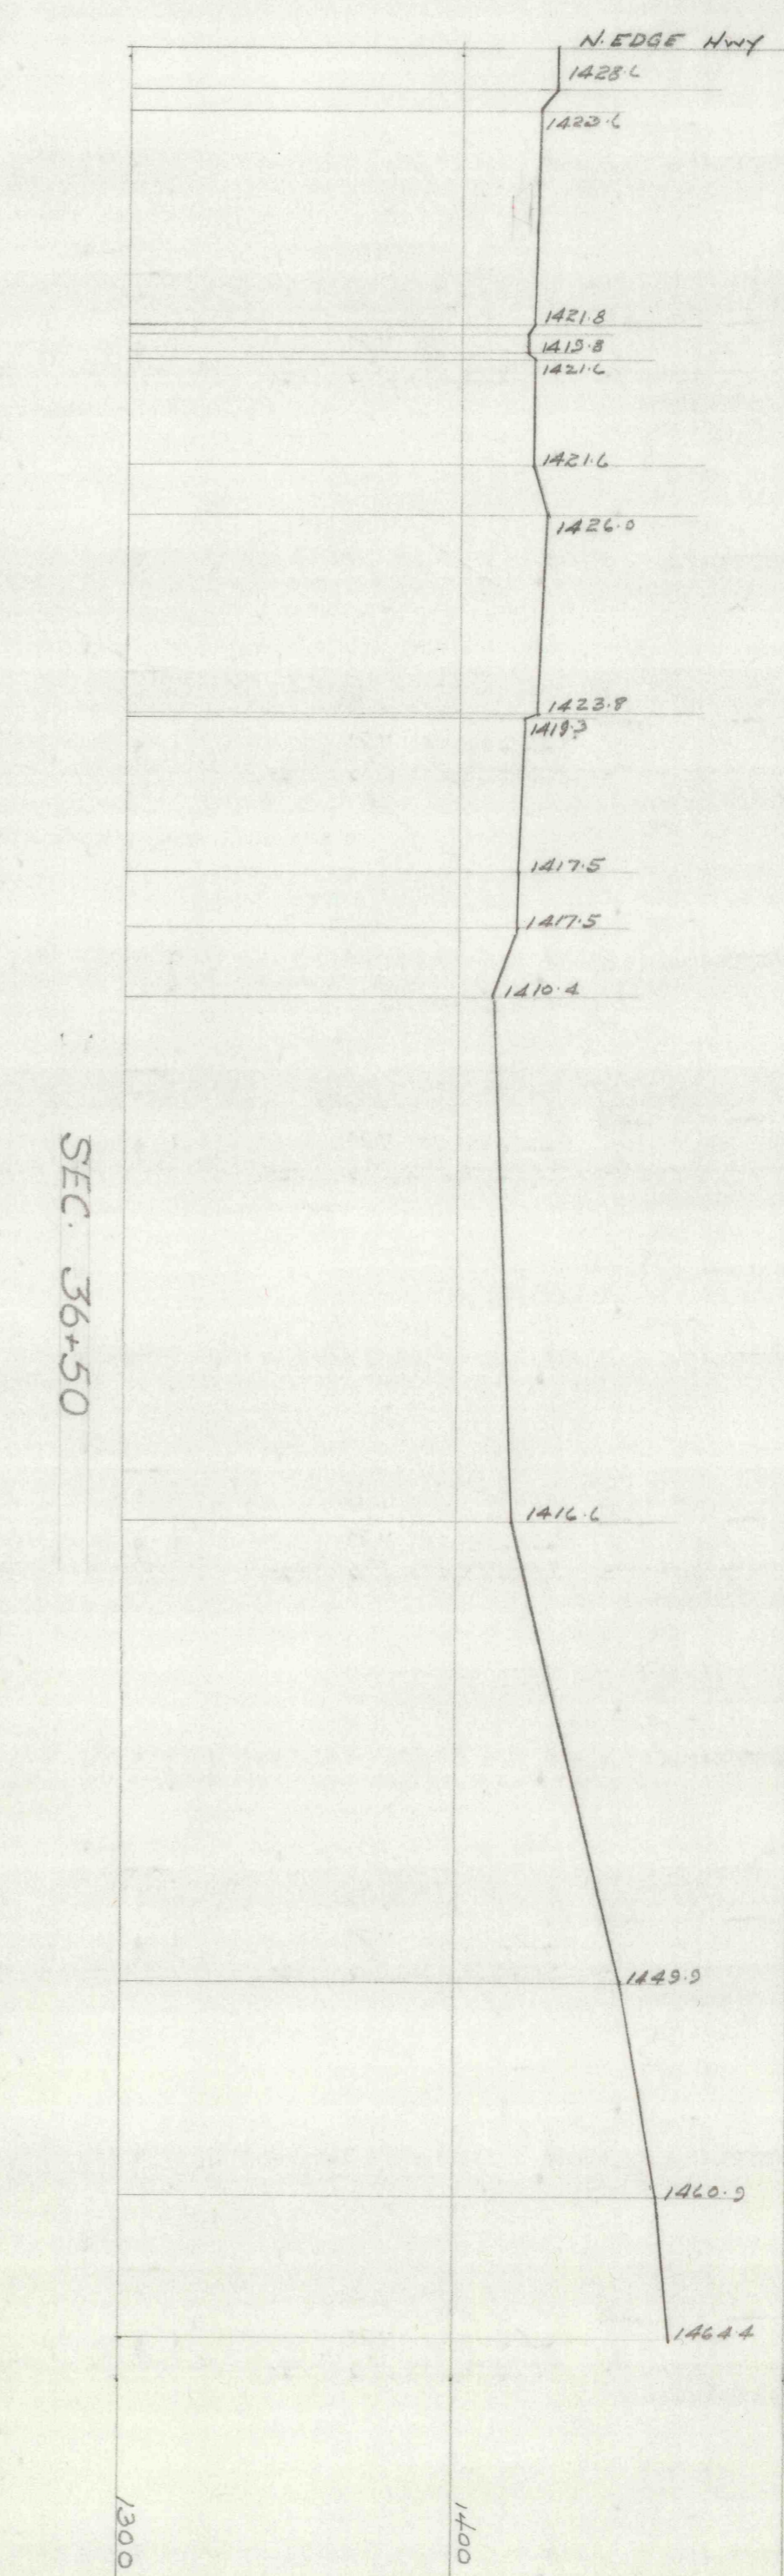
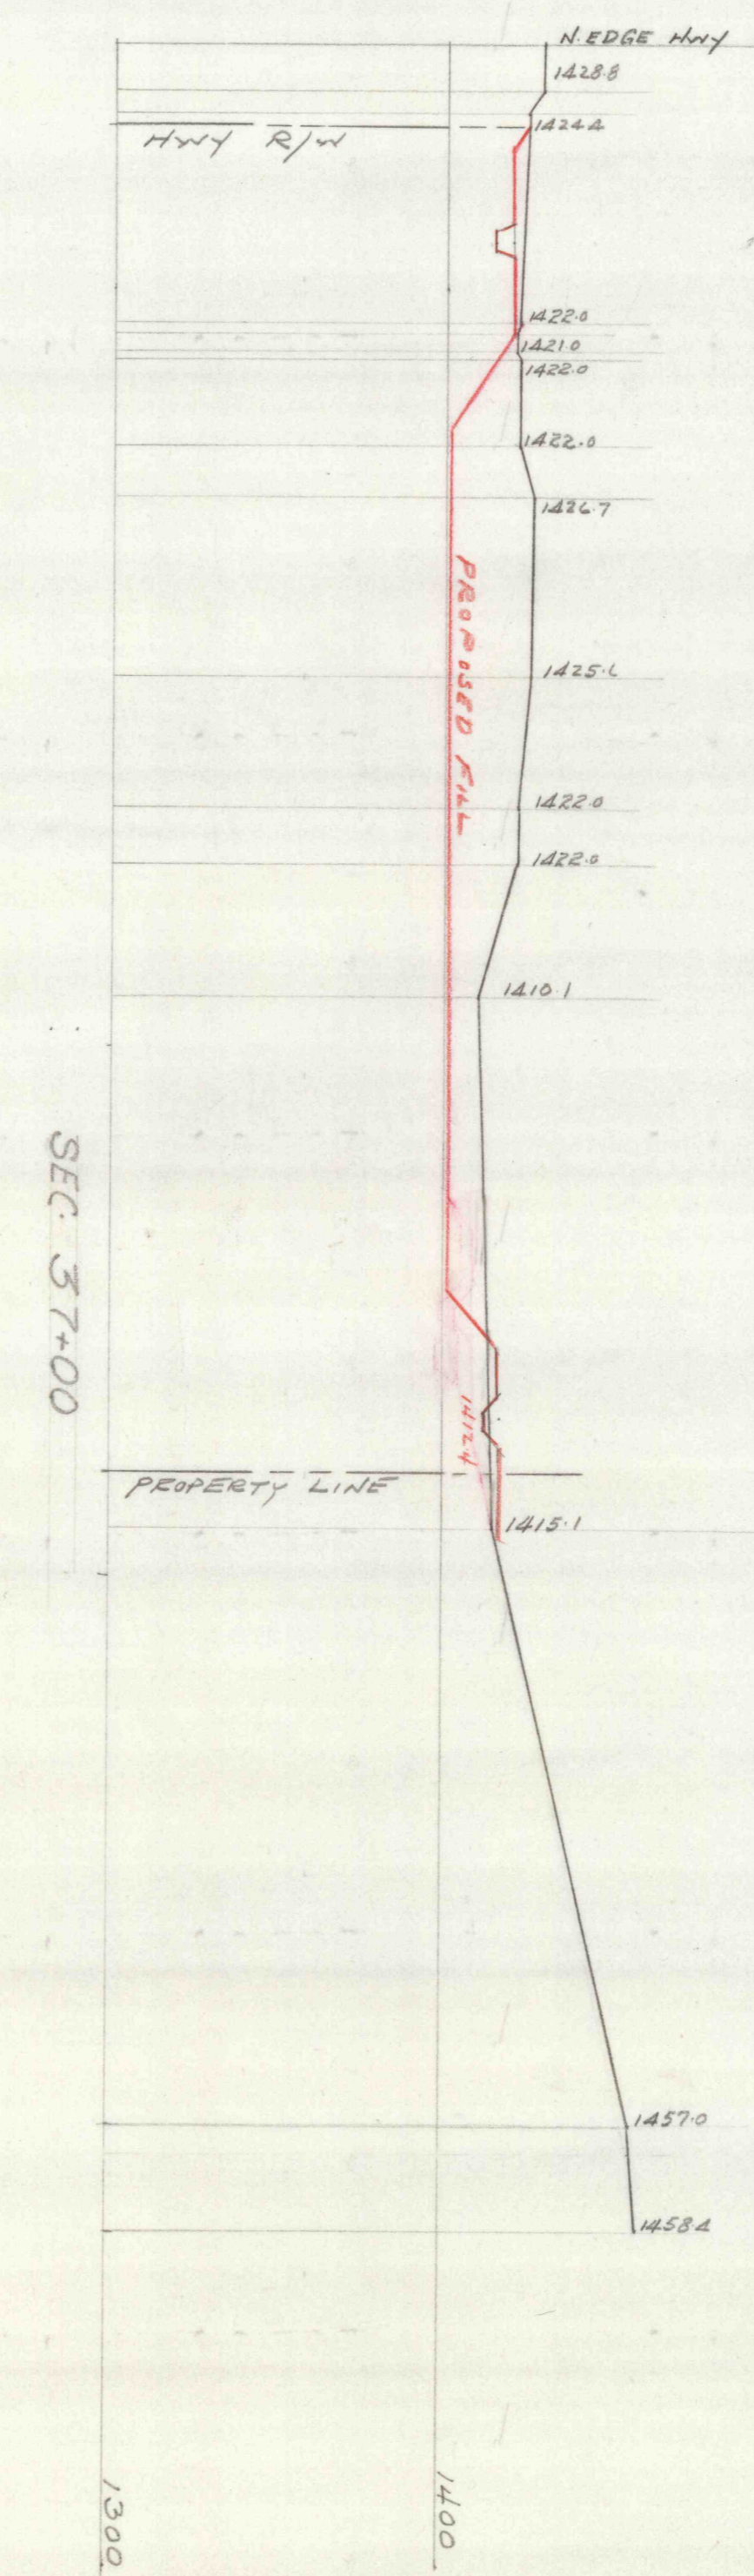
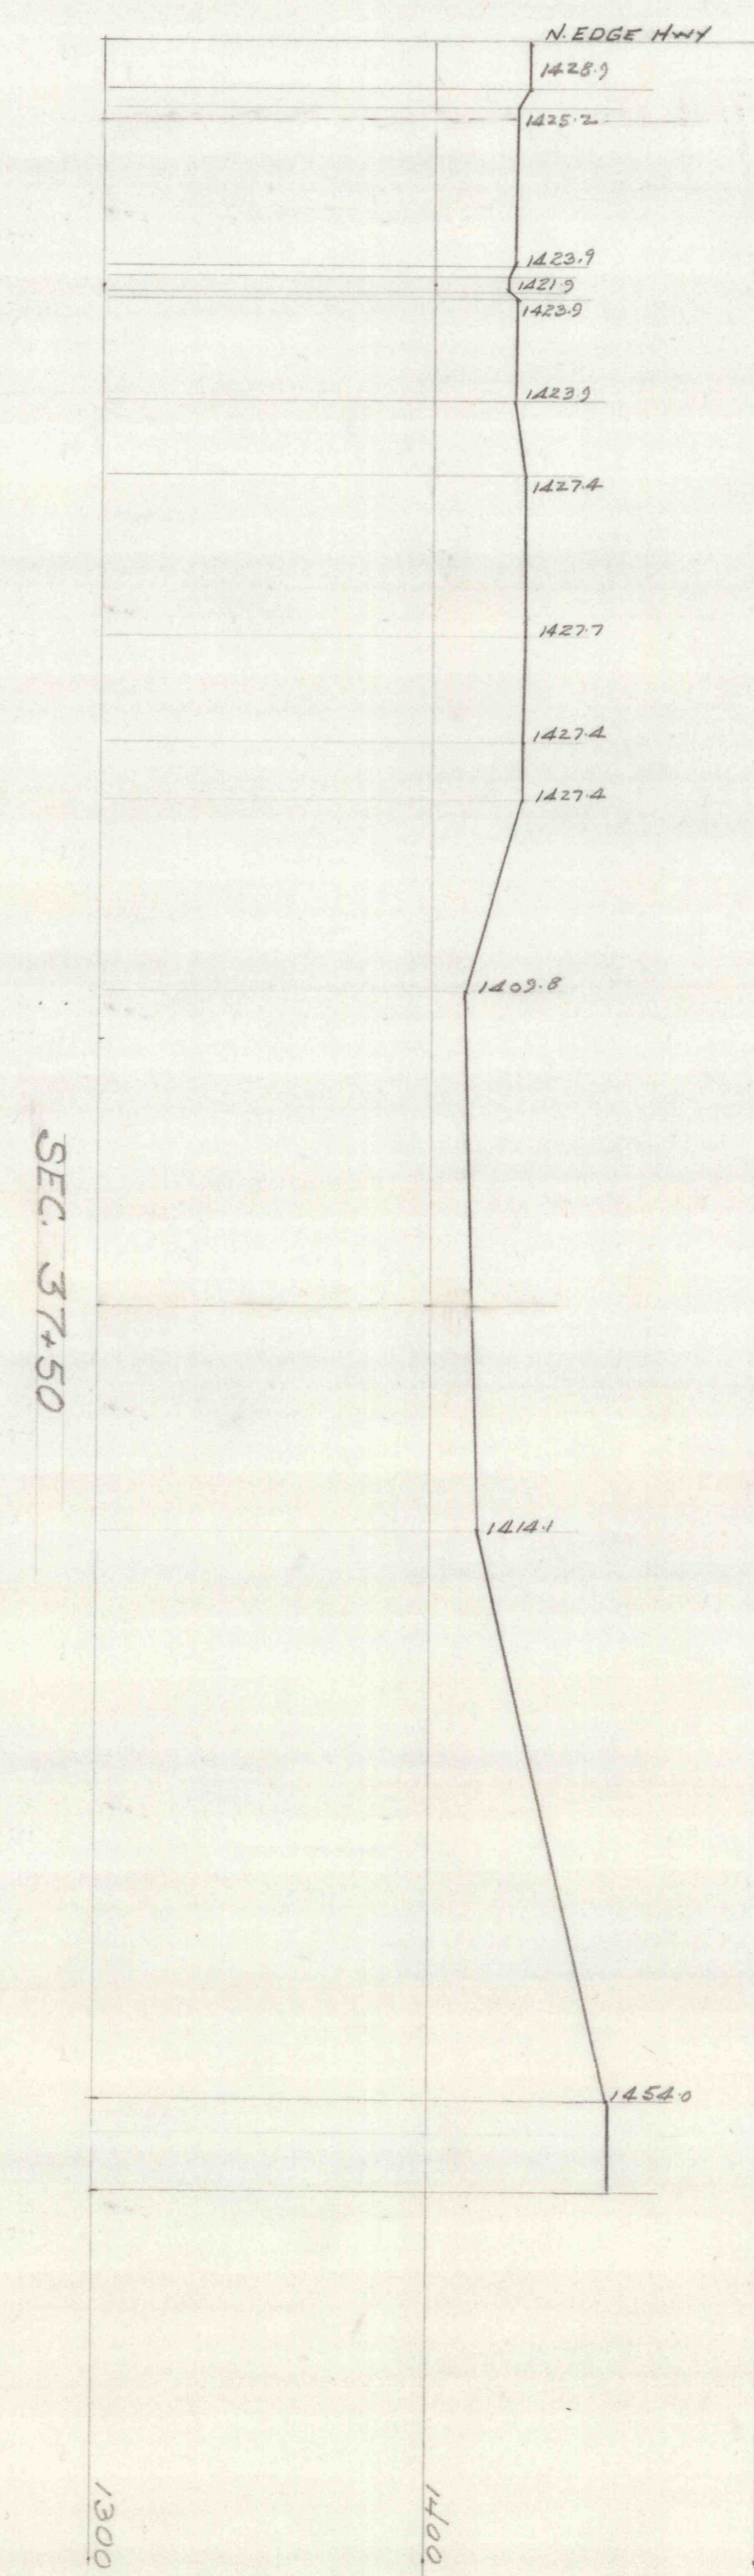
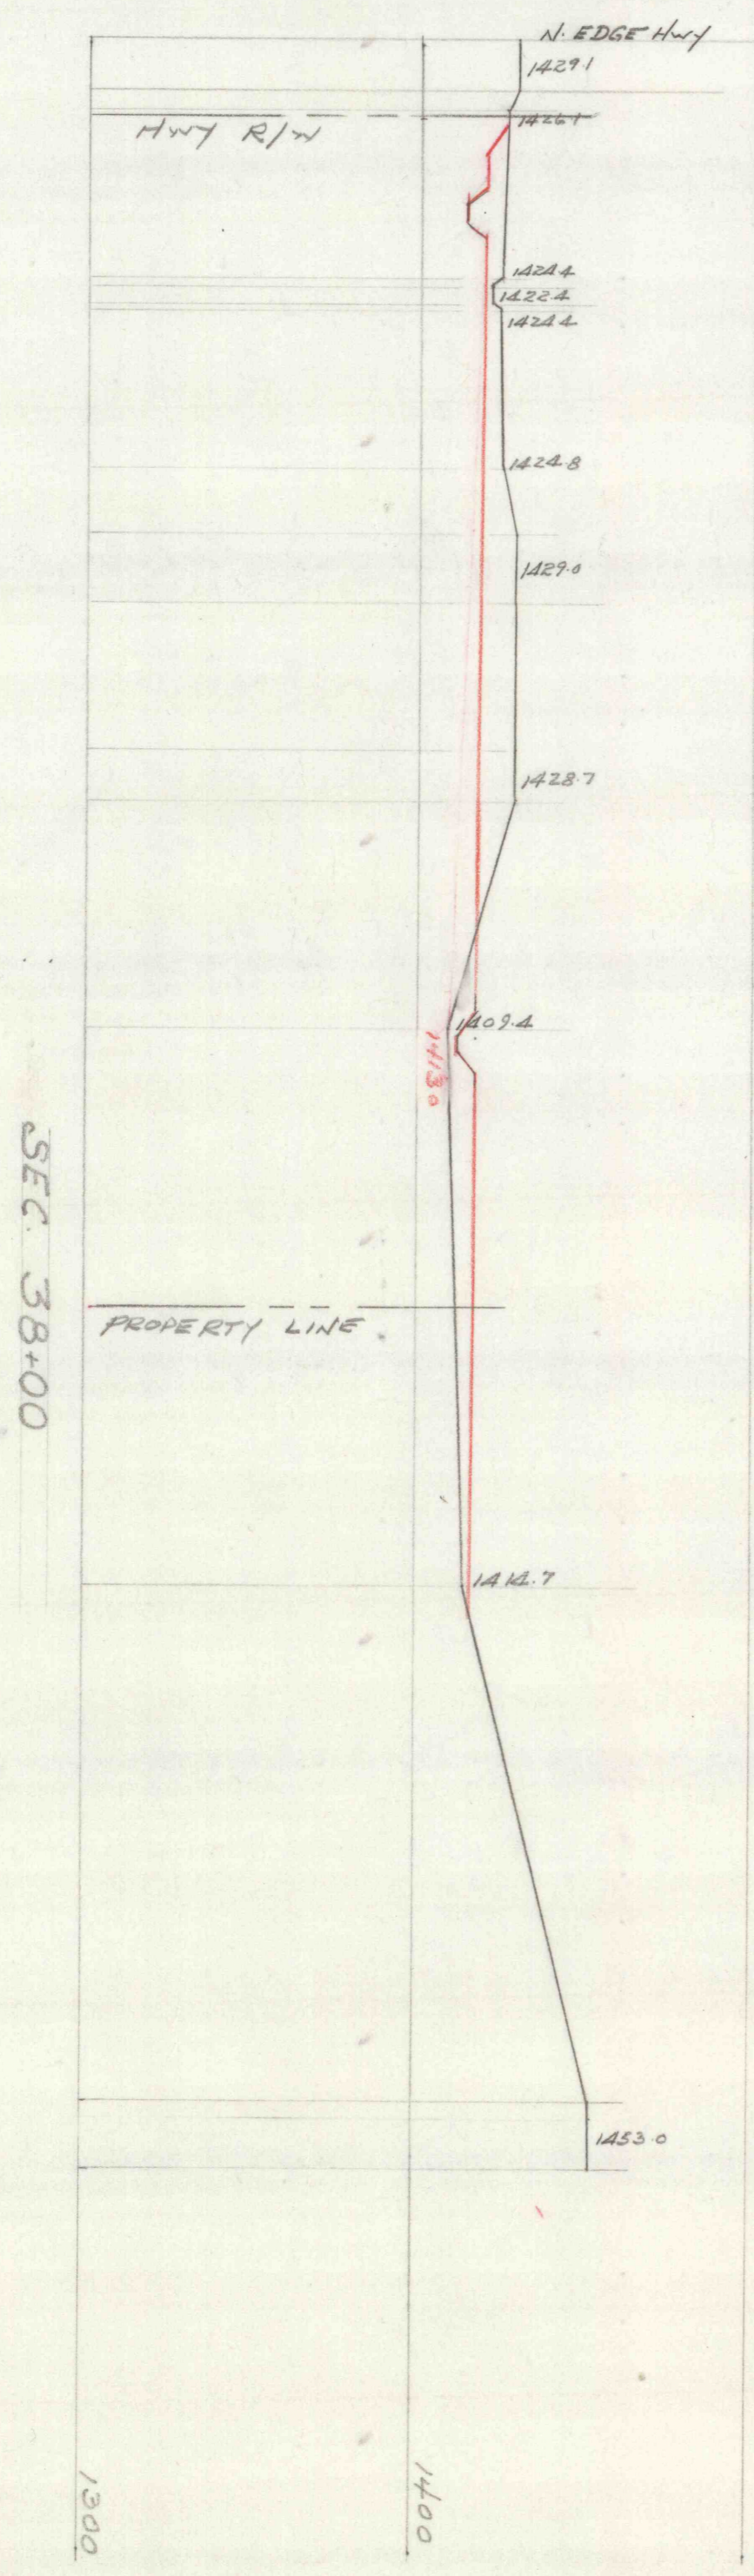


CANTONBURN TOWNSHIP
COLUMBIA COUNTY
PENNSYLVANIA
CROSS SECTIONS
NORTH OF HIGHWAY

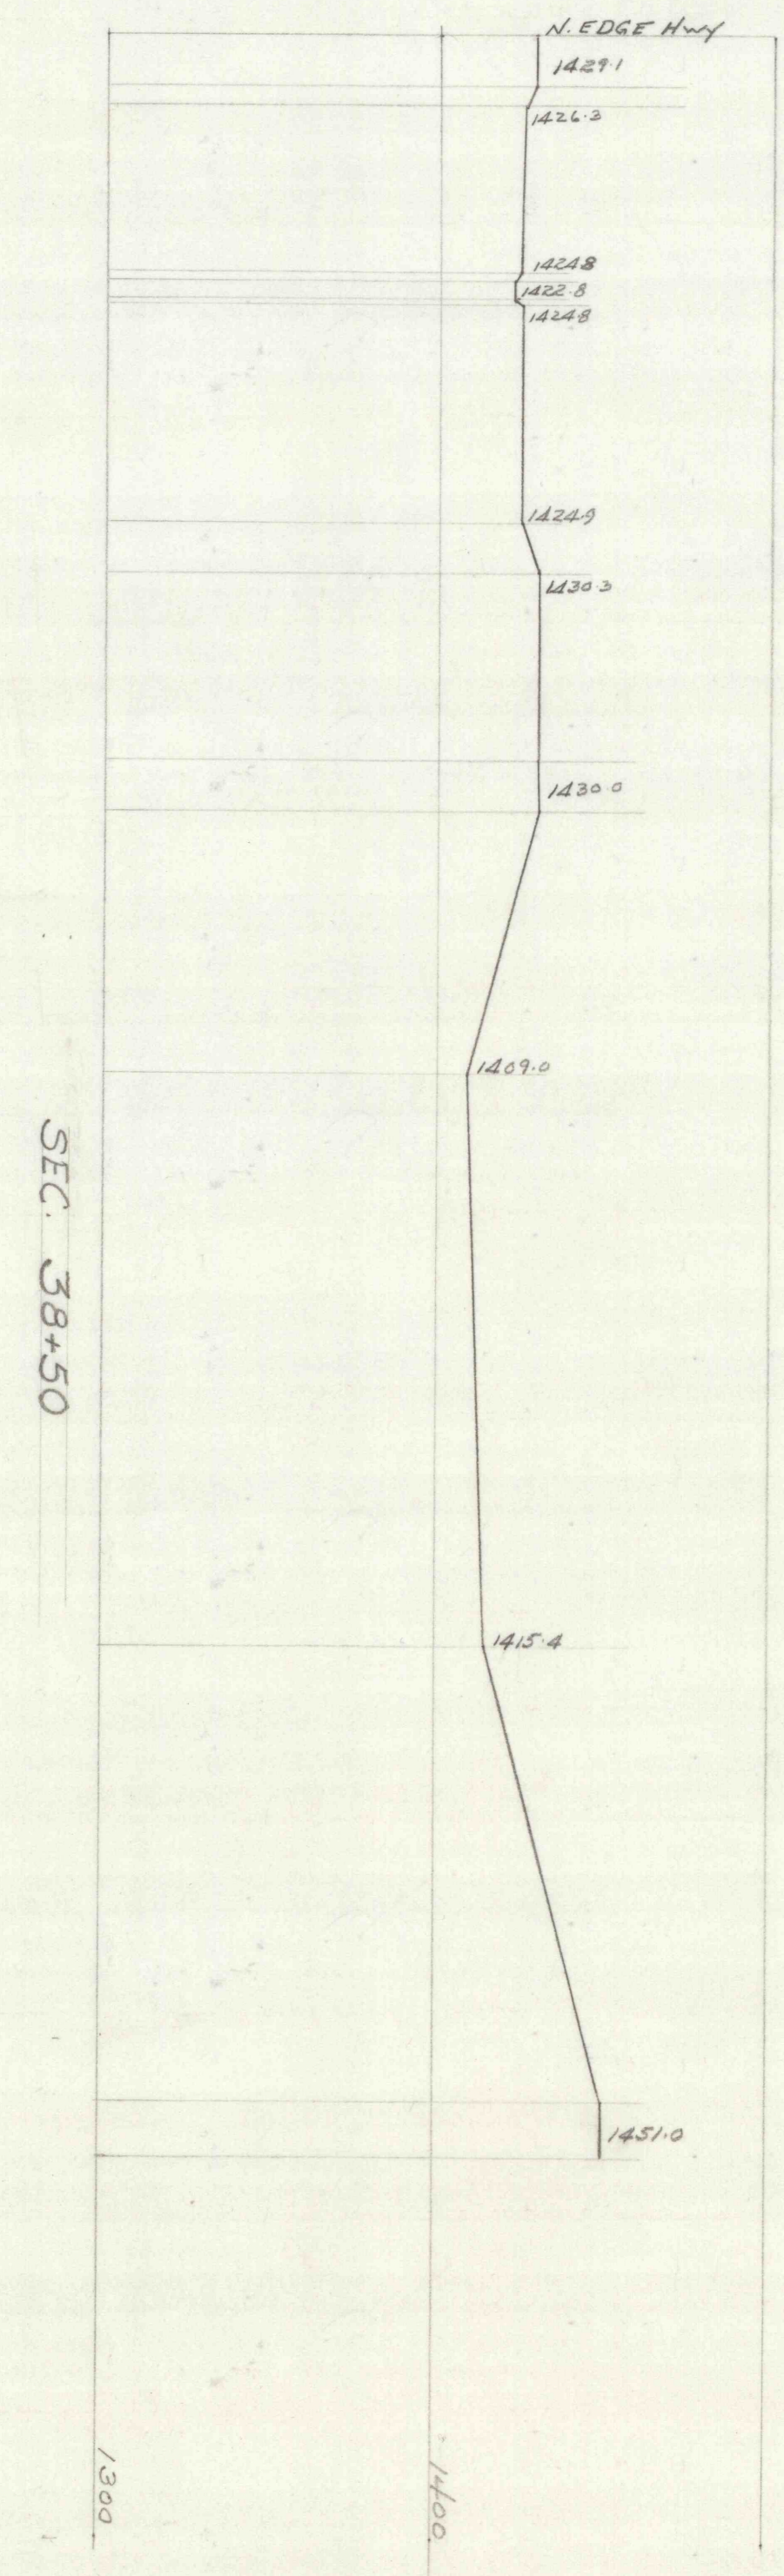

SCALE 1"=50'