




SCALE 1"=50'

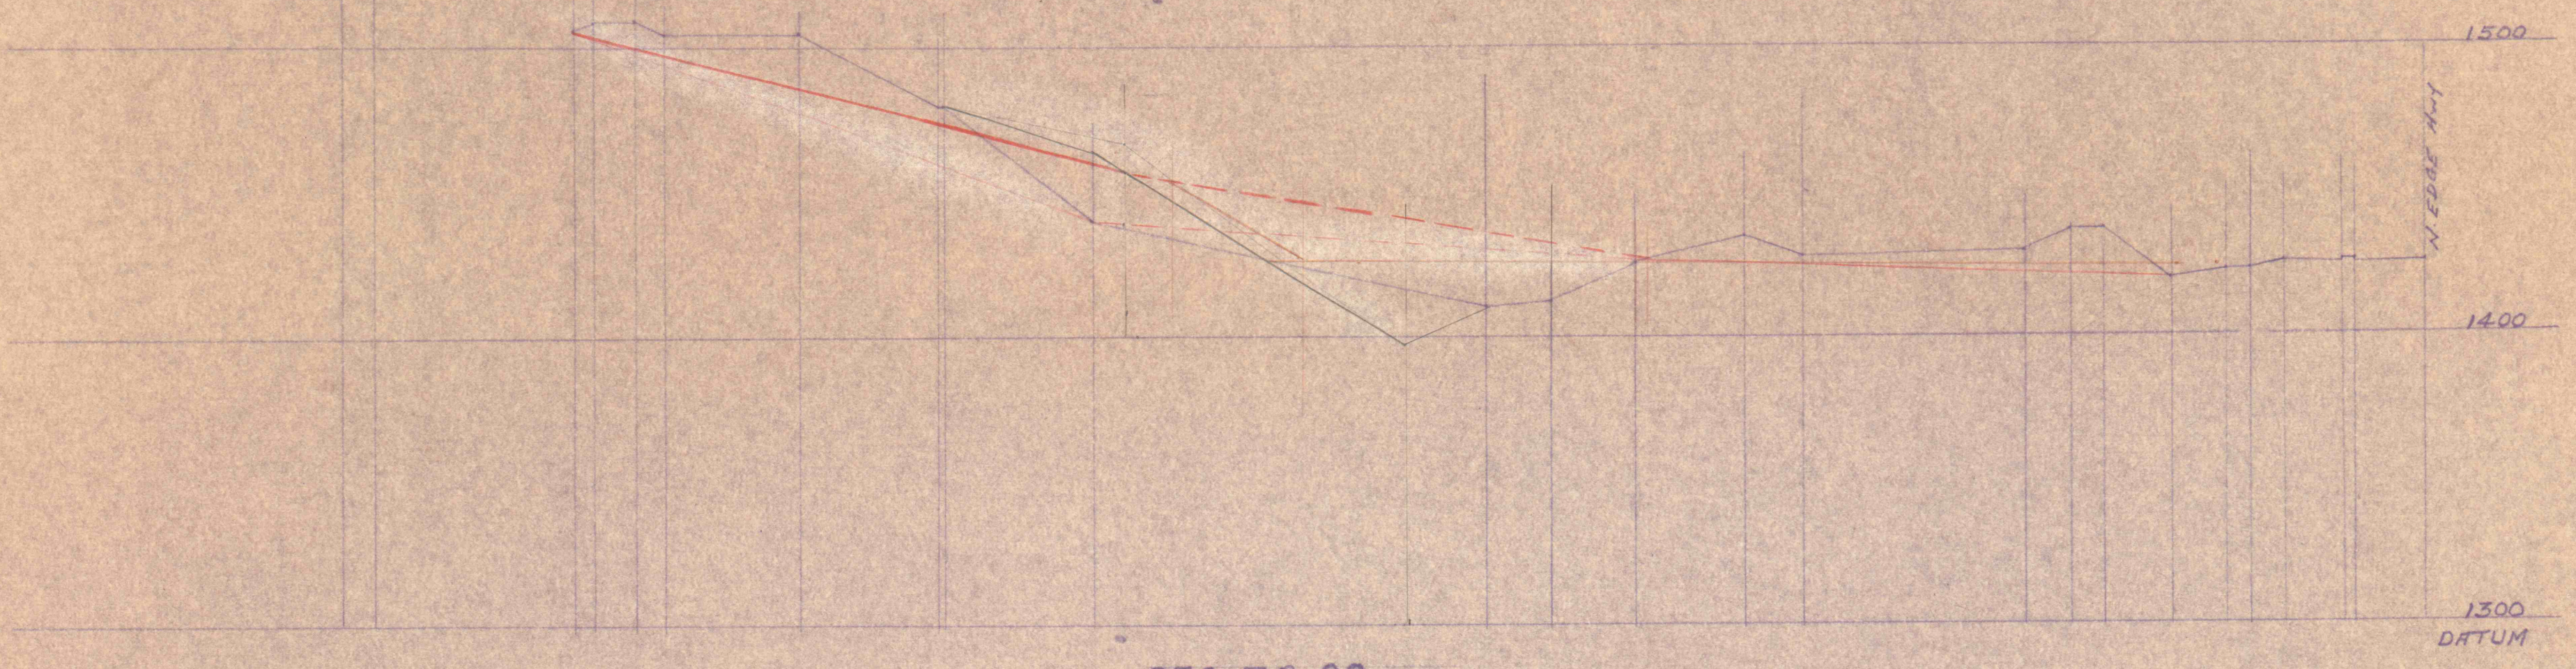


SEC. 32+00

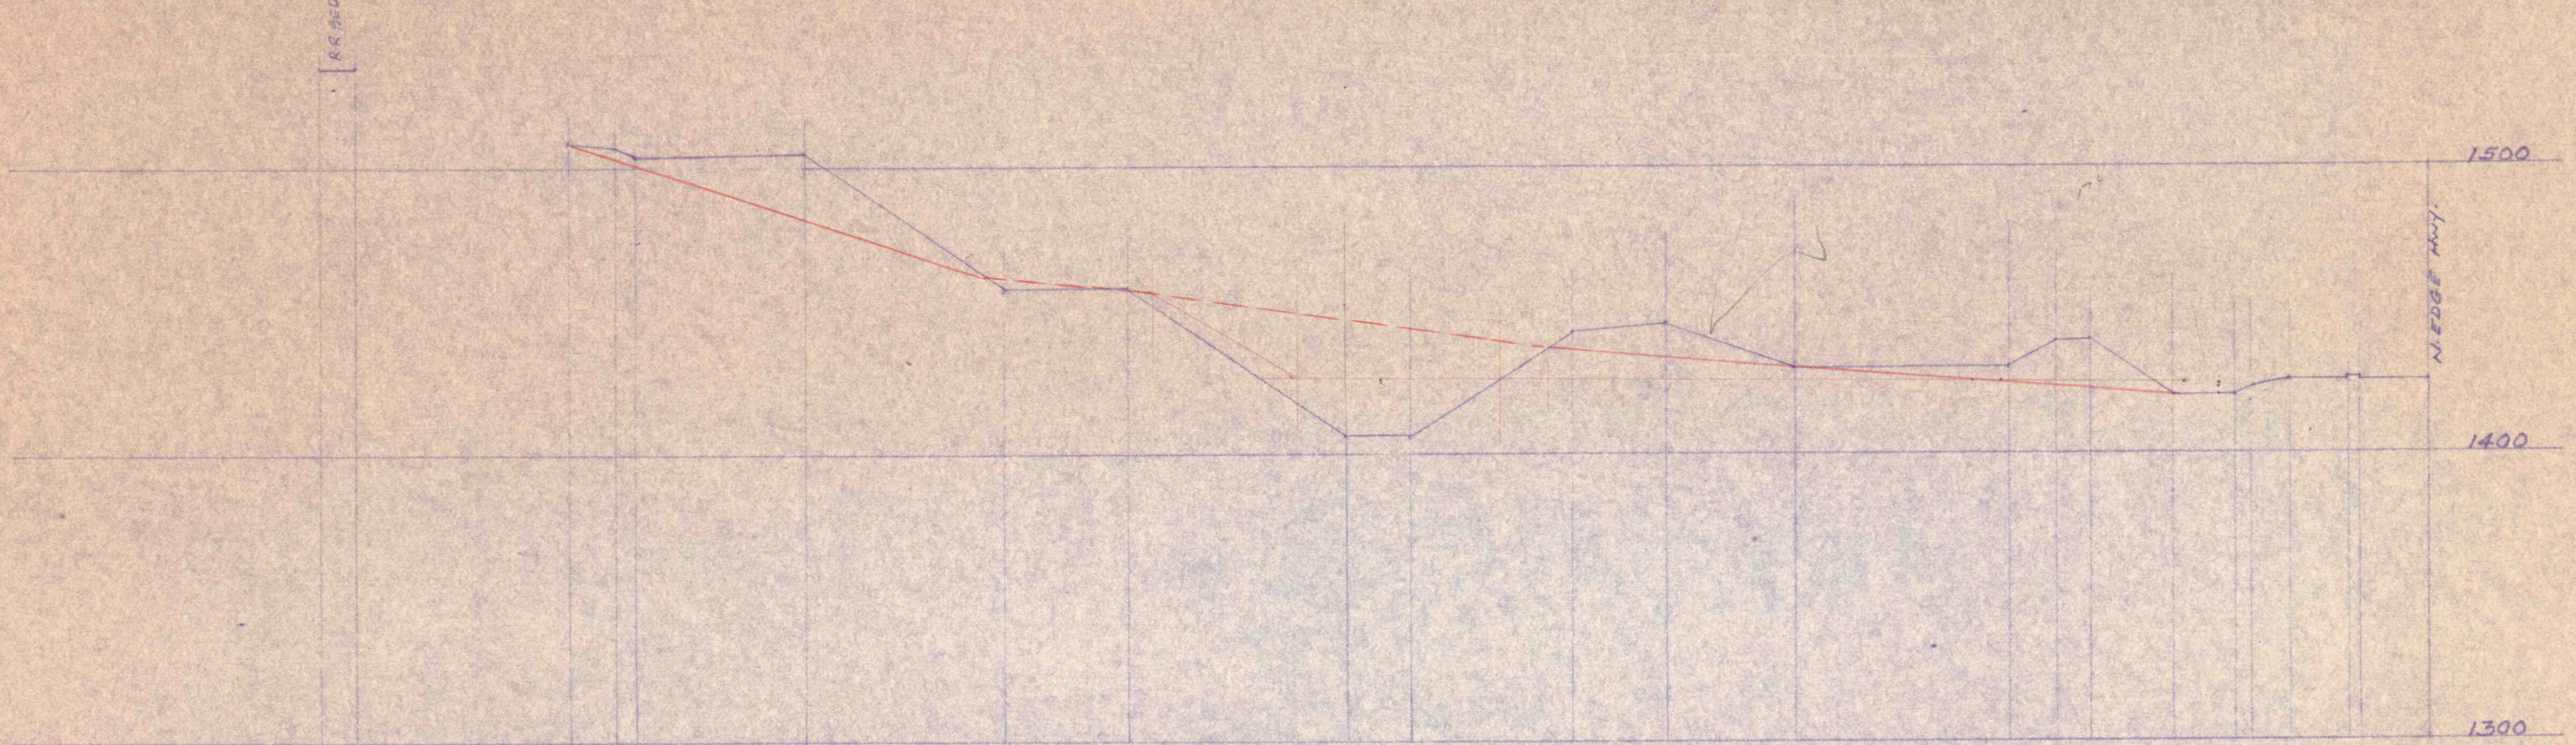


SEC. 32+50

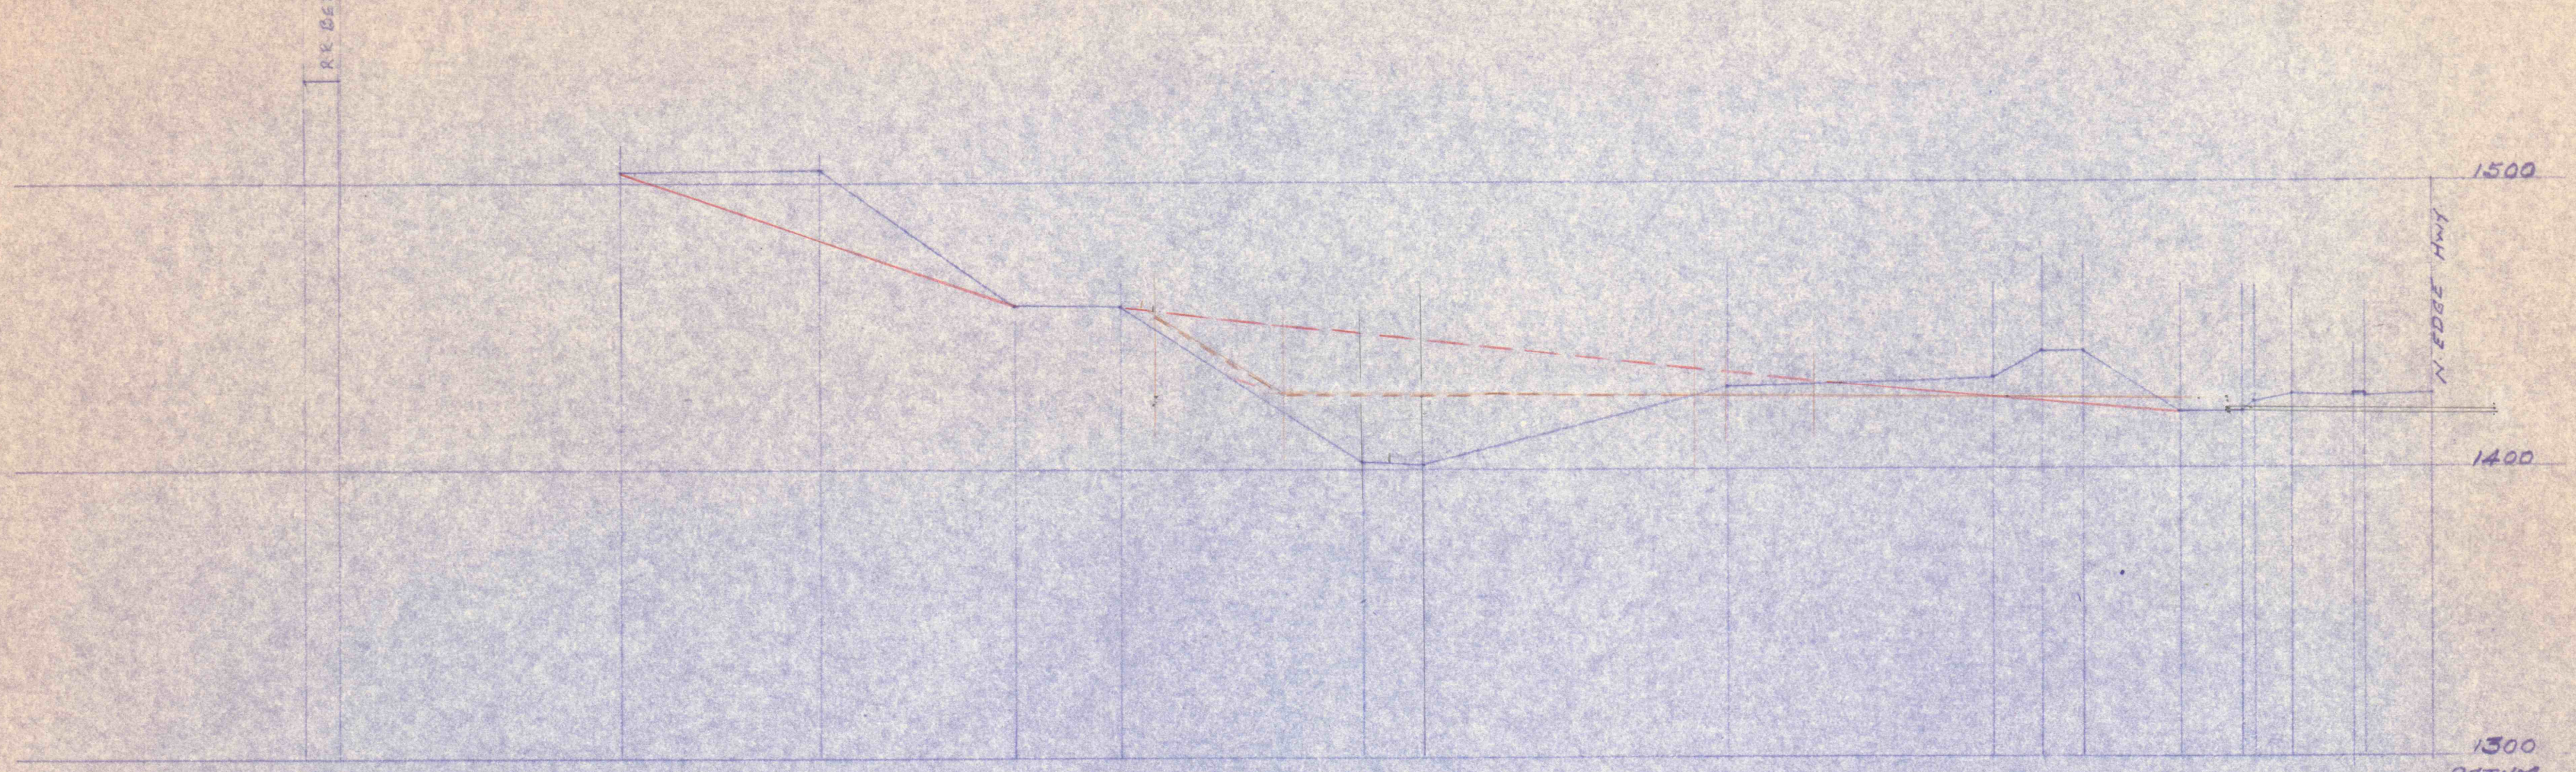

SEC. 33+00

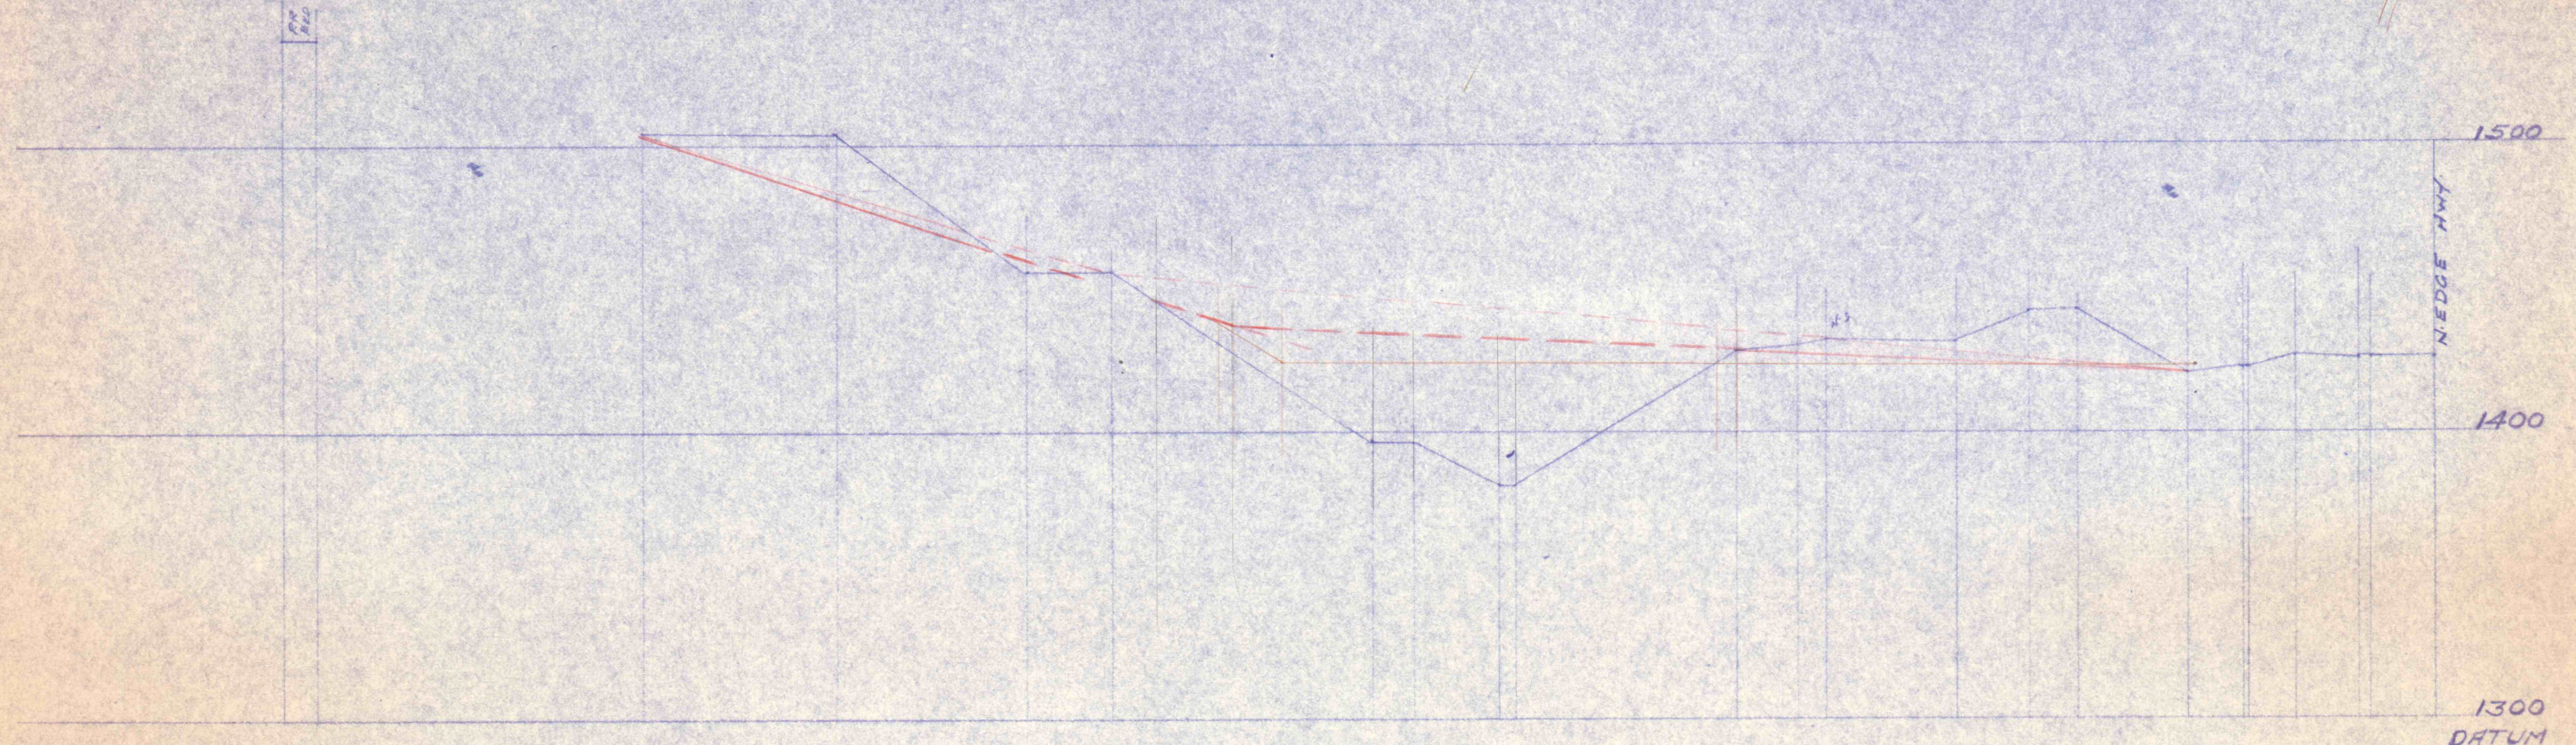

SEC. 33+50

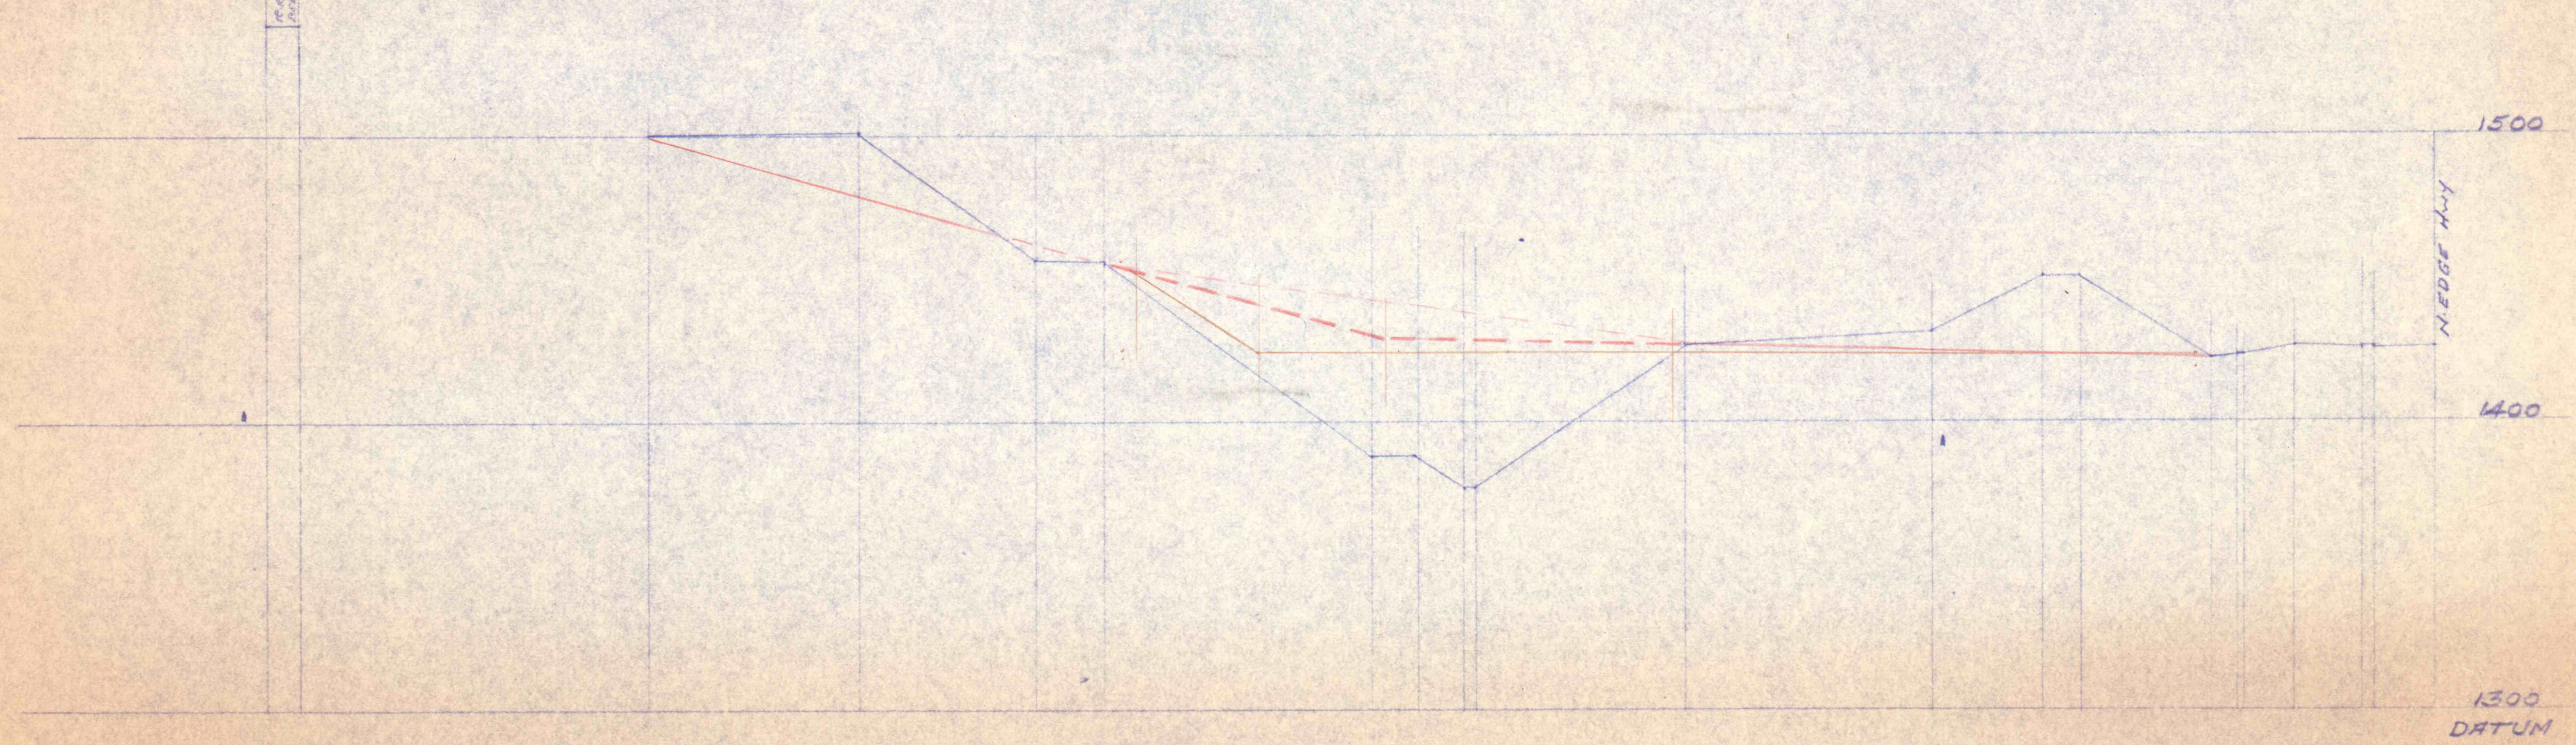

SEC. 34+00

