
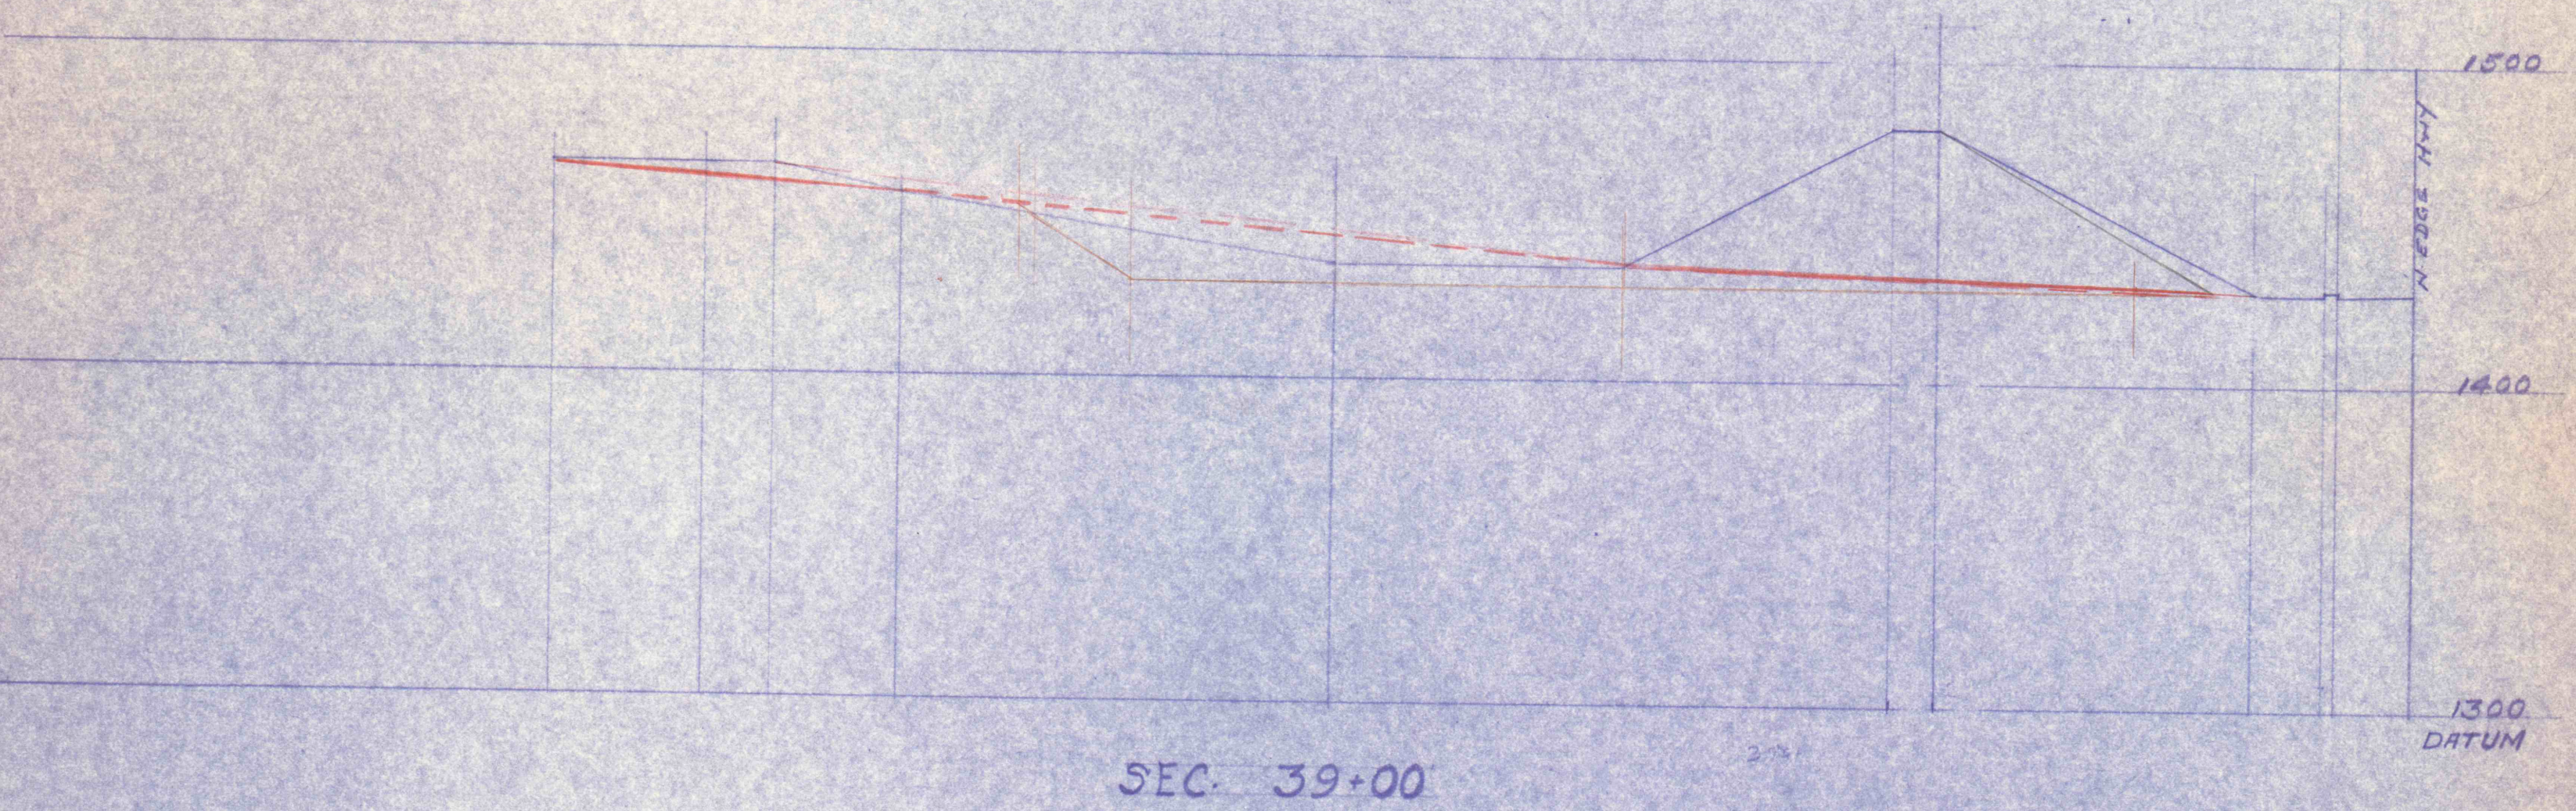
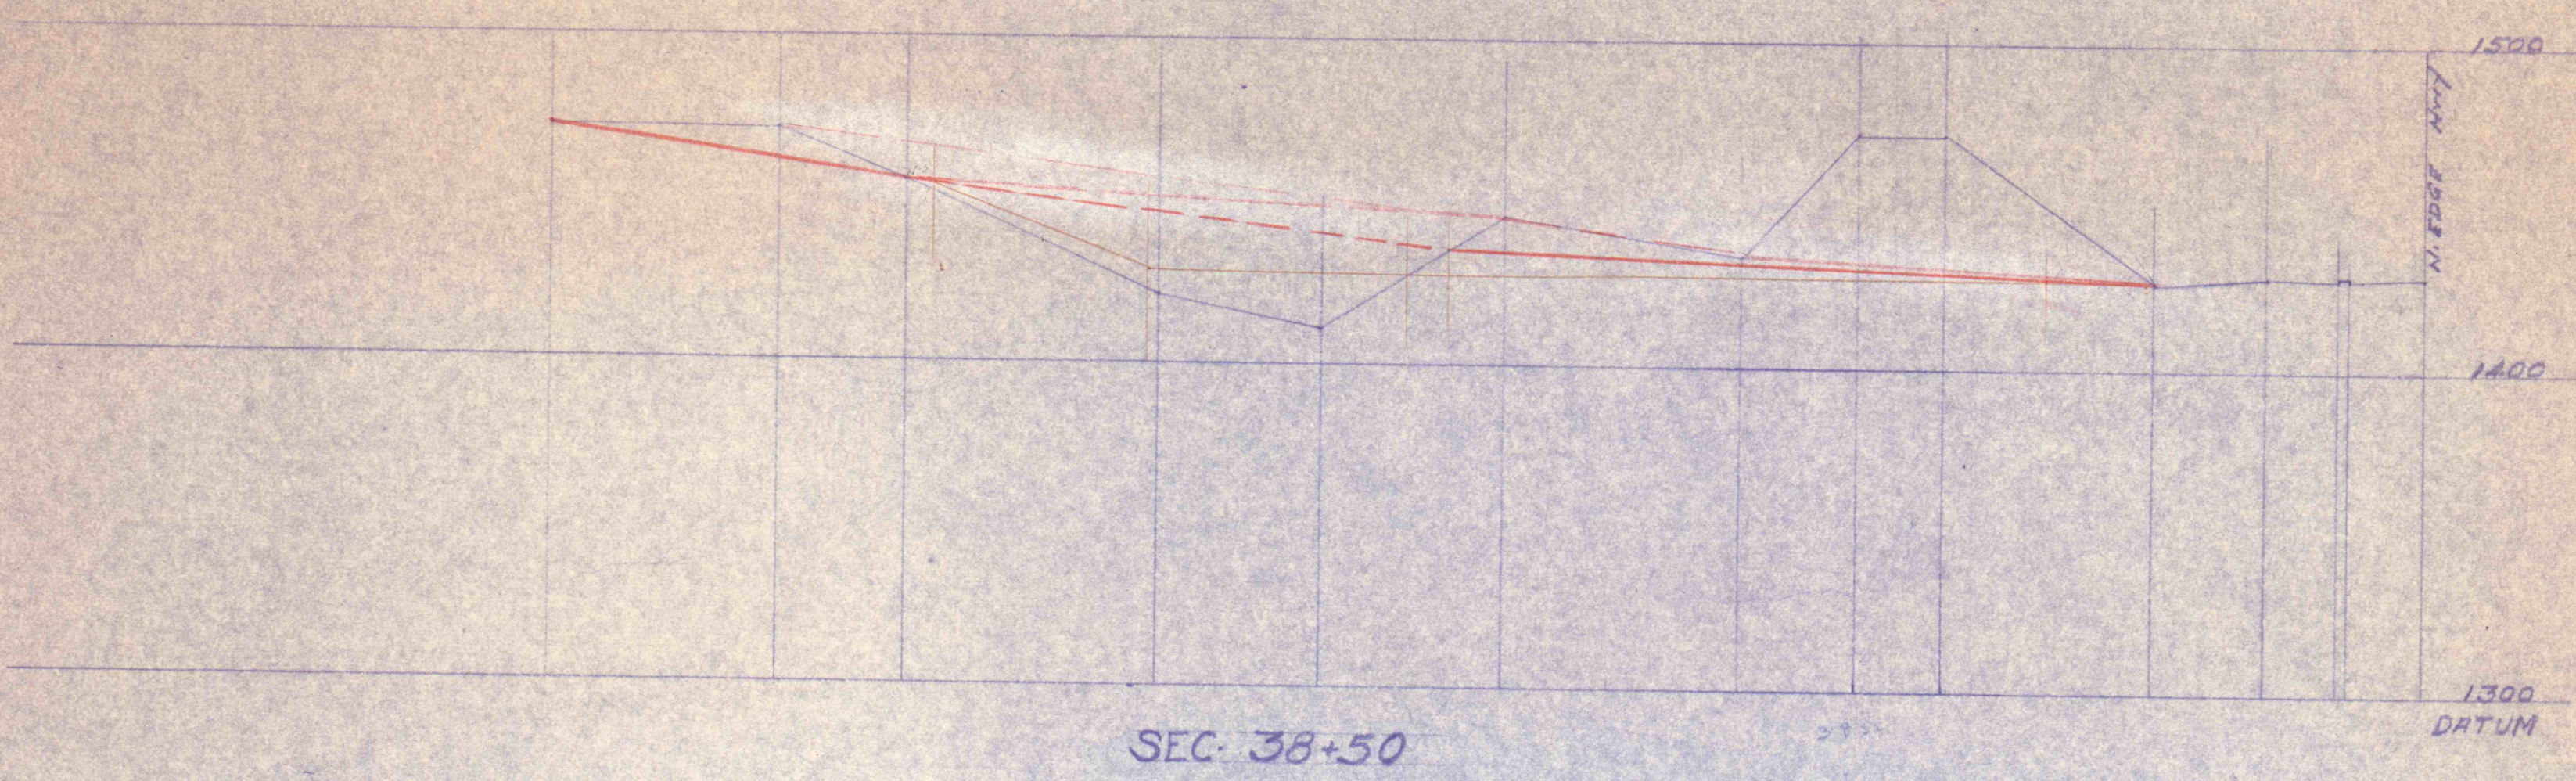


N  
SCALE 1"=50'

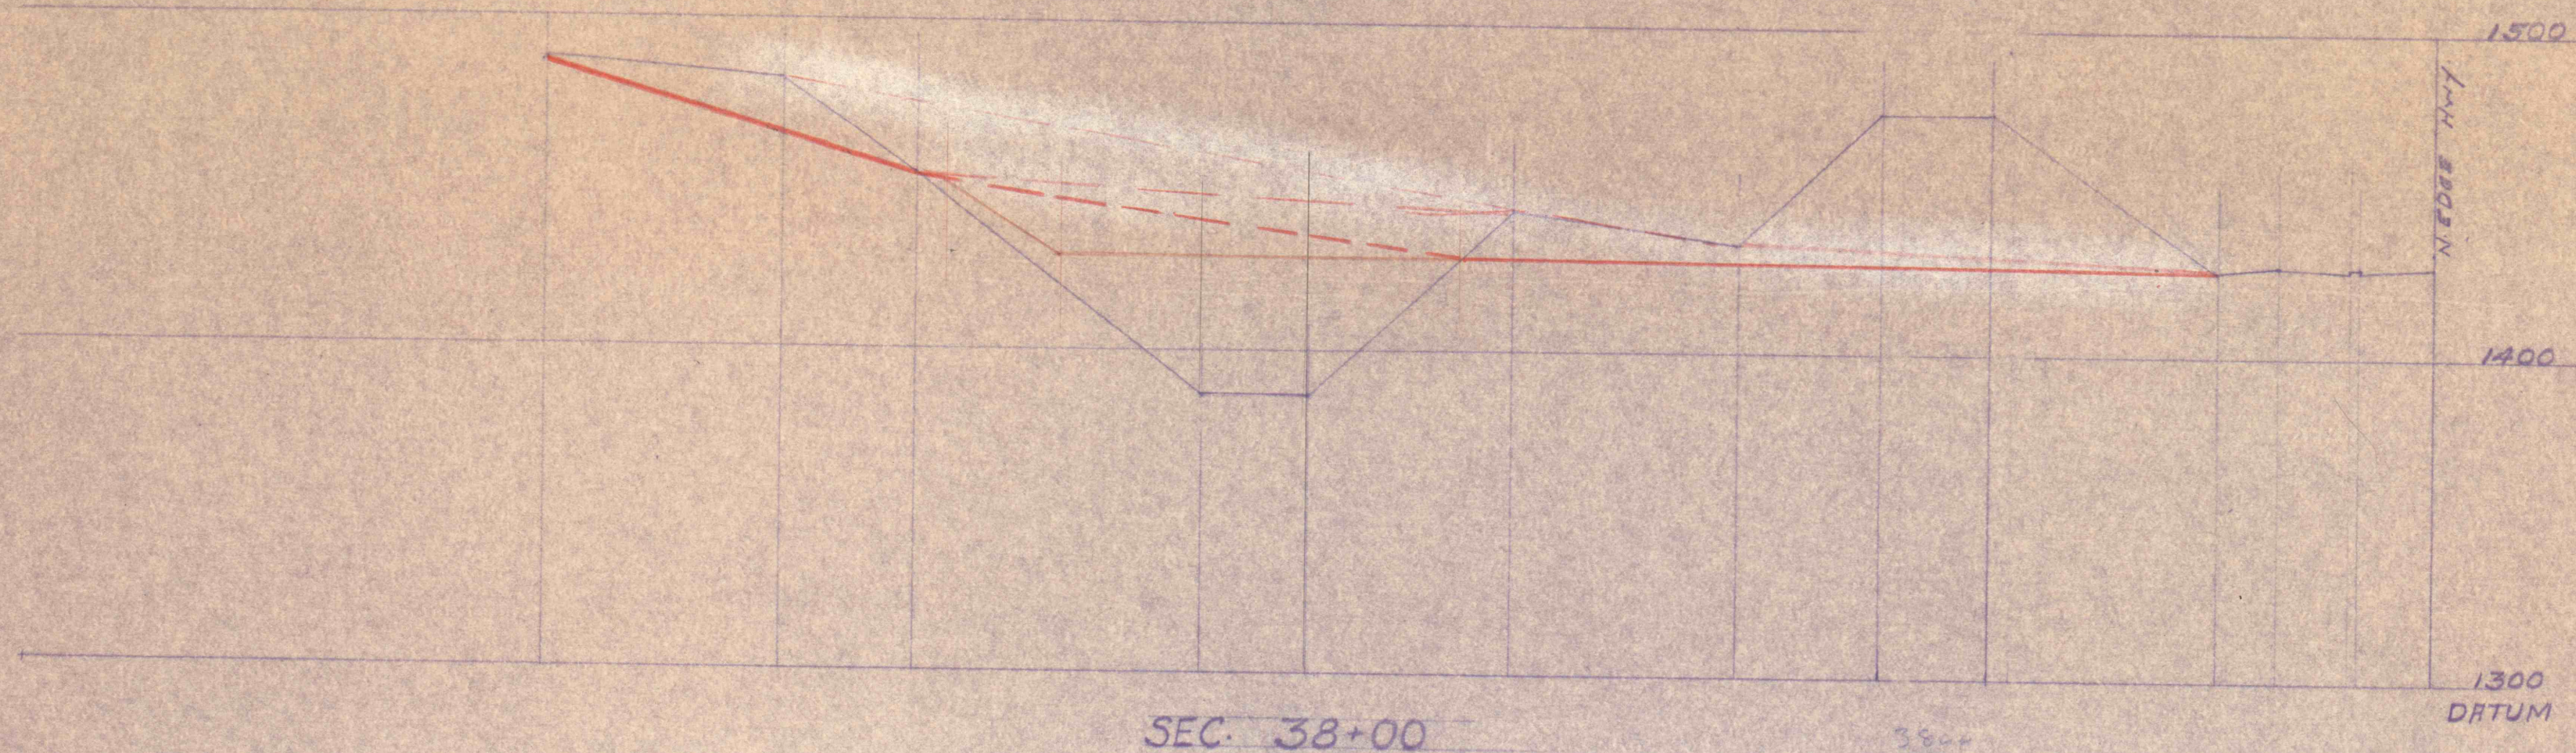

29150

Handwritten scribble or signature