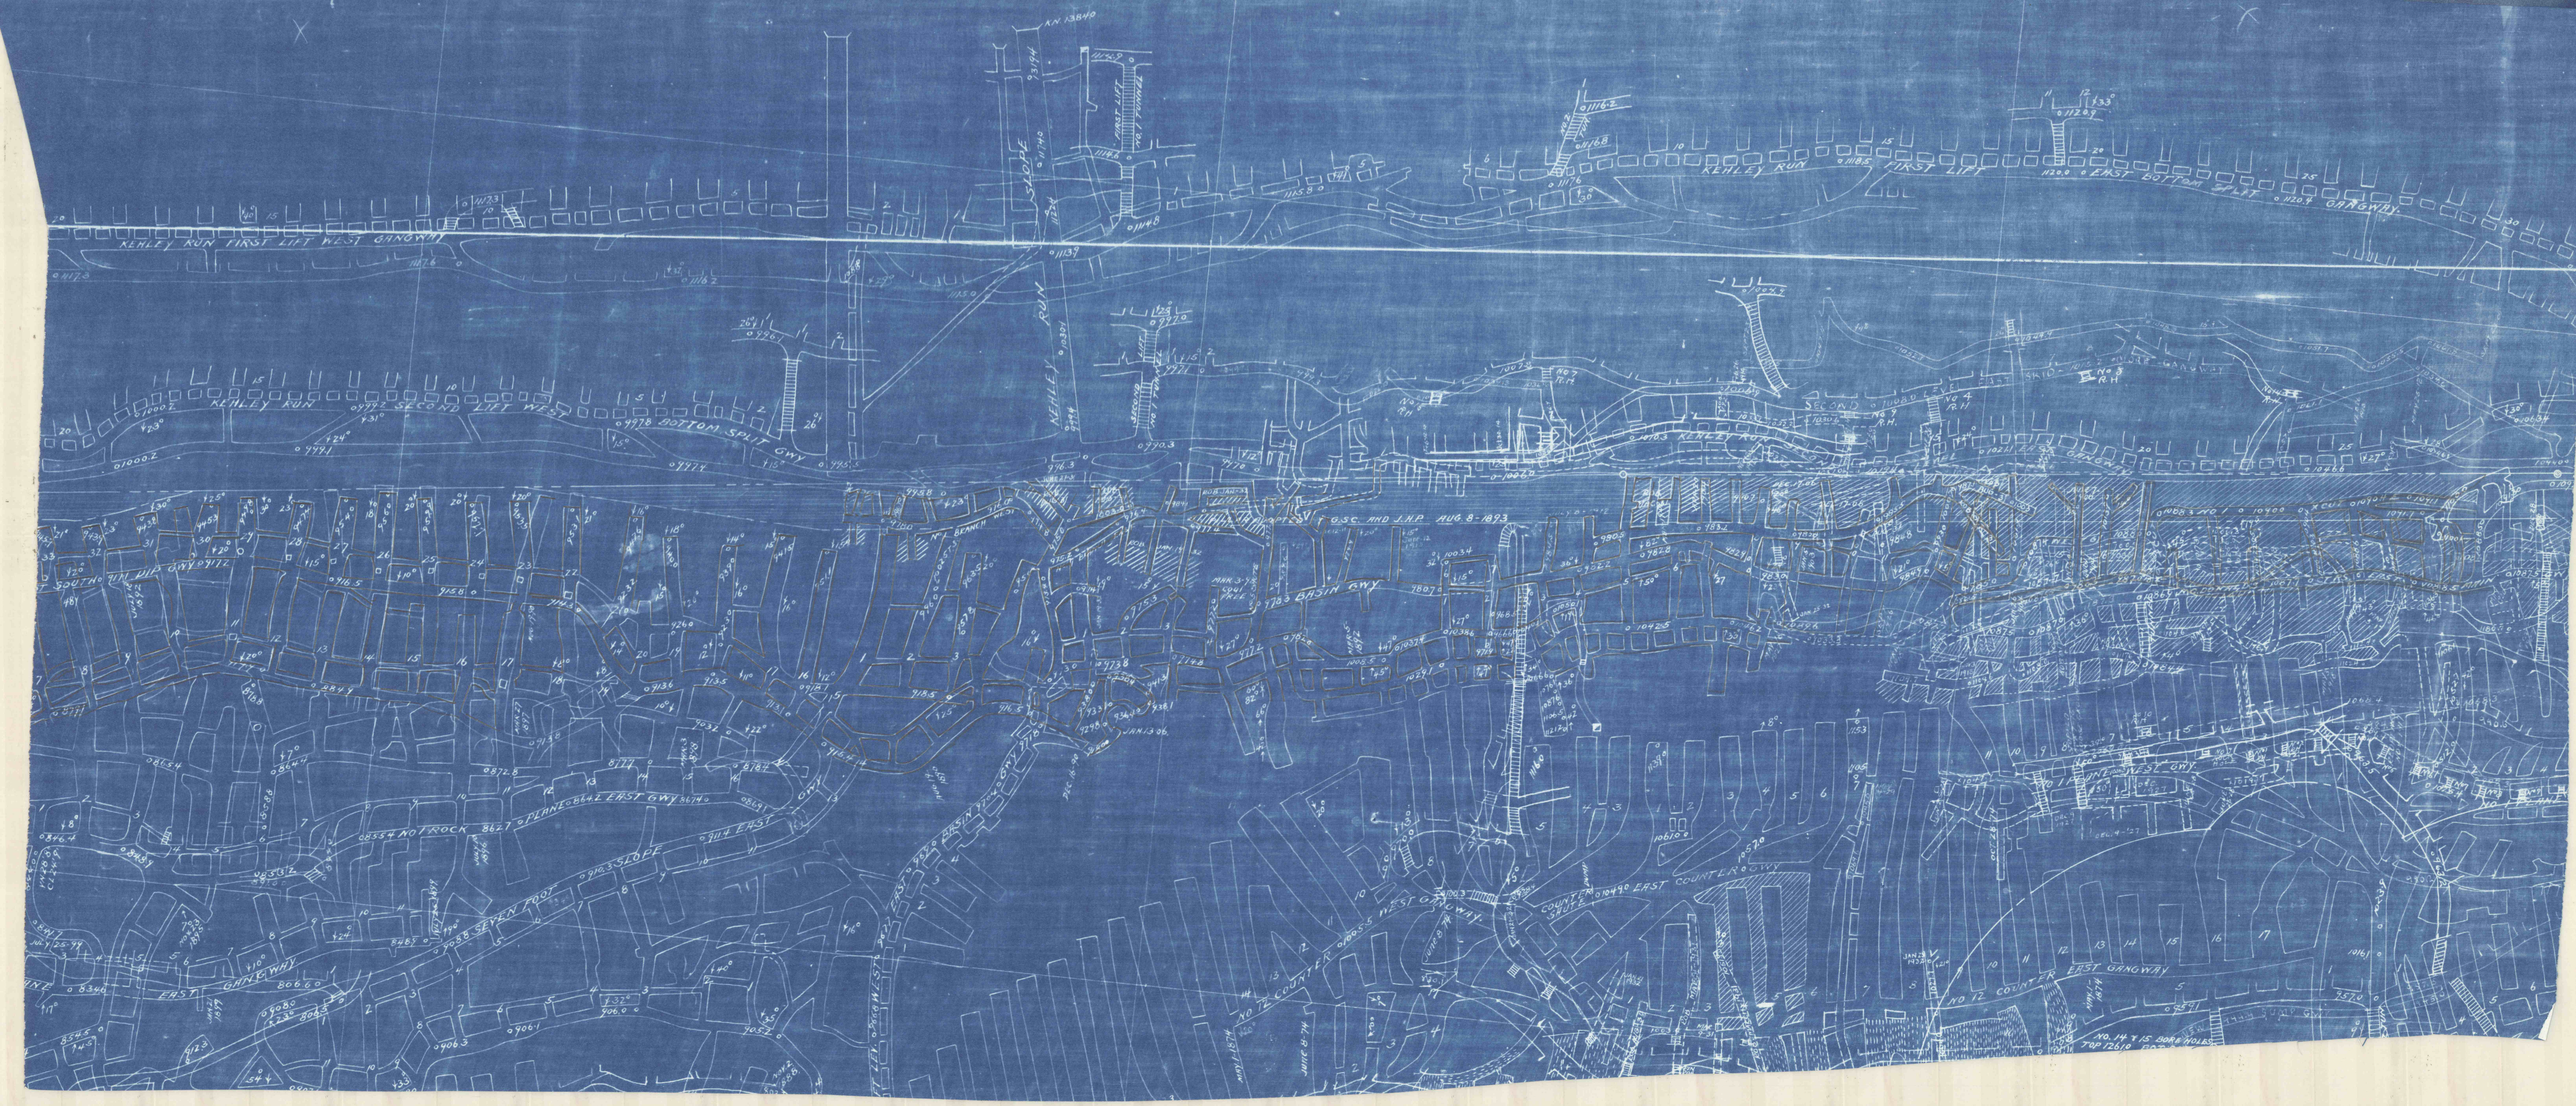
KEHLEY RUN FIRST LIFT WEST GANGWAY
KEHLEY RUN FIRST LIFT EAST BOTTOM SPLIT GANGWAY
KEHLEY RUN SECOND LIFT WEST BOTTOM SPLIT GWY
KEHLEY RUN SLOPE
BASIN GWY
NO 1 PLANE WEST GWY
NO 1 PLANE EAST GWY
NO 1 ROCK
SEVEN FOOT SLOPE
EAST GANGWAY
NO 12 COUNTER WEST GANGWAY
NO 12 COUNTER EAST GANGWAY
EAST COUNTER GWY
COUNTER SHUTE
NO. 14 & 15 BORE HOLES
G.S.C. AND J.H.P. AUG. 8-1893