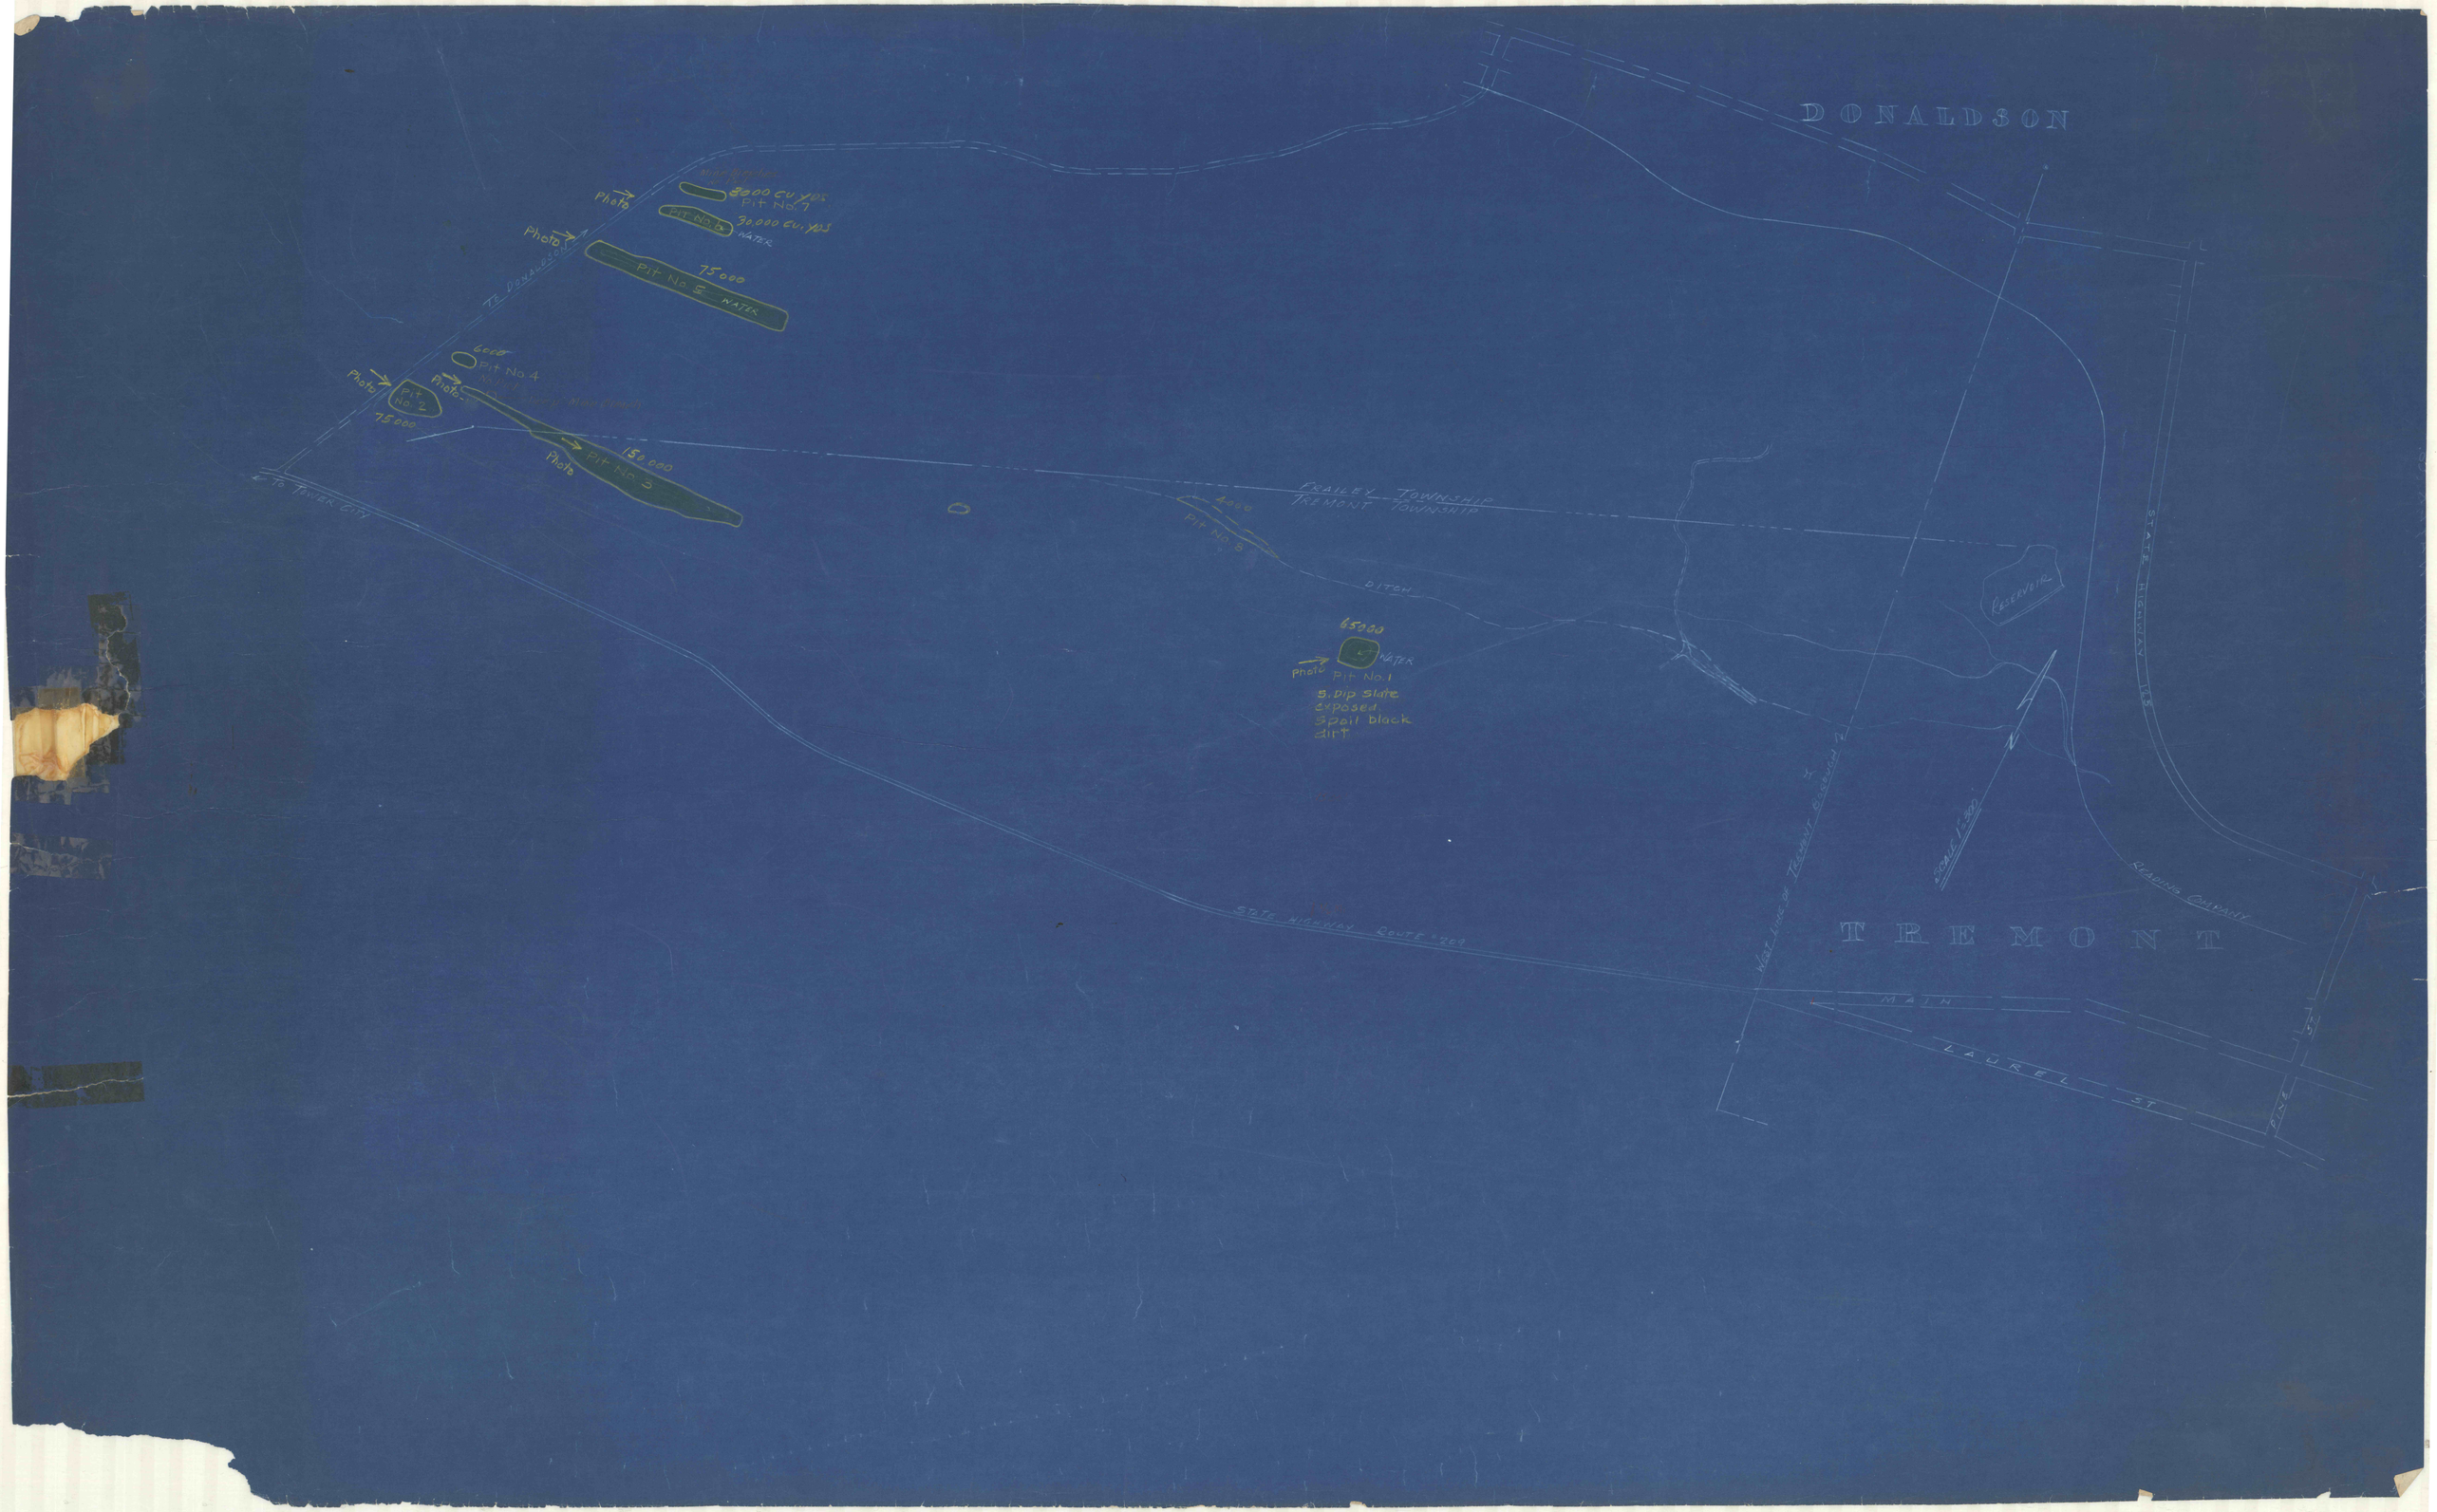
DONALDSON
Photo
3000 CU YDS
Pit No. 7
Pit No. 6
90,000 CU. YDS
WATER
Photo
75000
Pit No 5
WATER
TO DONALDSON
6000
Pit No 4
Photo
Pit No. 2
75000
Photo
150,000
Pit No. 3
TO TOWER CITY
FRAILEY TOWNSHIP
TREMONT TOWNSHIP
4000
Pit No. 8
DITCH
65000
WATER
Photo
Pit No. 1
S. Dip Slate
exposed
Spoil black
dirt
RESERVOIR
STATE HIGHWAY 125
READING COMPANY
TREMONT
MAIN
LAUREL ST
STATE HIGHWAY ROUTE #209