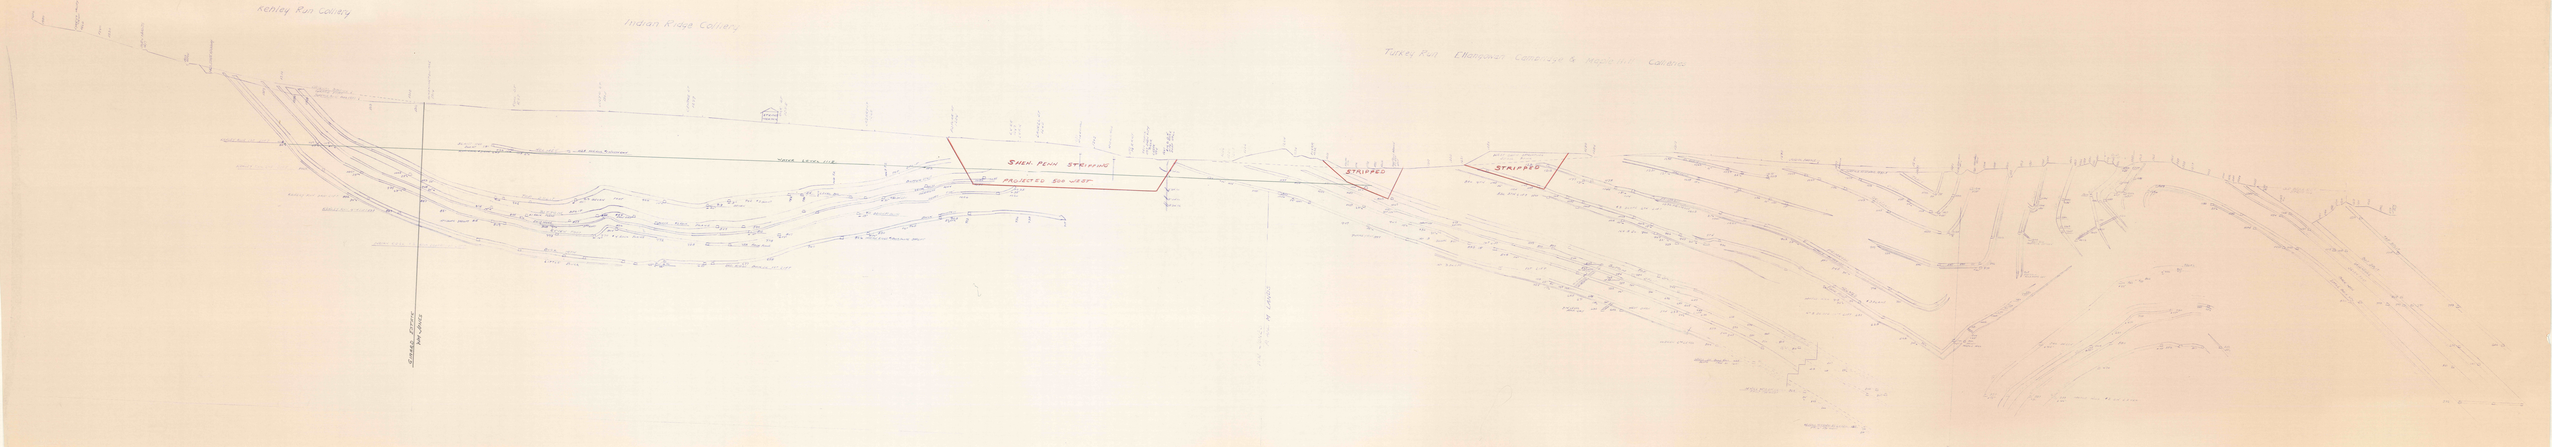
Kenley Run Colliery
Indian Ridge Colliery
Turkey Run
SHEN. PENN STRIPPING
PROJECTED SOR WEST
STRIPPED
STRIPPED
SHEN. PENN. W. WORKS
W. WORKS