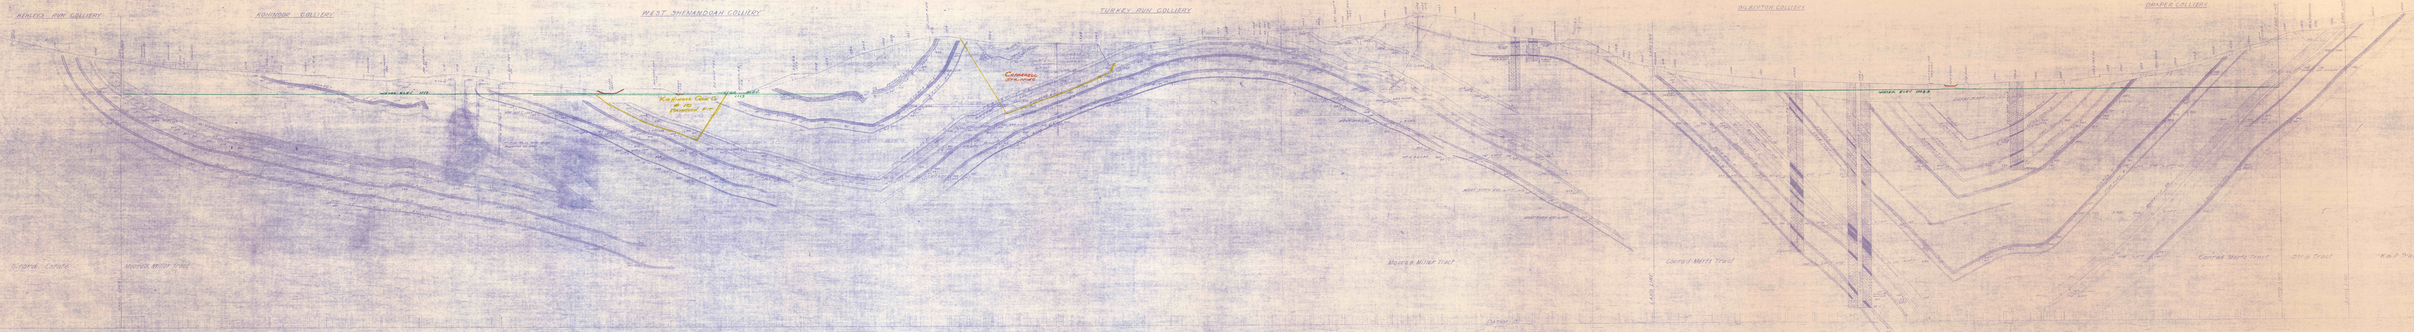

Kohinoor, West Shenandoah & Turkey Run Collieries

Cross Section 50 feet East of West Line of Gilbert Estate

100 Thru Gilberton & Draper Collieries

Scale 1"=100 feet

Approved by Mine Insp. Office Division Engineer