


DATUM: 1340

| | | | |
|-----------|----------|--|------|
| NO | DATE | REVISION | APPR |
| 1 | 10-20-75 | Revised Existing Ground Line and Proposed Invert Due to Alignment Change | RLZ |
| SUBMITTED | | | |
| APPROVED | | | |
| APPROVED | | | |
| APPROVED | | | |

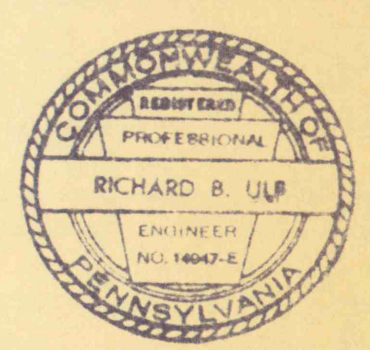

COMMONWEALTH OF PENNSYLVANIA
DEPARTMENT OF ENVIRONMENTAL RESOURCES
OFFICE OF RESOURCES MANAGEMENT
PROJECT NO. SL 113-5-1
MINE DRAINAGE POLLUTION ABATEMENT
COAL RUN
SHAMOKIN CREEK WATERSHED
NORTHUMBERLAND COUNTY, PA
ERDMAN, ANTHONY, ASSOCIATES
Consulting Engineers
Camp Hill, Pa. Rochester, N.Y.

PROFILES