




STA. 9+95 \mathbb{E} =
STA. 9+95 \mathbb{C}

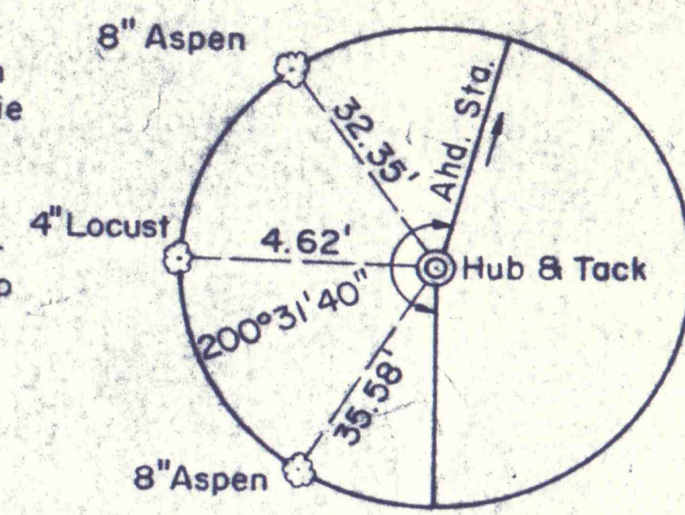


STA. 12+13 \mathbb{E}

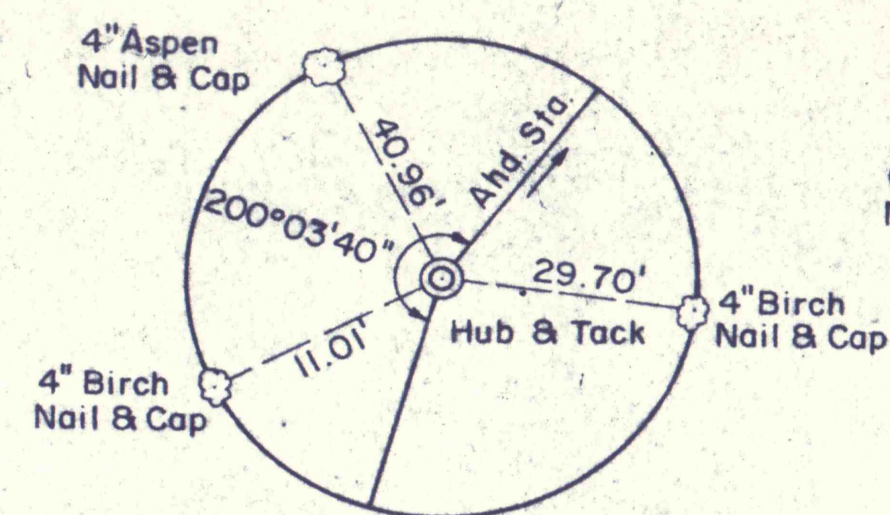


STA. 13+20 \mathbb{E}

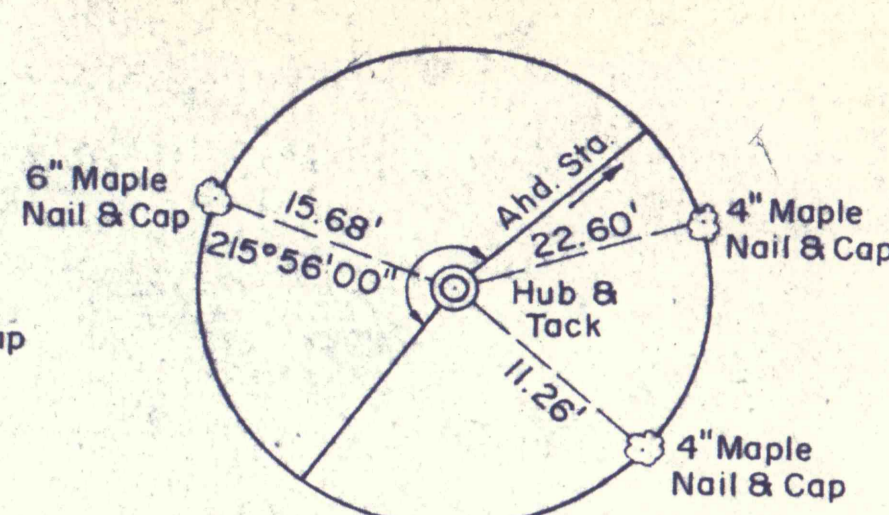


STA. 14+65 \mathbb{E} =
STA. 14+80 \mathbb{C}

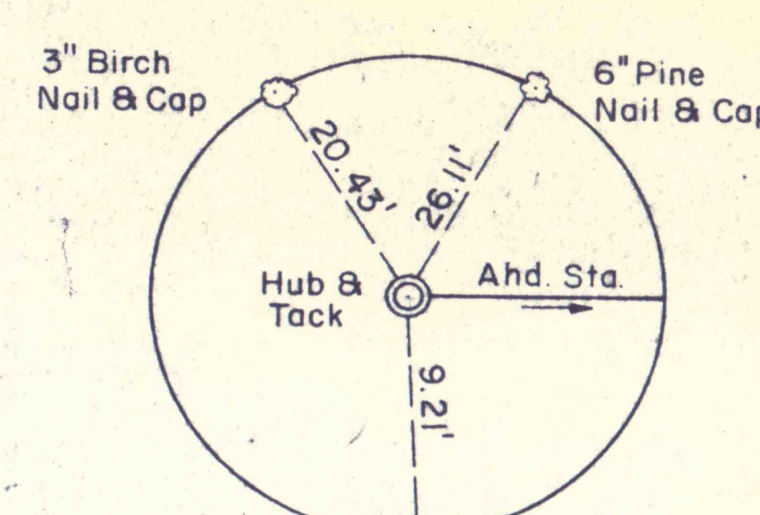


STA. 57+80 \mathbb{E} =
STA. 58+00 \mathbb{C}

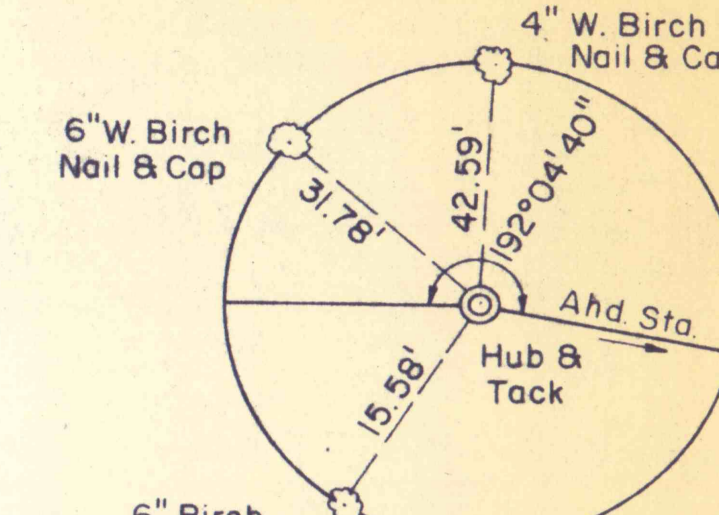


STA. 61+60 \mathbb{E}

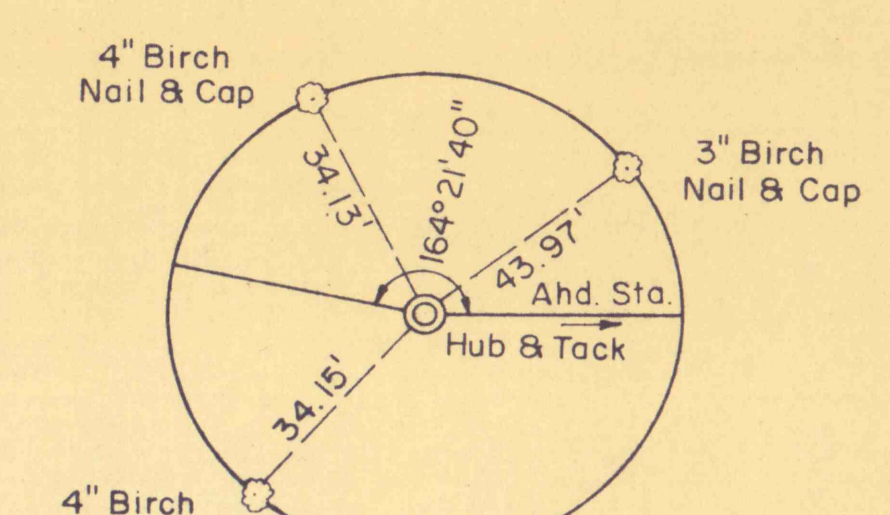


STA. 63+18 \mathbb{E}

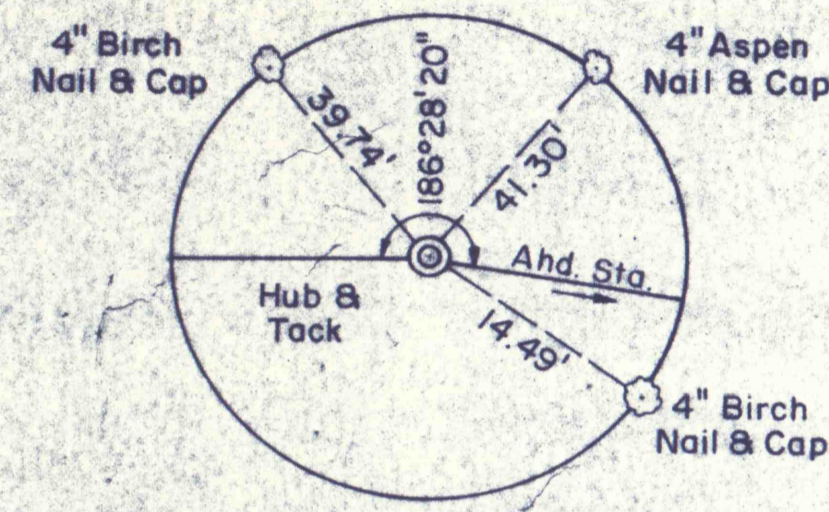


STA. 66+63 \mathbb{E}

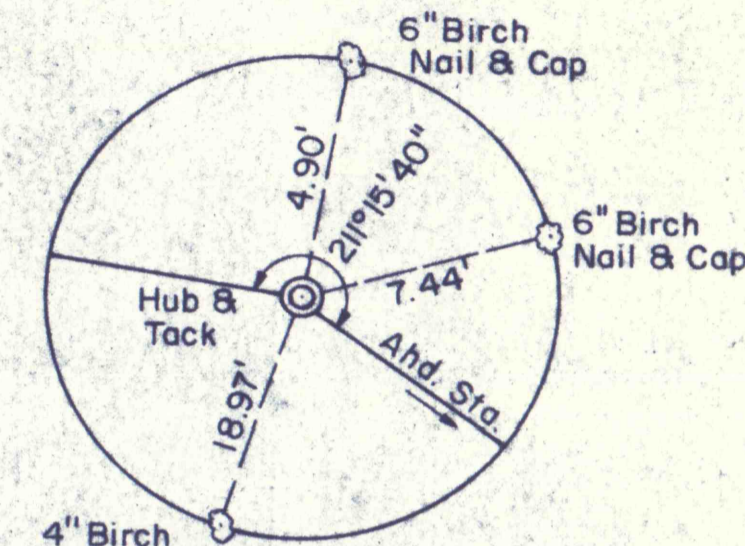


STA. 71+80 \mathbb{E}

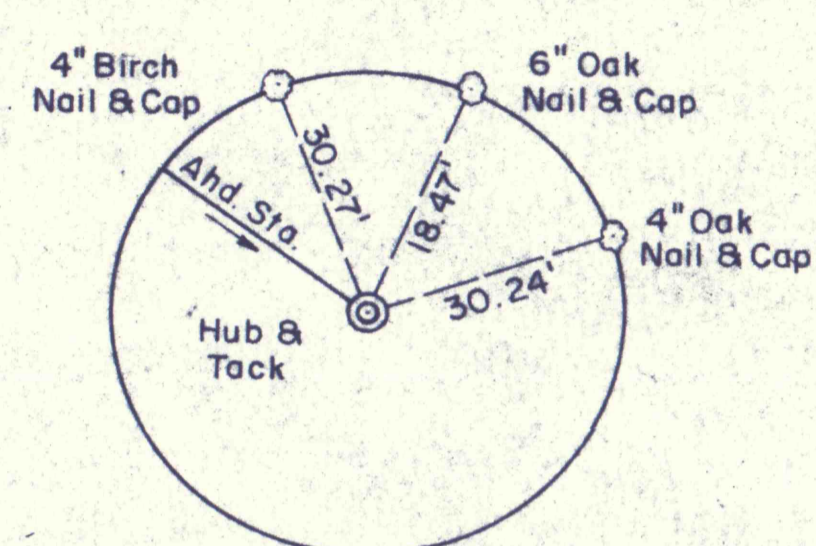


STA. 72+69 \mathbb{E}

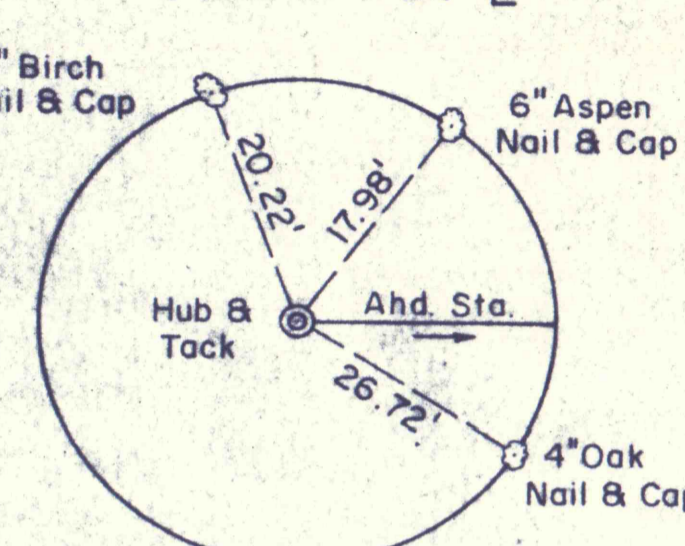


STA. 132+55 \mathbb{E} =
STA. 132+62 \mathbb{C}

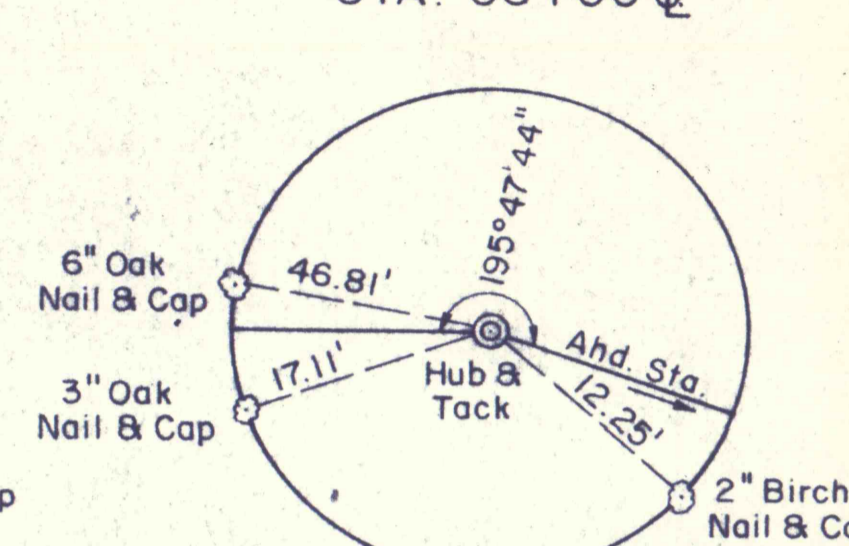


STA. 137+00 \mathbb{E} =
STA. C-0+00 \mathbb{C}

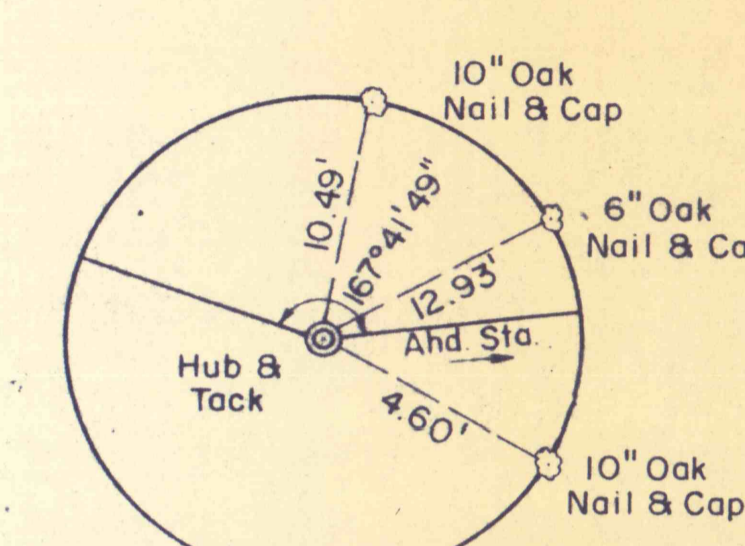


STA. 142+48 \mathbb{E}

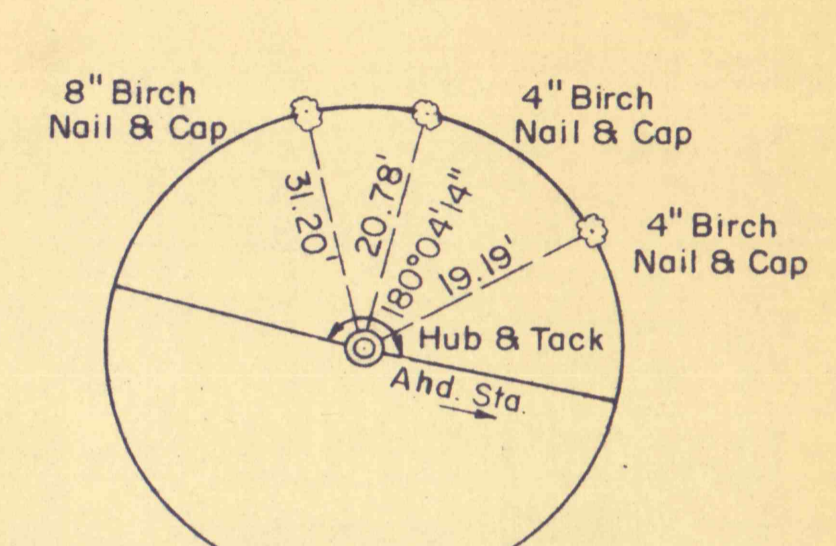


STA. 147+48 \mathbb{E}

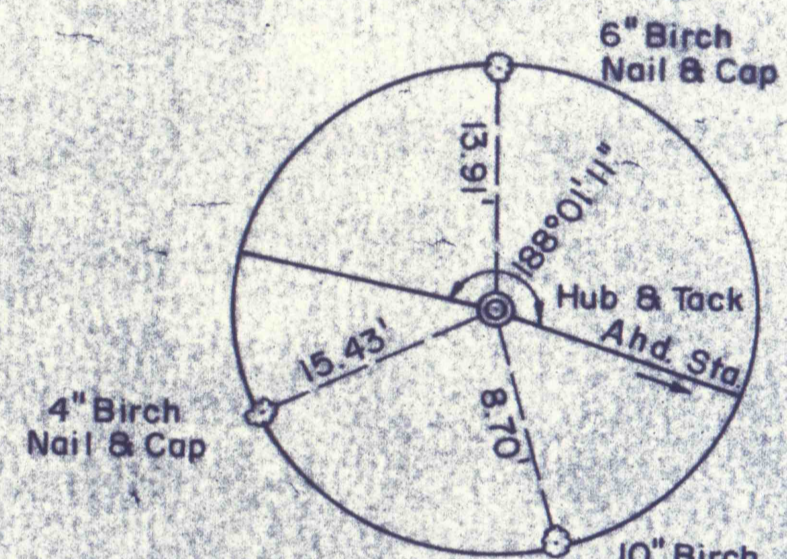


STA. 149+82 \mathbb{E}

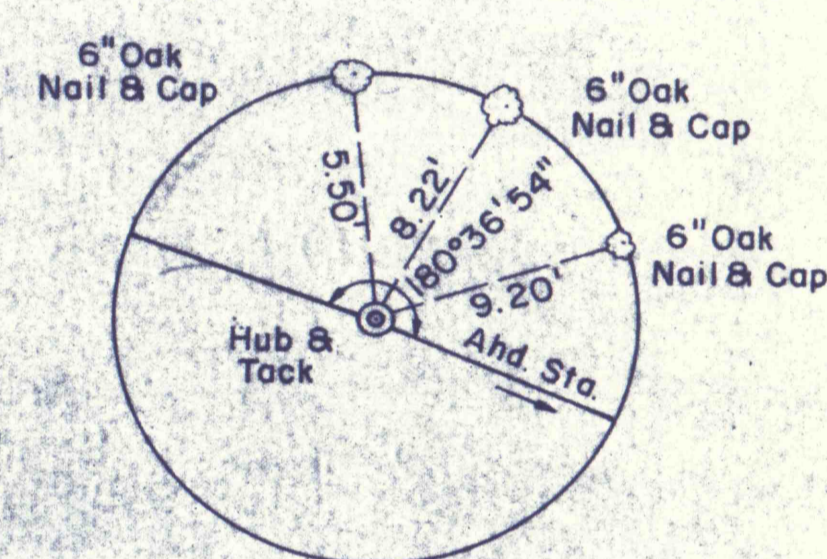


STA. 158+22 \mathbb{E}

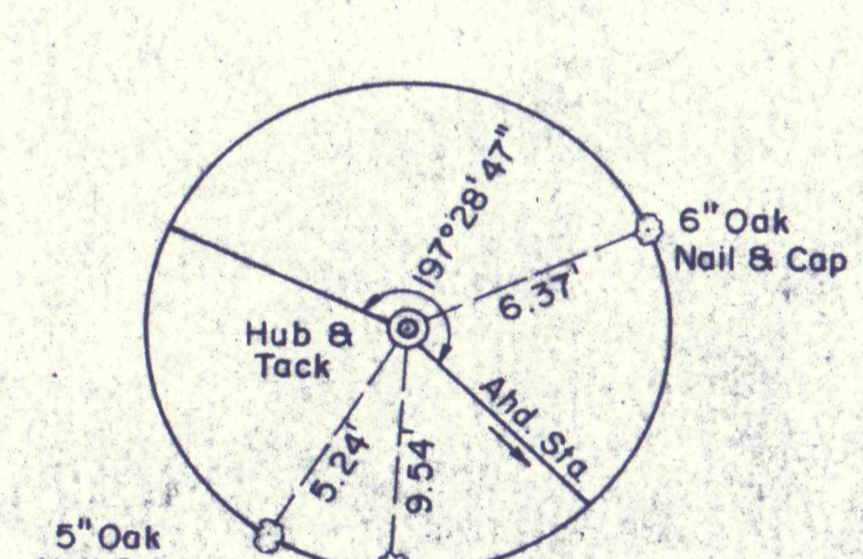


STA. 164+50 \mathbb{E}

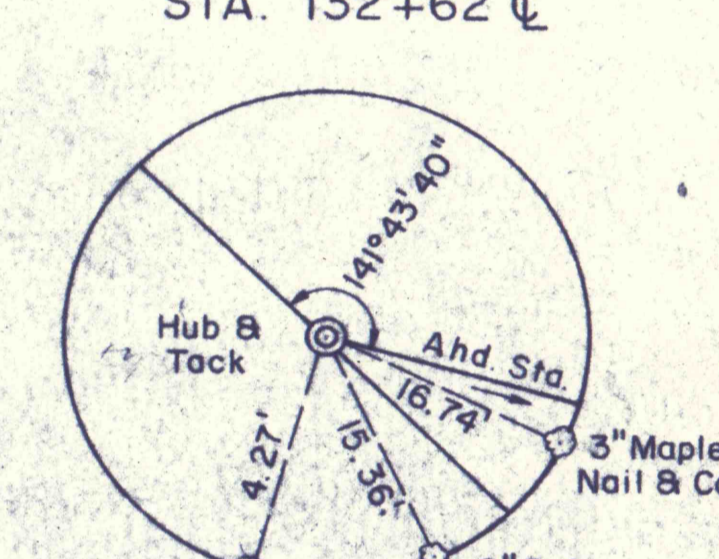


STA. 167+32 \mathbb{E} =
STA. E-0+00 \mathbb{C}

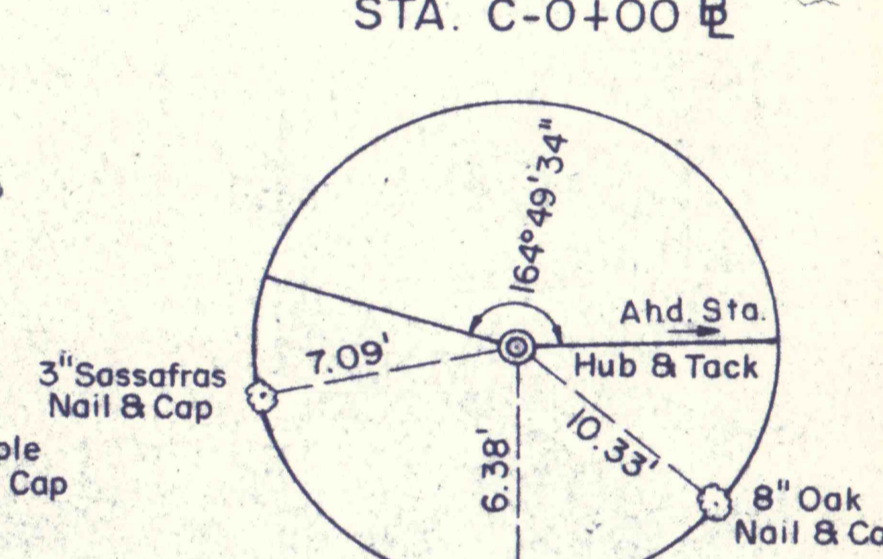


STA. 170+84 \mathbb{E}

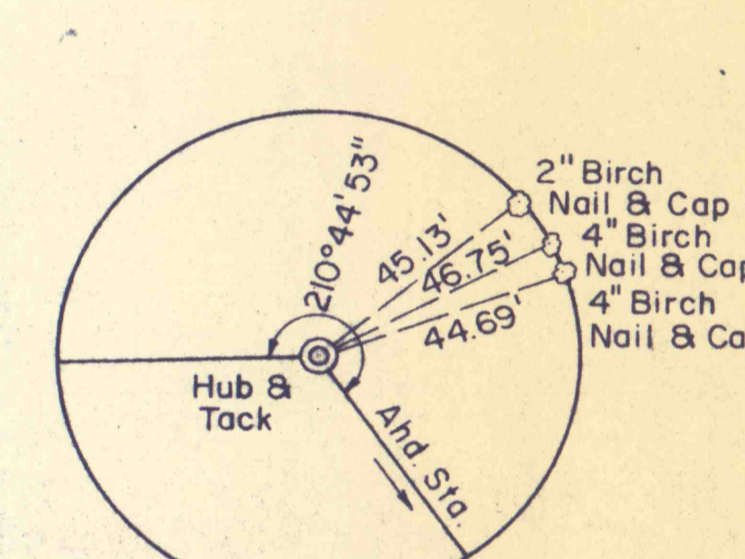


STA. 175+36 \mathbb{E}

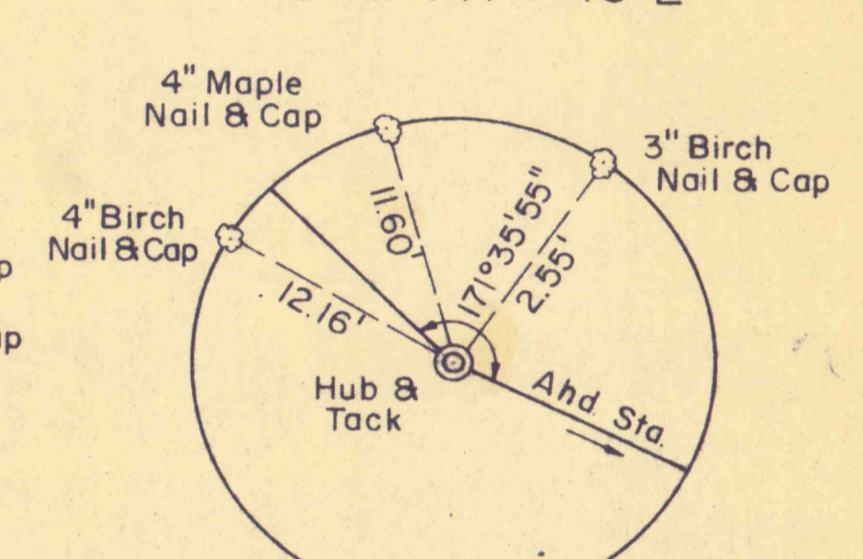


STA. E-3+18 \mathbb{E}

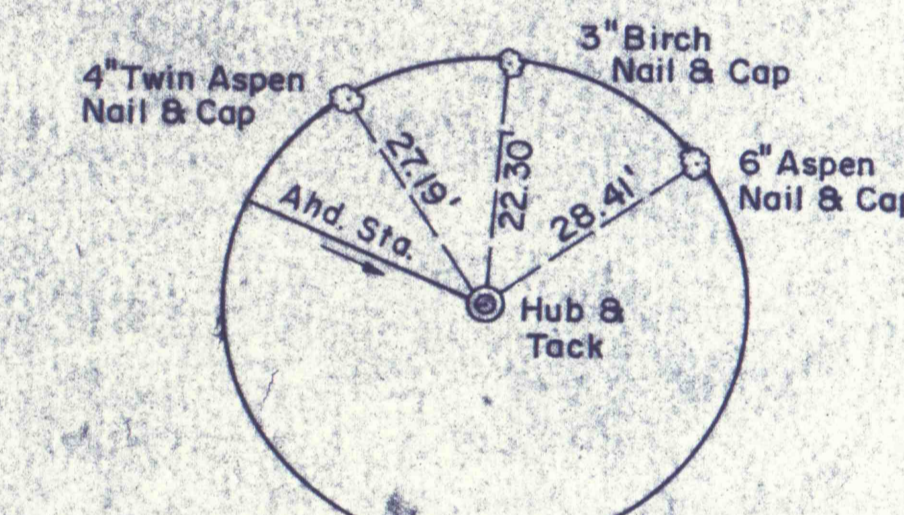


STA. E-7+00 \mathbb{E}

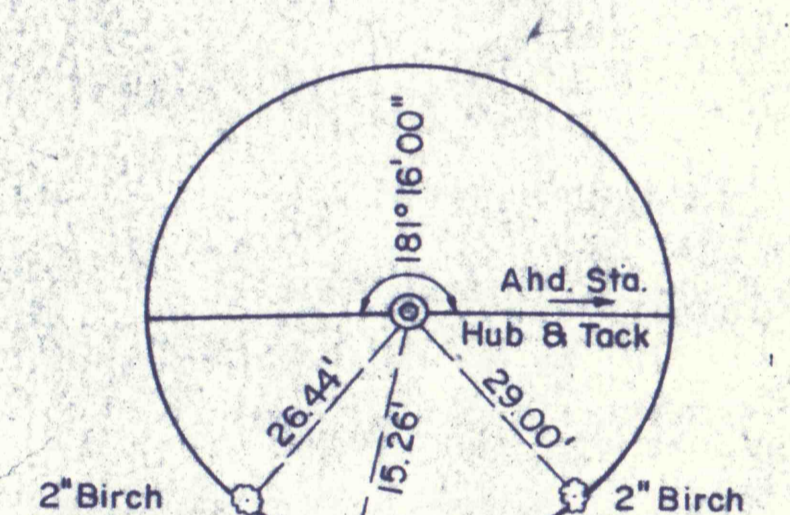


STA. 182+61 \mathbb{E}

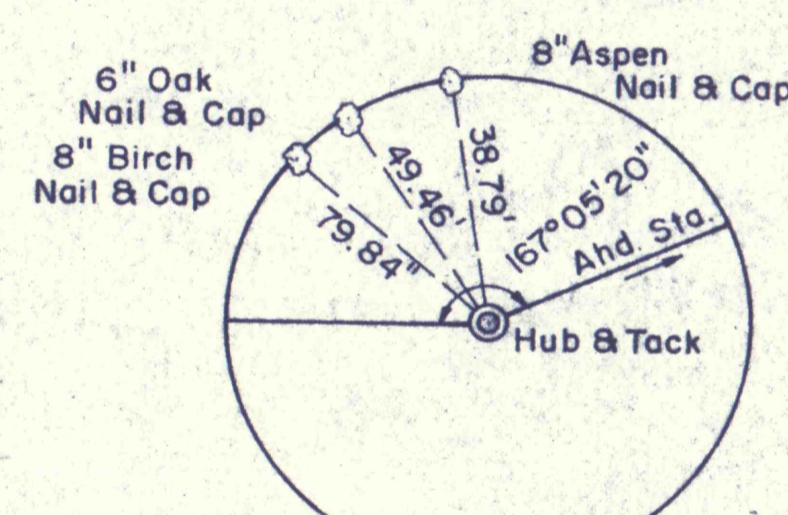


STA. 190+68 \mathbb{E}

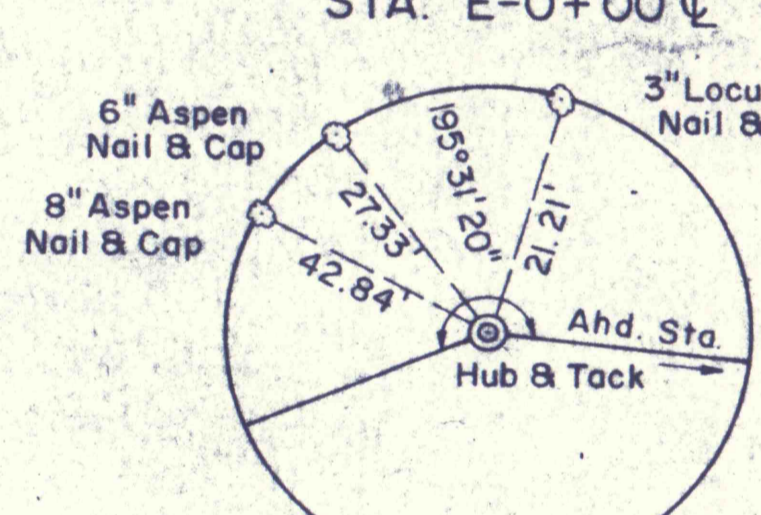


STA. 198+17 \mathbb{E}

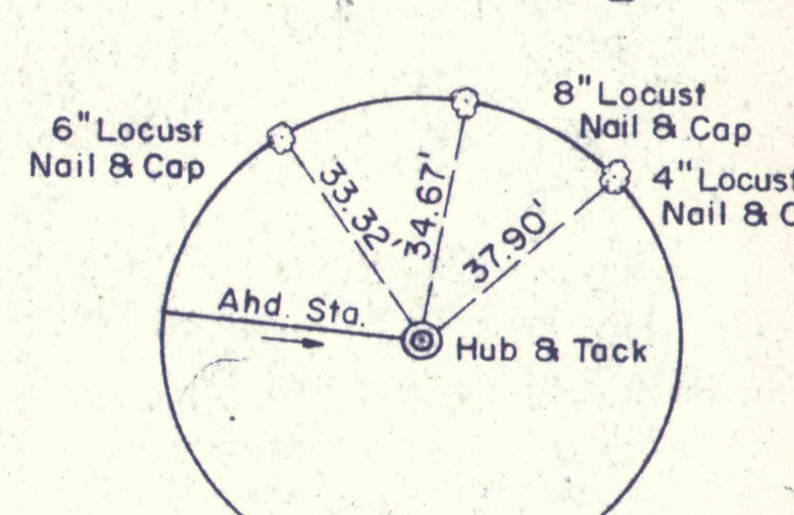


STA. 202+29 \mathbb{E}

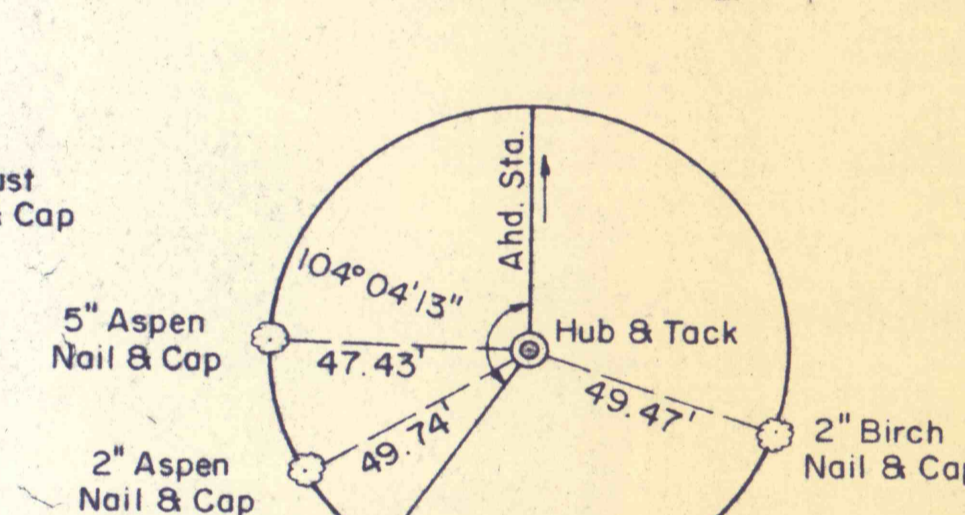


STA. C-4+34 \mathbb{E}

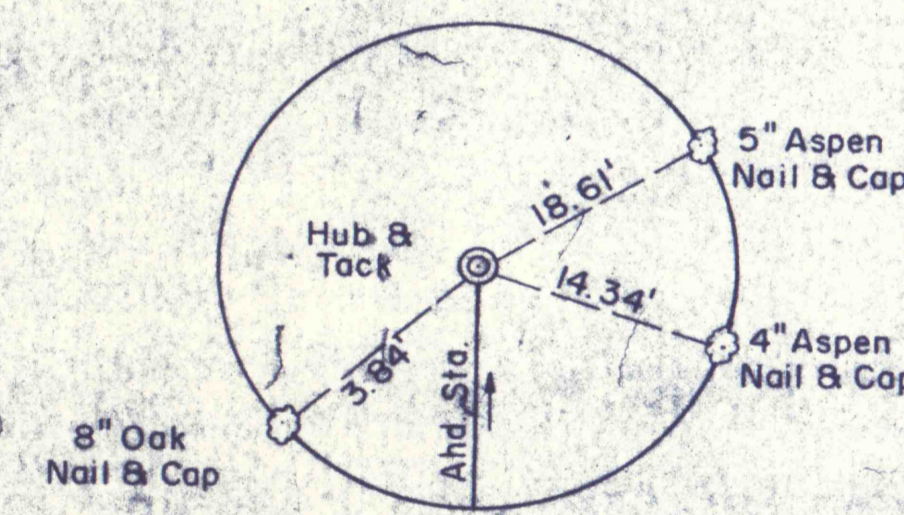


STA. C-8+31 \mathbb{E}

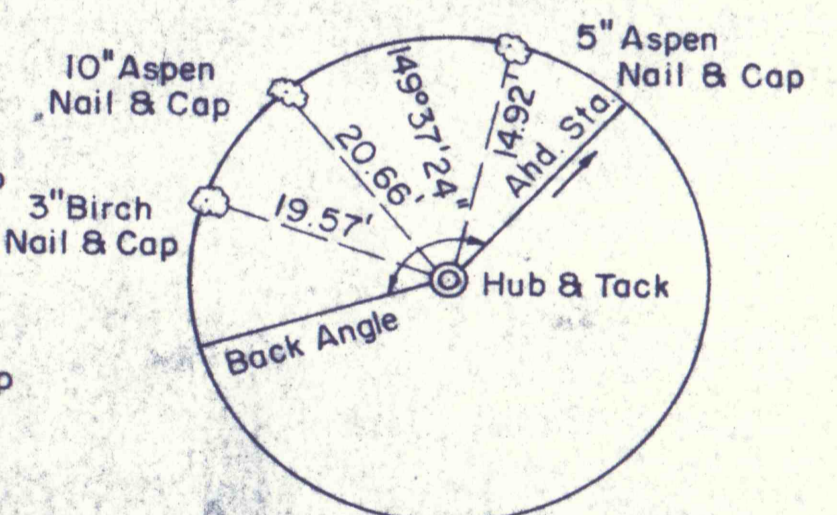


STA. D-0+00 \mathbb{E} =
STA. 43+00 \mathbb{C}

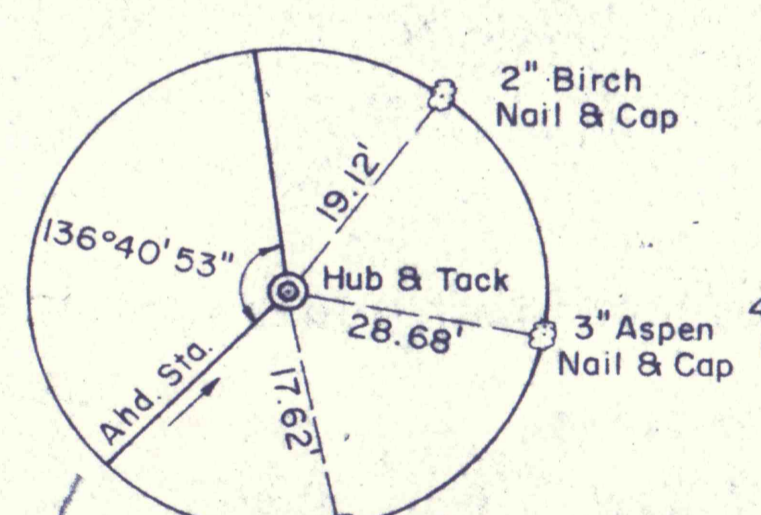


STA. D-6+53 \mathbb{E}

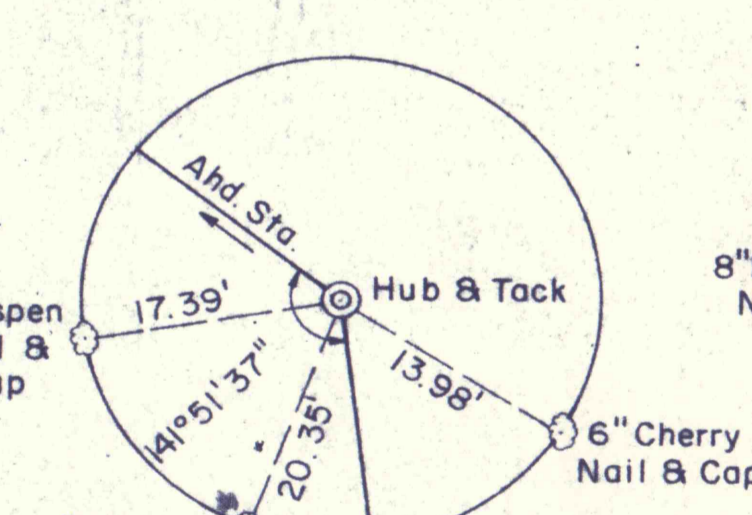

STA. D-8+83 \mathbb{E}

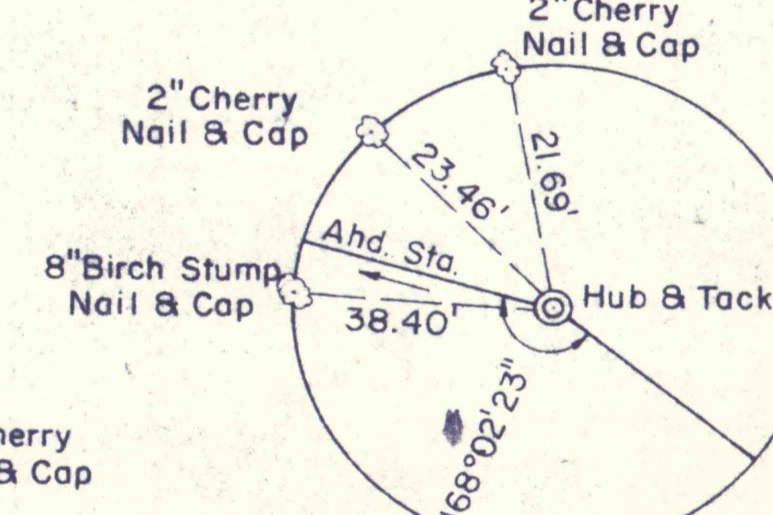


STA. D-12+67 \mathbb{E}

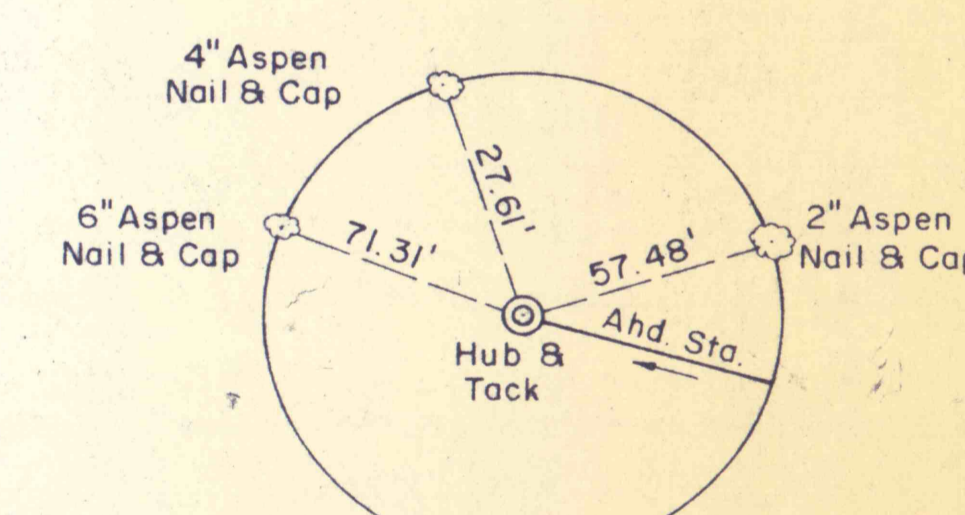

STA. D-17+51 \mathbb{E}

NO	DATE	REVISION	APPR
SUBMITTED			
<i>Richard B. Ulp</i>			
APPROVED			
<i>Robert C. Pomeroy</i>			
CHIEF - DIVISION OF MINE RECLAMATION			
APPROVED			
<i>Robert C. Pomeroy</i>			
DIRECTOR - BUREAU OF DESIGN			

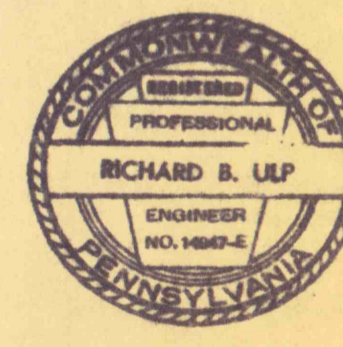

COMMONWEALTH OF PENNSYLVANIA
DEPARTMENT OF ENVIRONMENTAL RESOURCES
OFFICE OF RESOURCES MANAGEMENT
PROJECT NO. SL 113-5-1
MINE DRAINAGE POLLUTION ABATEMENT
COAL RUN
SHAMOKIN CREEK WATERSHED
NORTHUMBERLAND COUNTY, PA.

ERDMAN, ANTHONY, ASSOCIATES
Consulting Engineers
Camp Hill, Pa. Rochester, N.Y.

REFERENCE TIES

DRAWN BY	DATE	DRAWING NO.
GMS	5-9-75	
CHECKED BY	SCALE	
DHC	NO. SCALE	