


NORTH
STRAIGHT

A

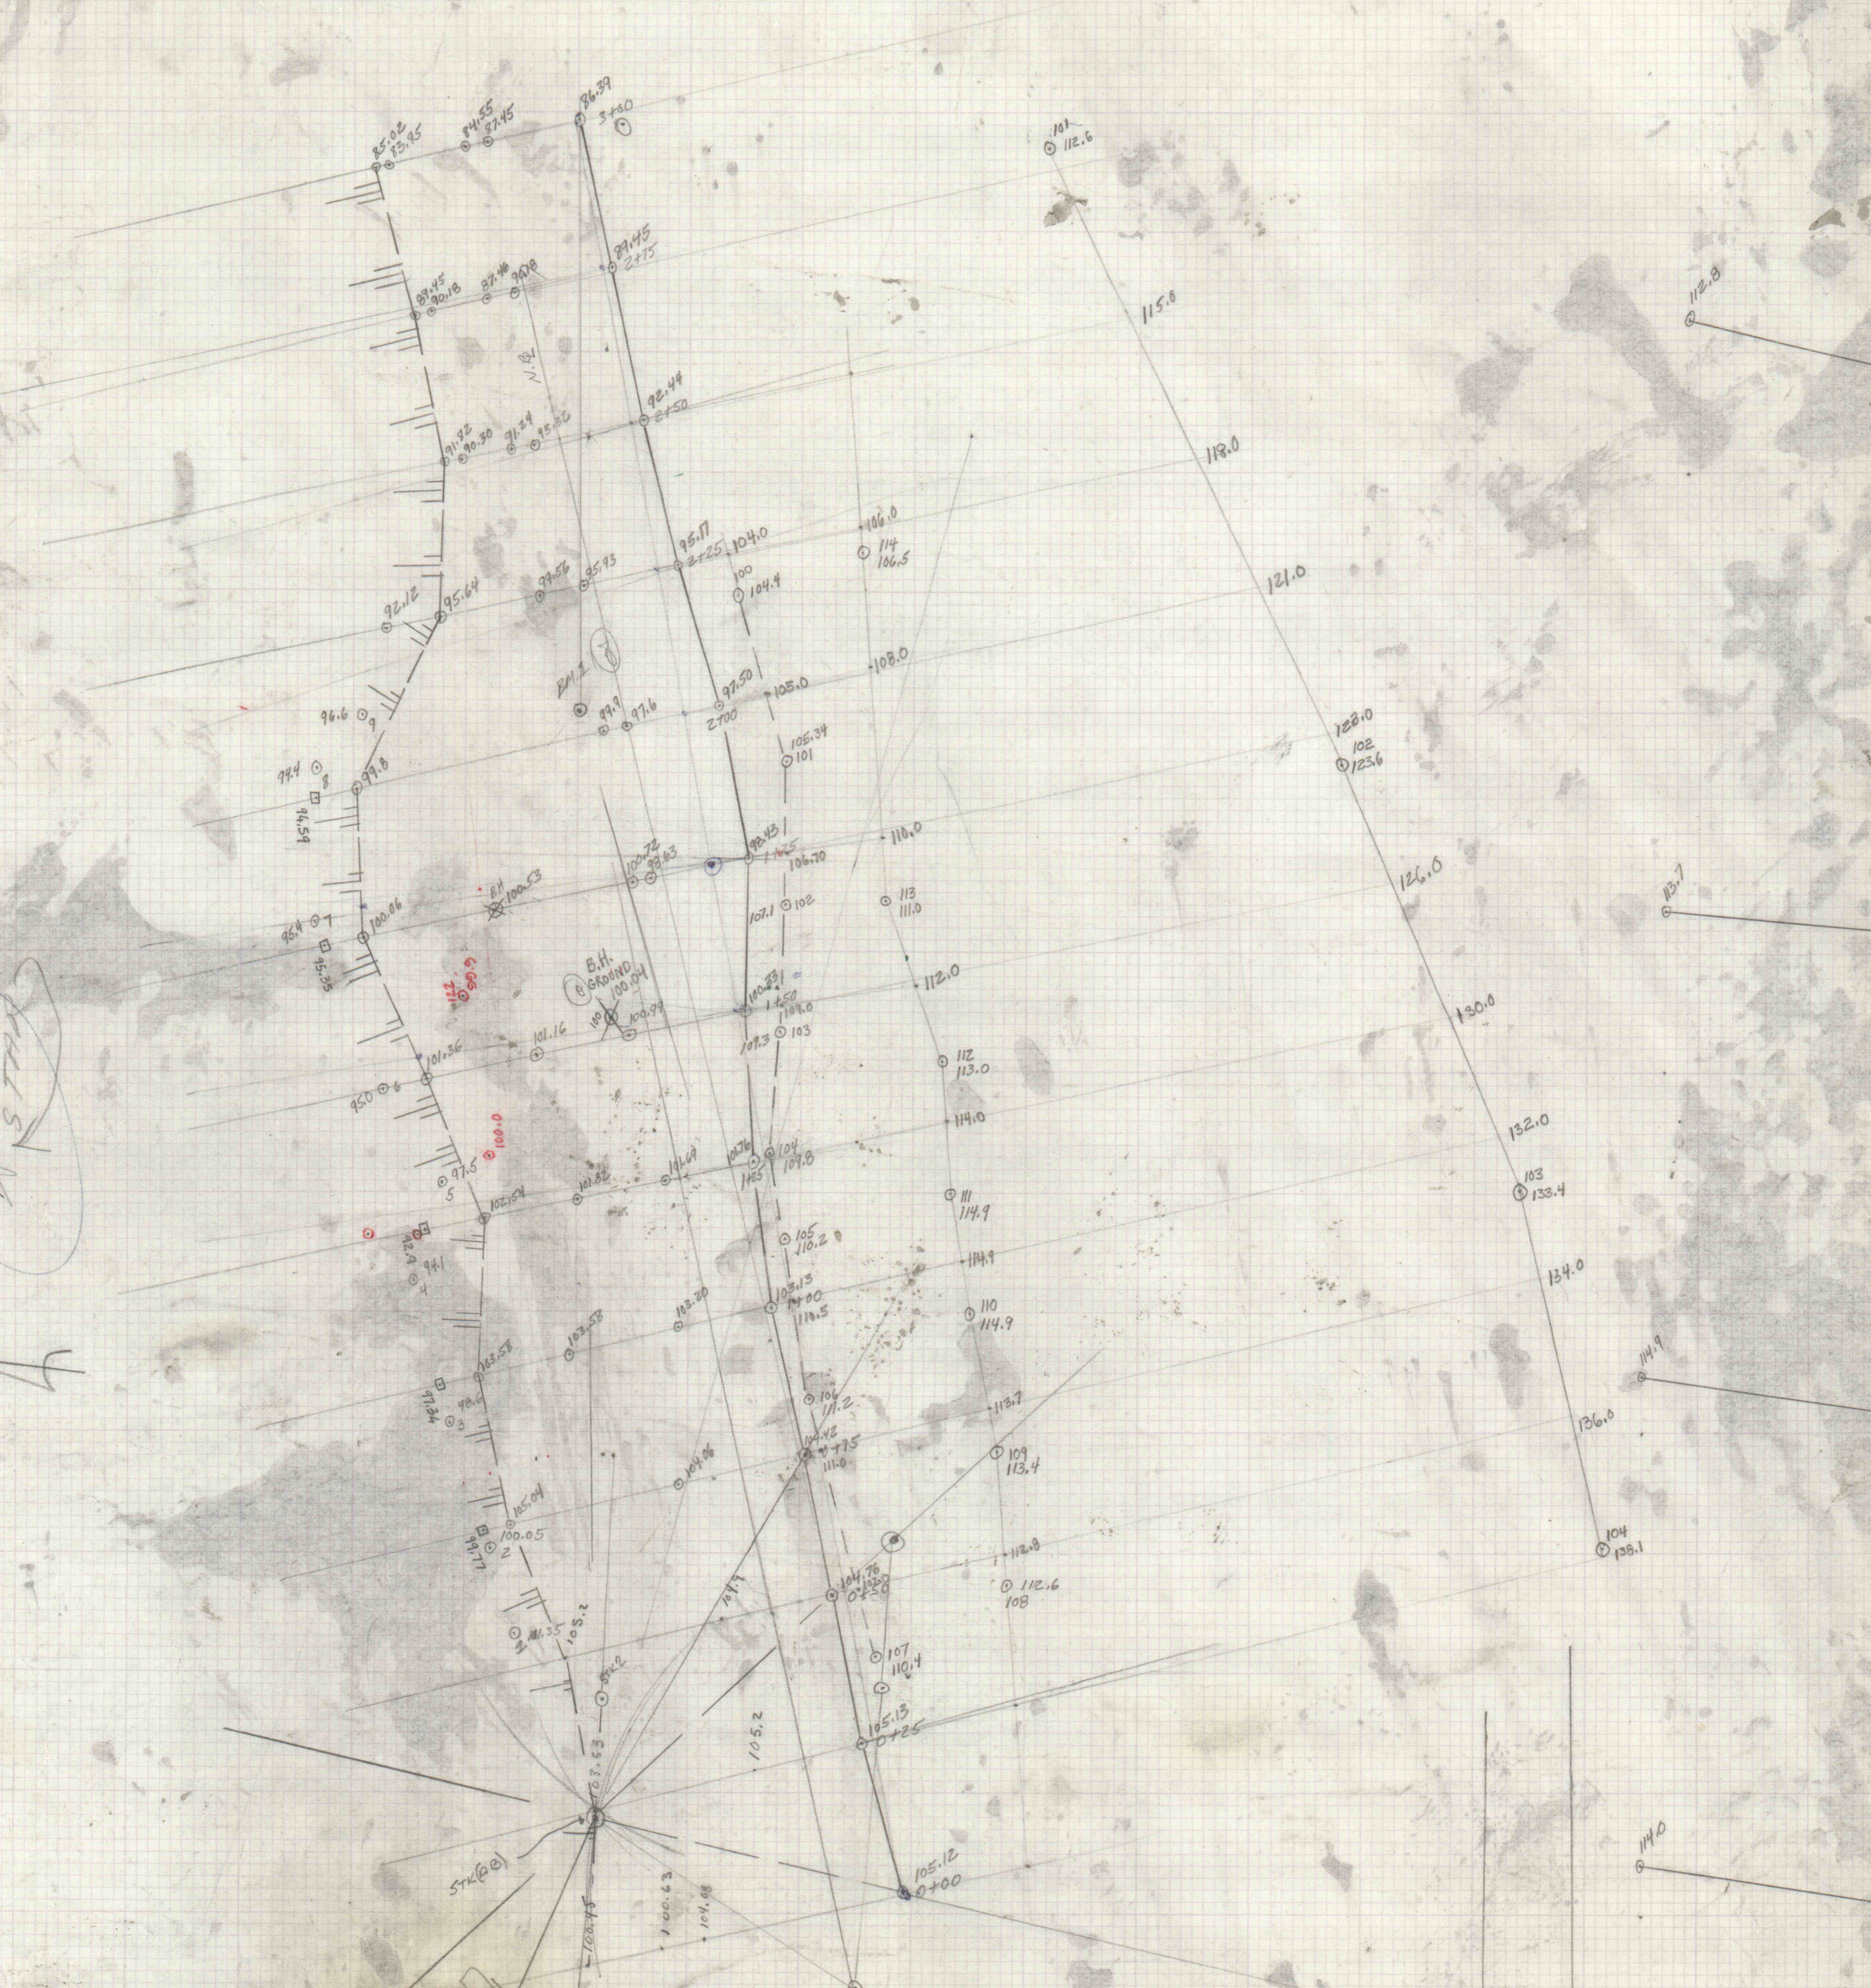

SCALE 1"=20'
4-20-78

HEGINS MINING CO.
X-SECTIONS

MWC-48

TOPO
ORIGINAL SURVEY

56.1