


RANSHAW DRAINAGE DITCH

PROFILE

SCALE { 1" = 50' HOR.
1" = 10' VERT.

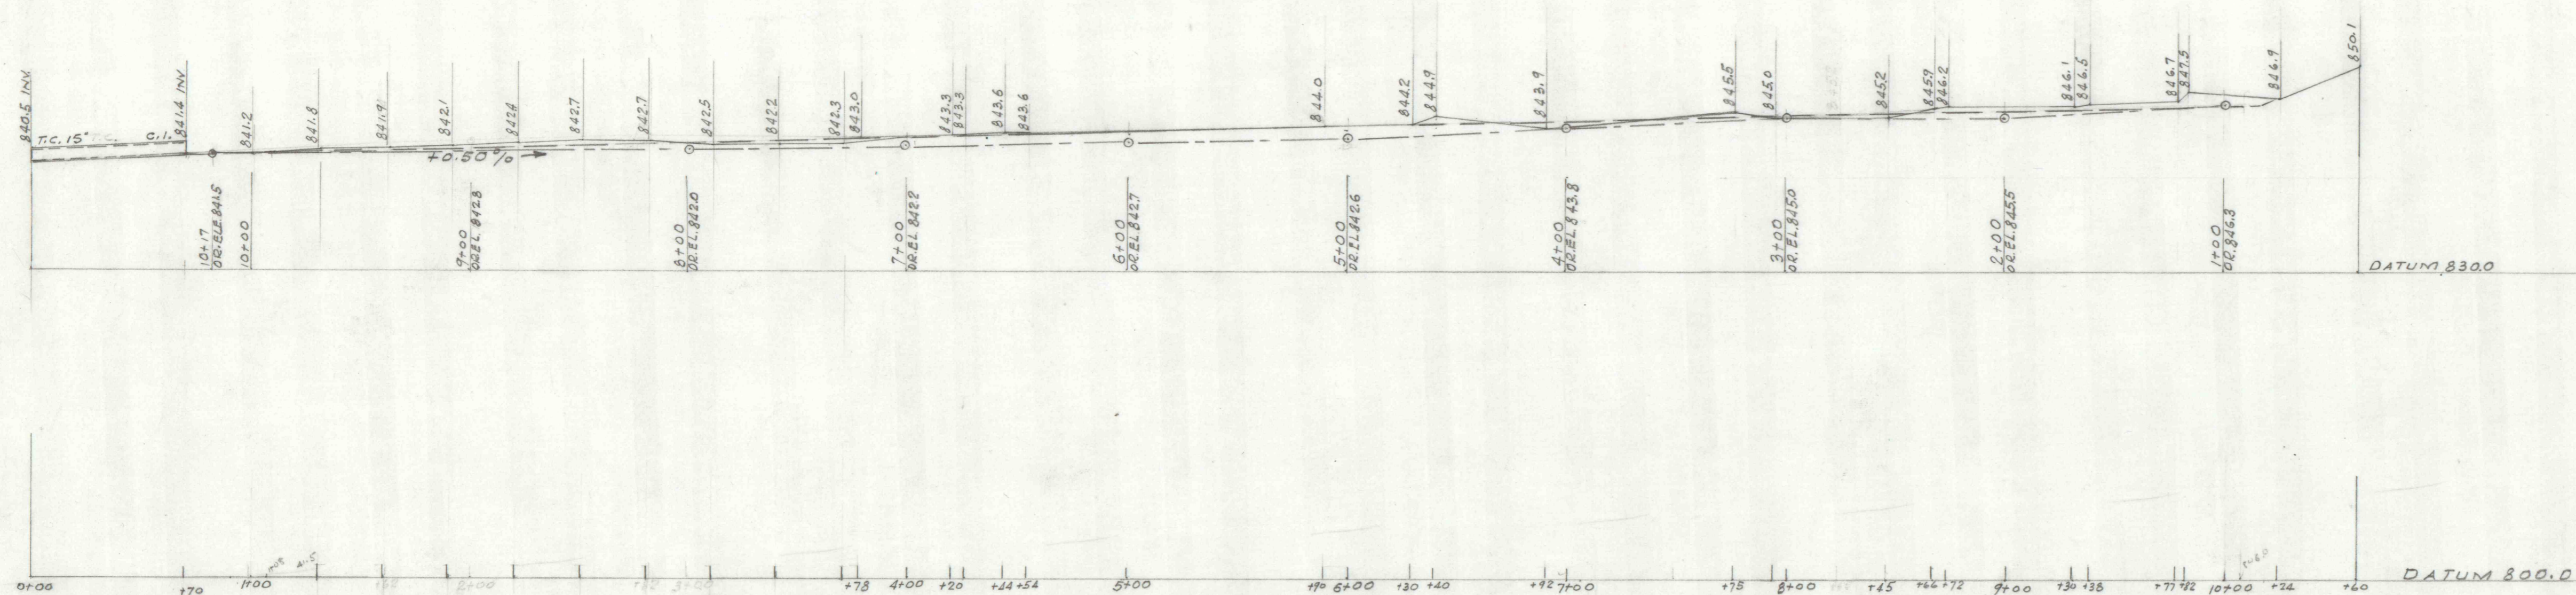

RANSHAW DRAINAGE DITCH

PROFILE

SCALE { 1" = 50' HOR.
1" = 10' VERT.

APRIL 1968

LEGEND

- PROPOSED GRADE
- PRESENT GRADE
- — ○ GRADE AT COMPLETION OF CONTRACT