


STEEL SHORING

DREW DEVELOPMENT CO. POTTSVILLE, PA.

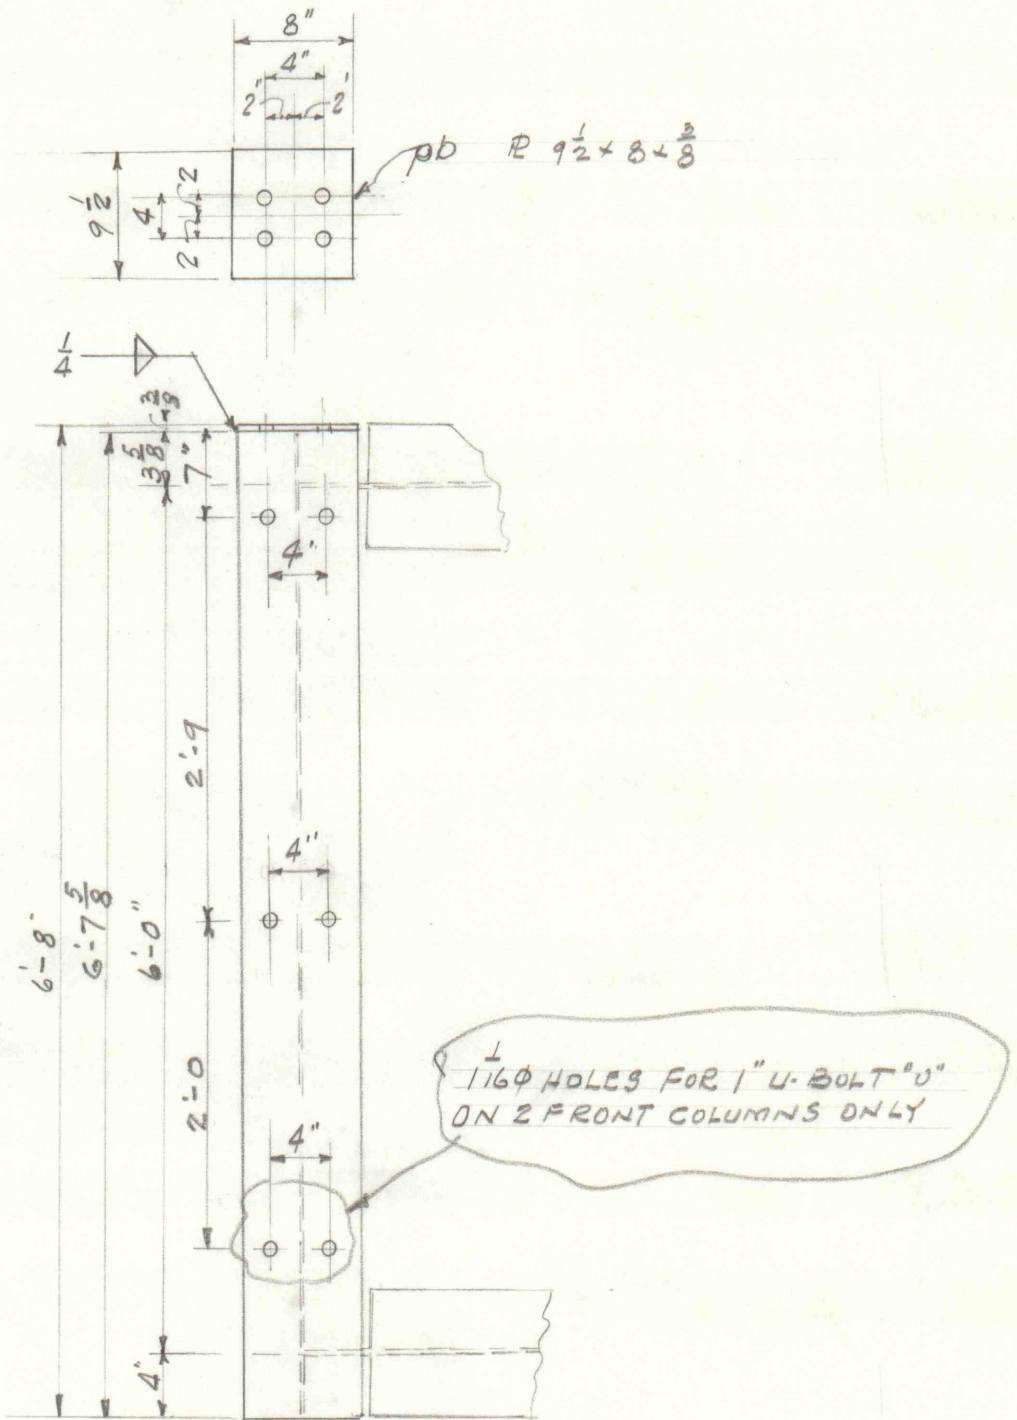

MARK 'B' MAKE 6 - 10WT 39 x 6'-7 5/8" LONG

ALL HOLES 13/16" EXCEPT AS NOTED

ALL BOLTS 3/4" EXCEPT AS NOTED

1 SHOP COAT

DEC. 29 - 1969