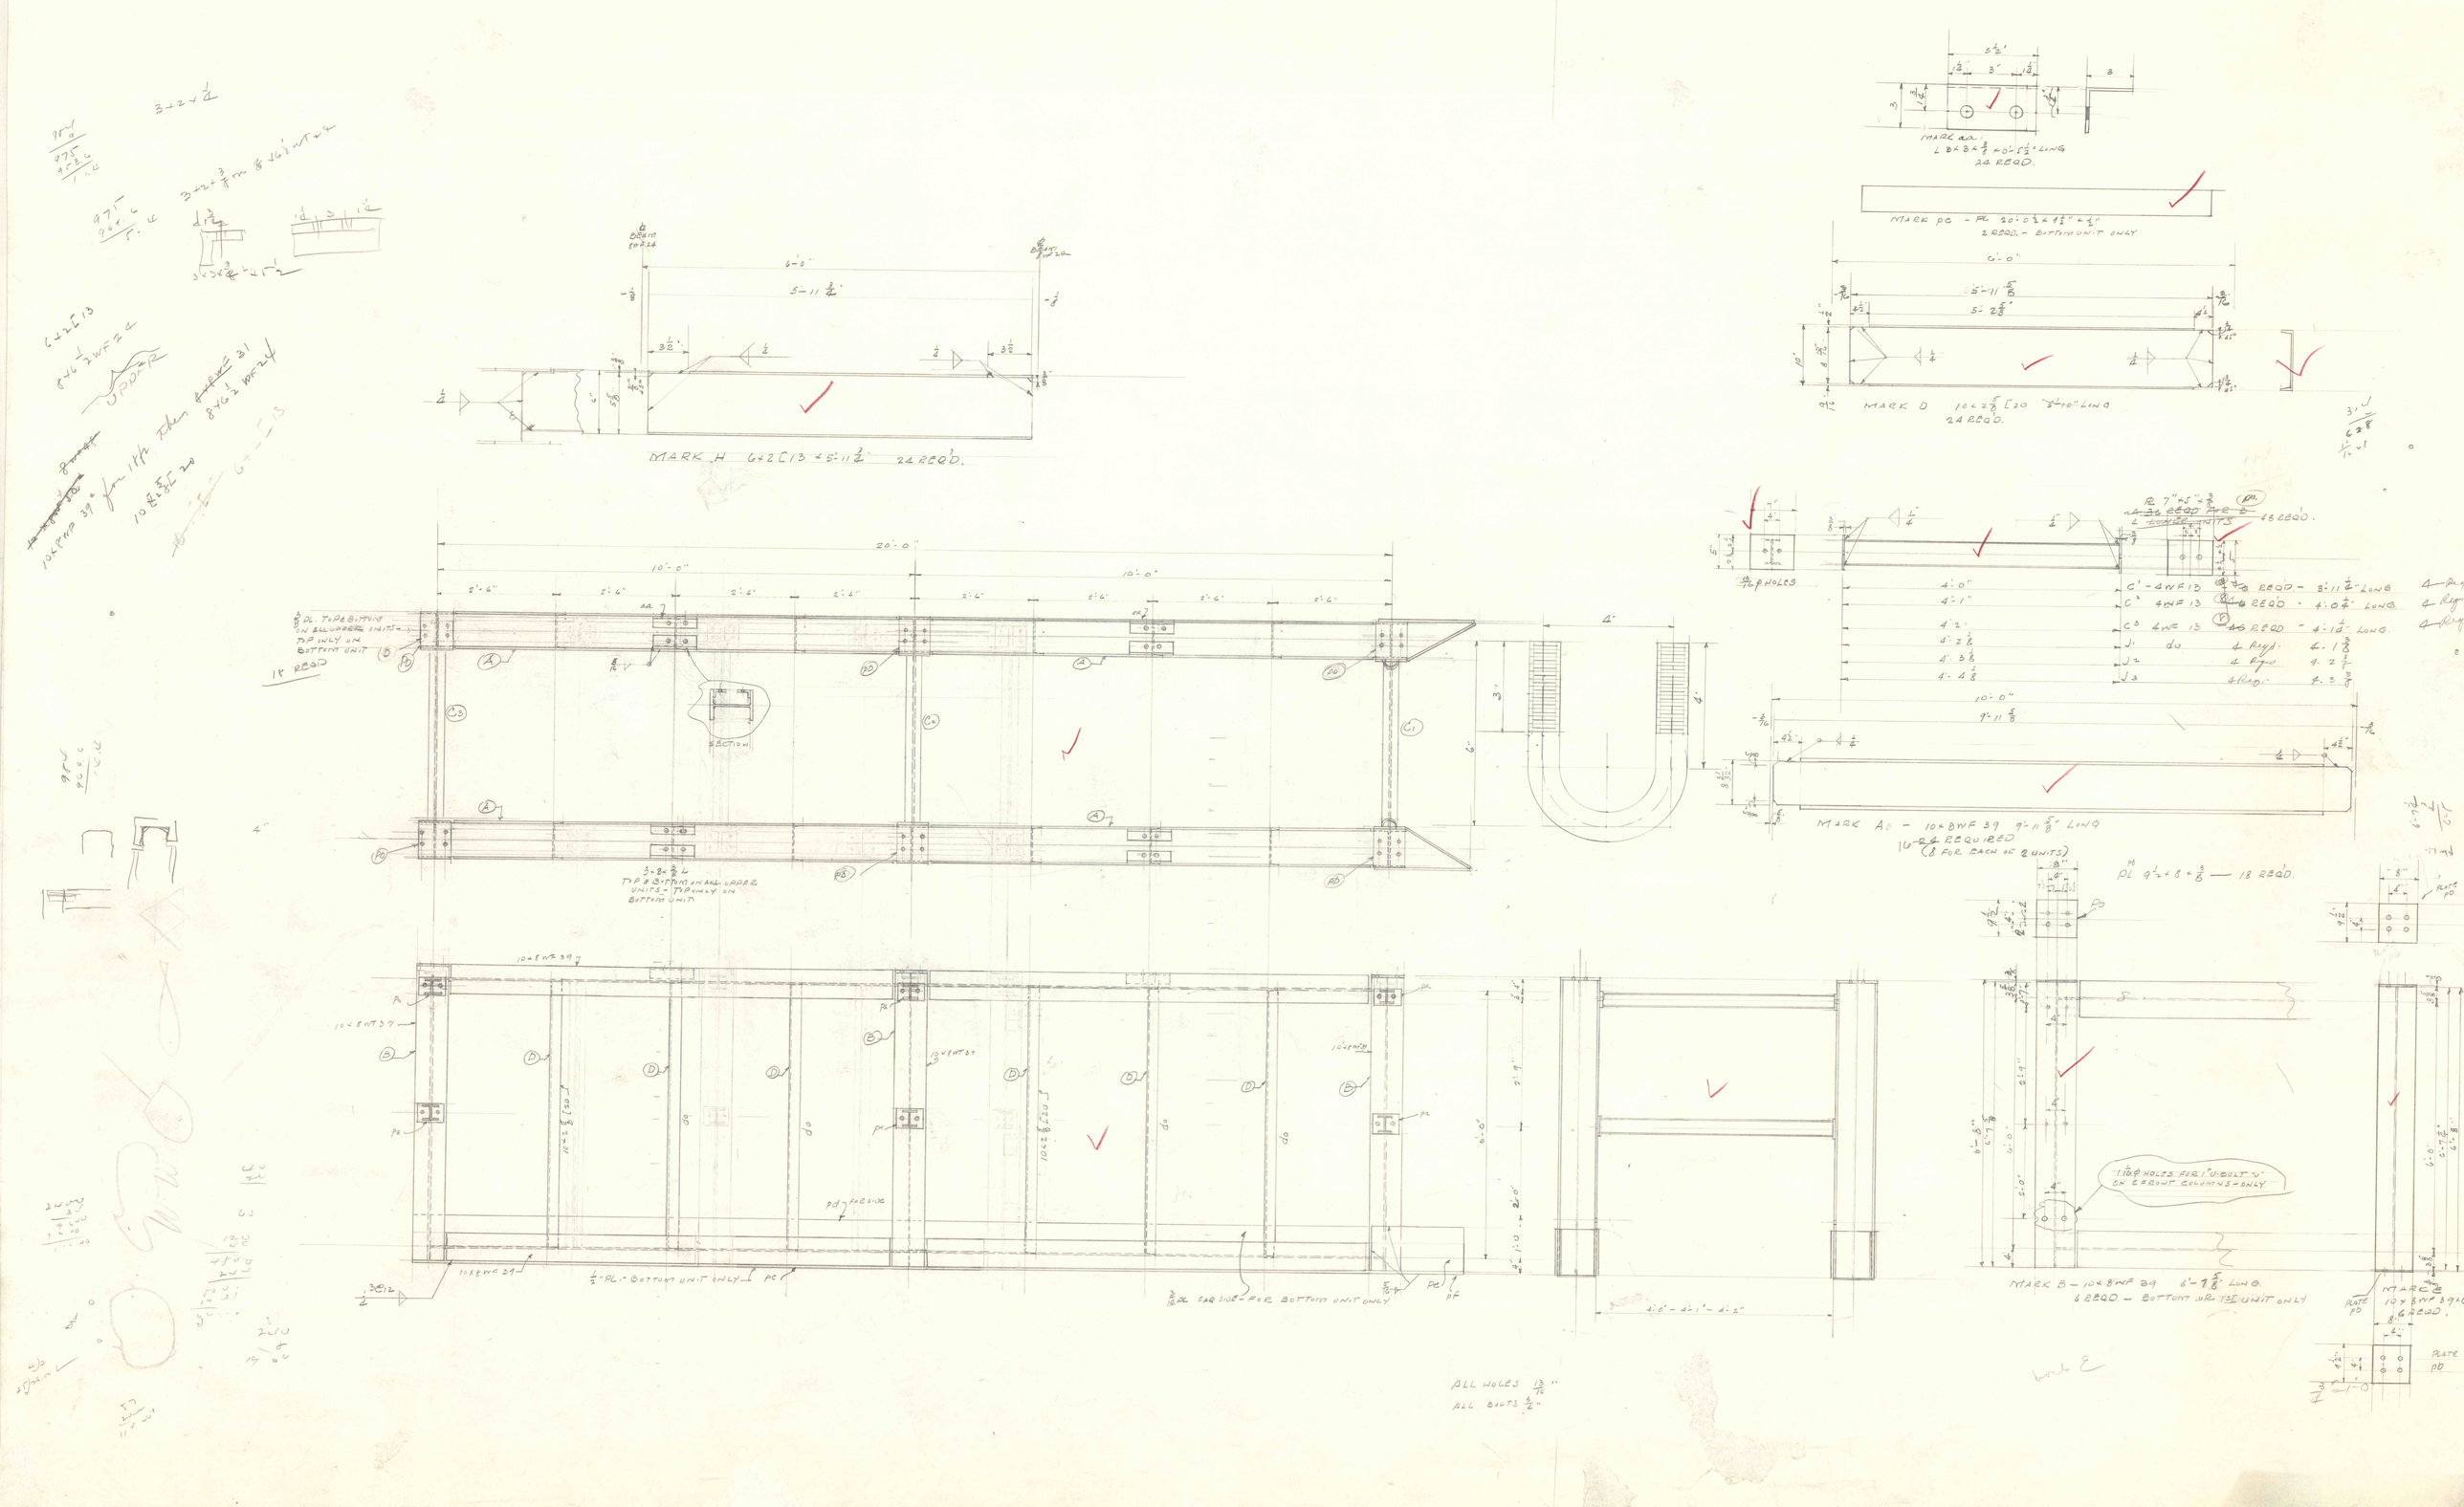
MARK H 6×2[13 × 5'-11 3/4" 24 REQ'D.
MARK D 10×2 5/8 [20 5'-10" LONG 24 REQ'D.
MARK A - 10×8WF 39 9'-11 5/8" LONG
16-24 REQUIRED (8 FOR EACH OF 2 UNITS)
MARK B - 10×8WF 39 6'-7 5/8" LONG. 6 REQ'D. - BOTTOM OR 1ST UNIT ONLY
MARK E 10×8WF 39 6 REQ'D.
ALL HOLES 13/16"
ALL BOLTS 3/4"