


BUCK RIDGE WORKINGS

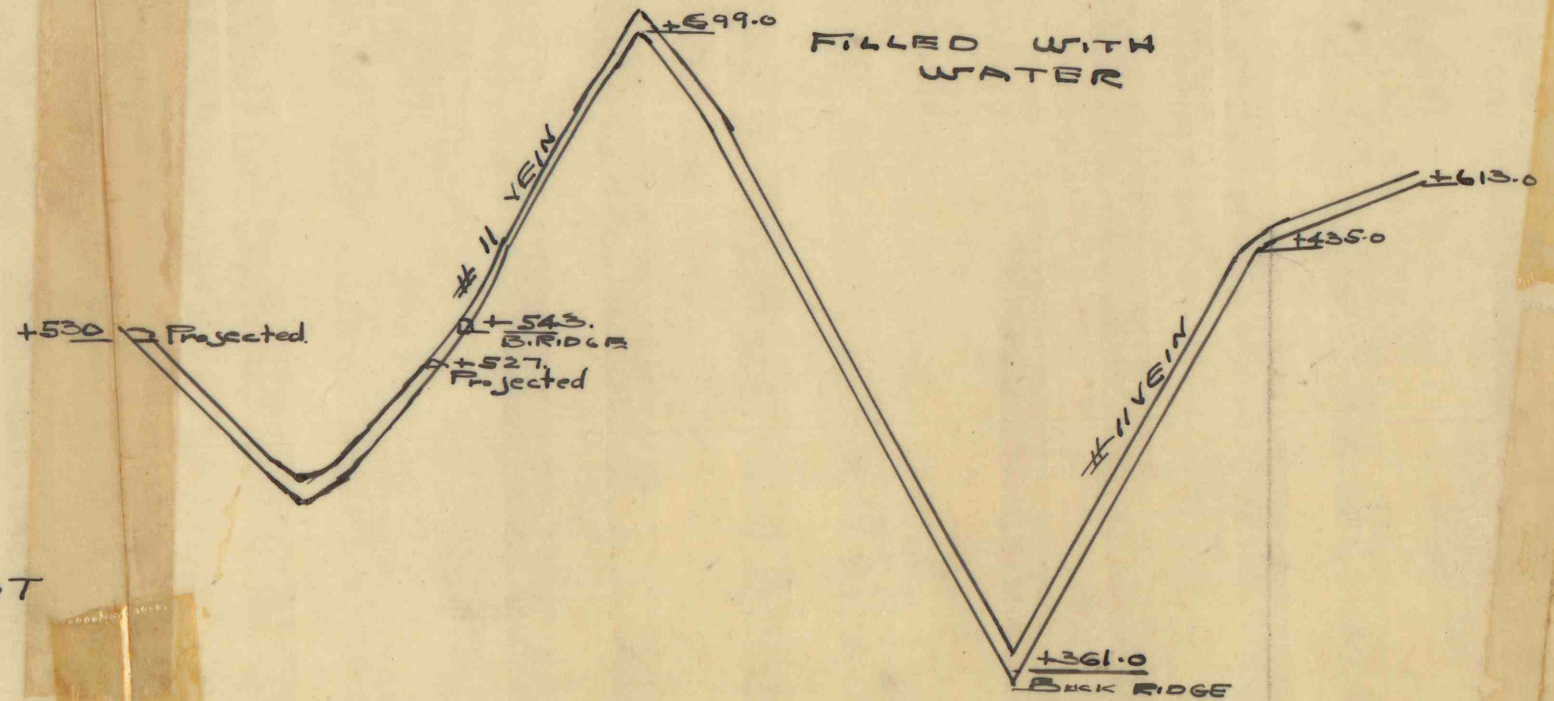

LOOKING WEST

DATUM +300.0

SECTION THRU #11 VEIN MINE
 WORKINGS BUCK RIDGE COLLY.
 RANSHAW, PA. SCALE 1" = 100'