



LUKE FIDLER COLLIERY

KIMBER CLEAVER

BUCK RIDGE COLLIERY


JOHNSTON & RENSHAW

JOHN BRADY

JOHNSTON & RENSHAW

FULTON LANDS

AIN COLLIERY

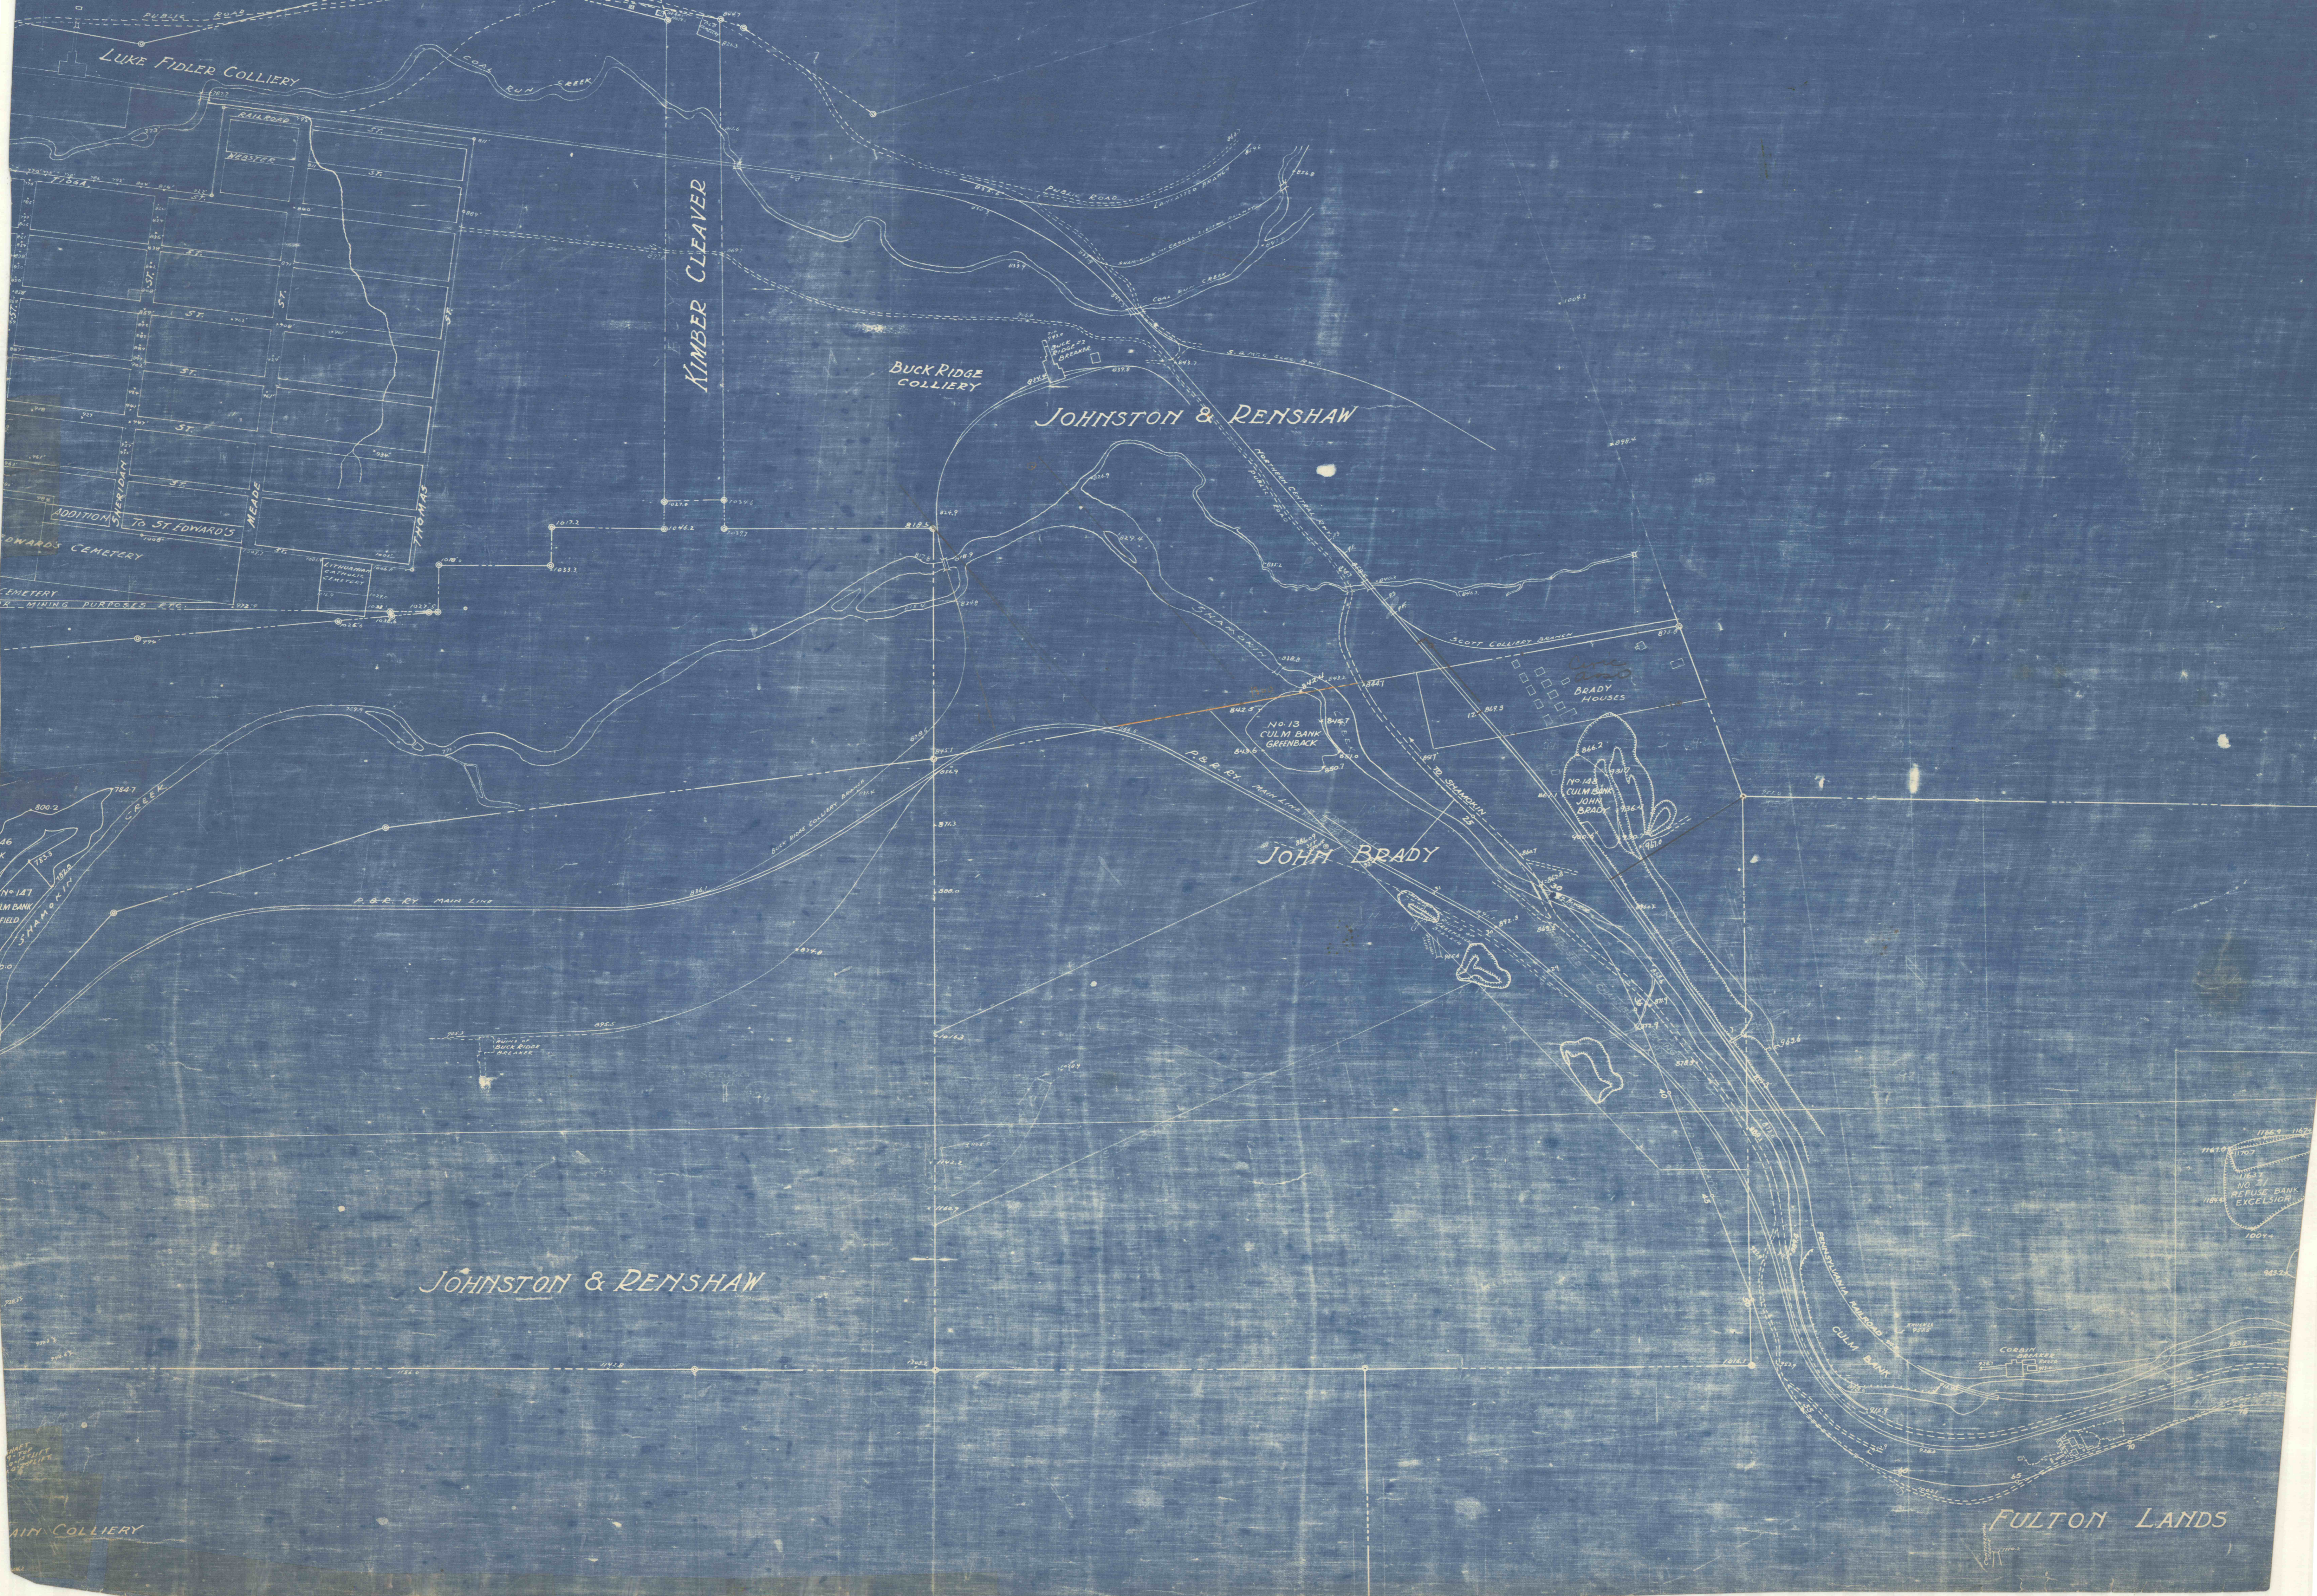

0816.00
1123.00



1786.00
1787.00
