DISTRICT	COUNTY	ROUTE	SEC	SHEET
3	NORTHUMBERLAND & COLUMBIA	161	12	7 of 9

MT CARMEL Township
CONYNGHAM Township

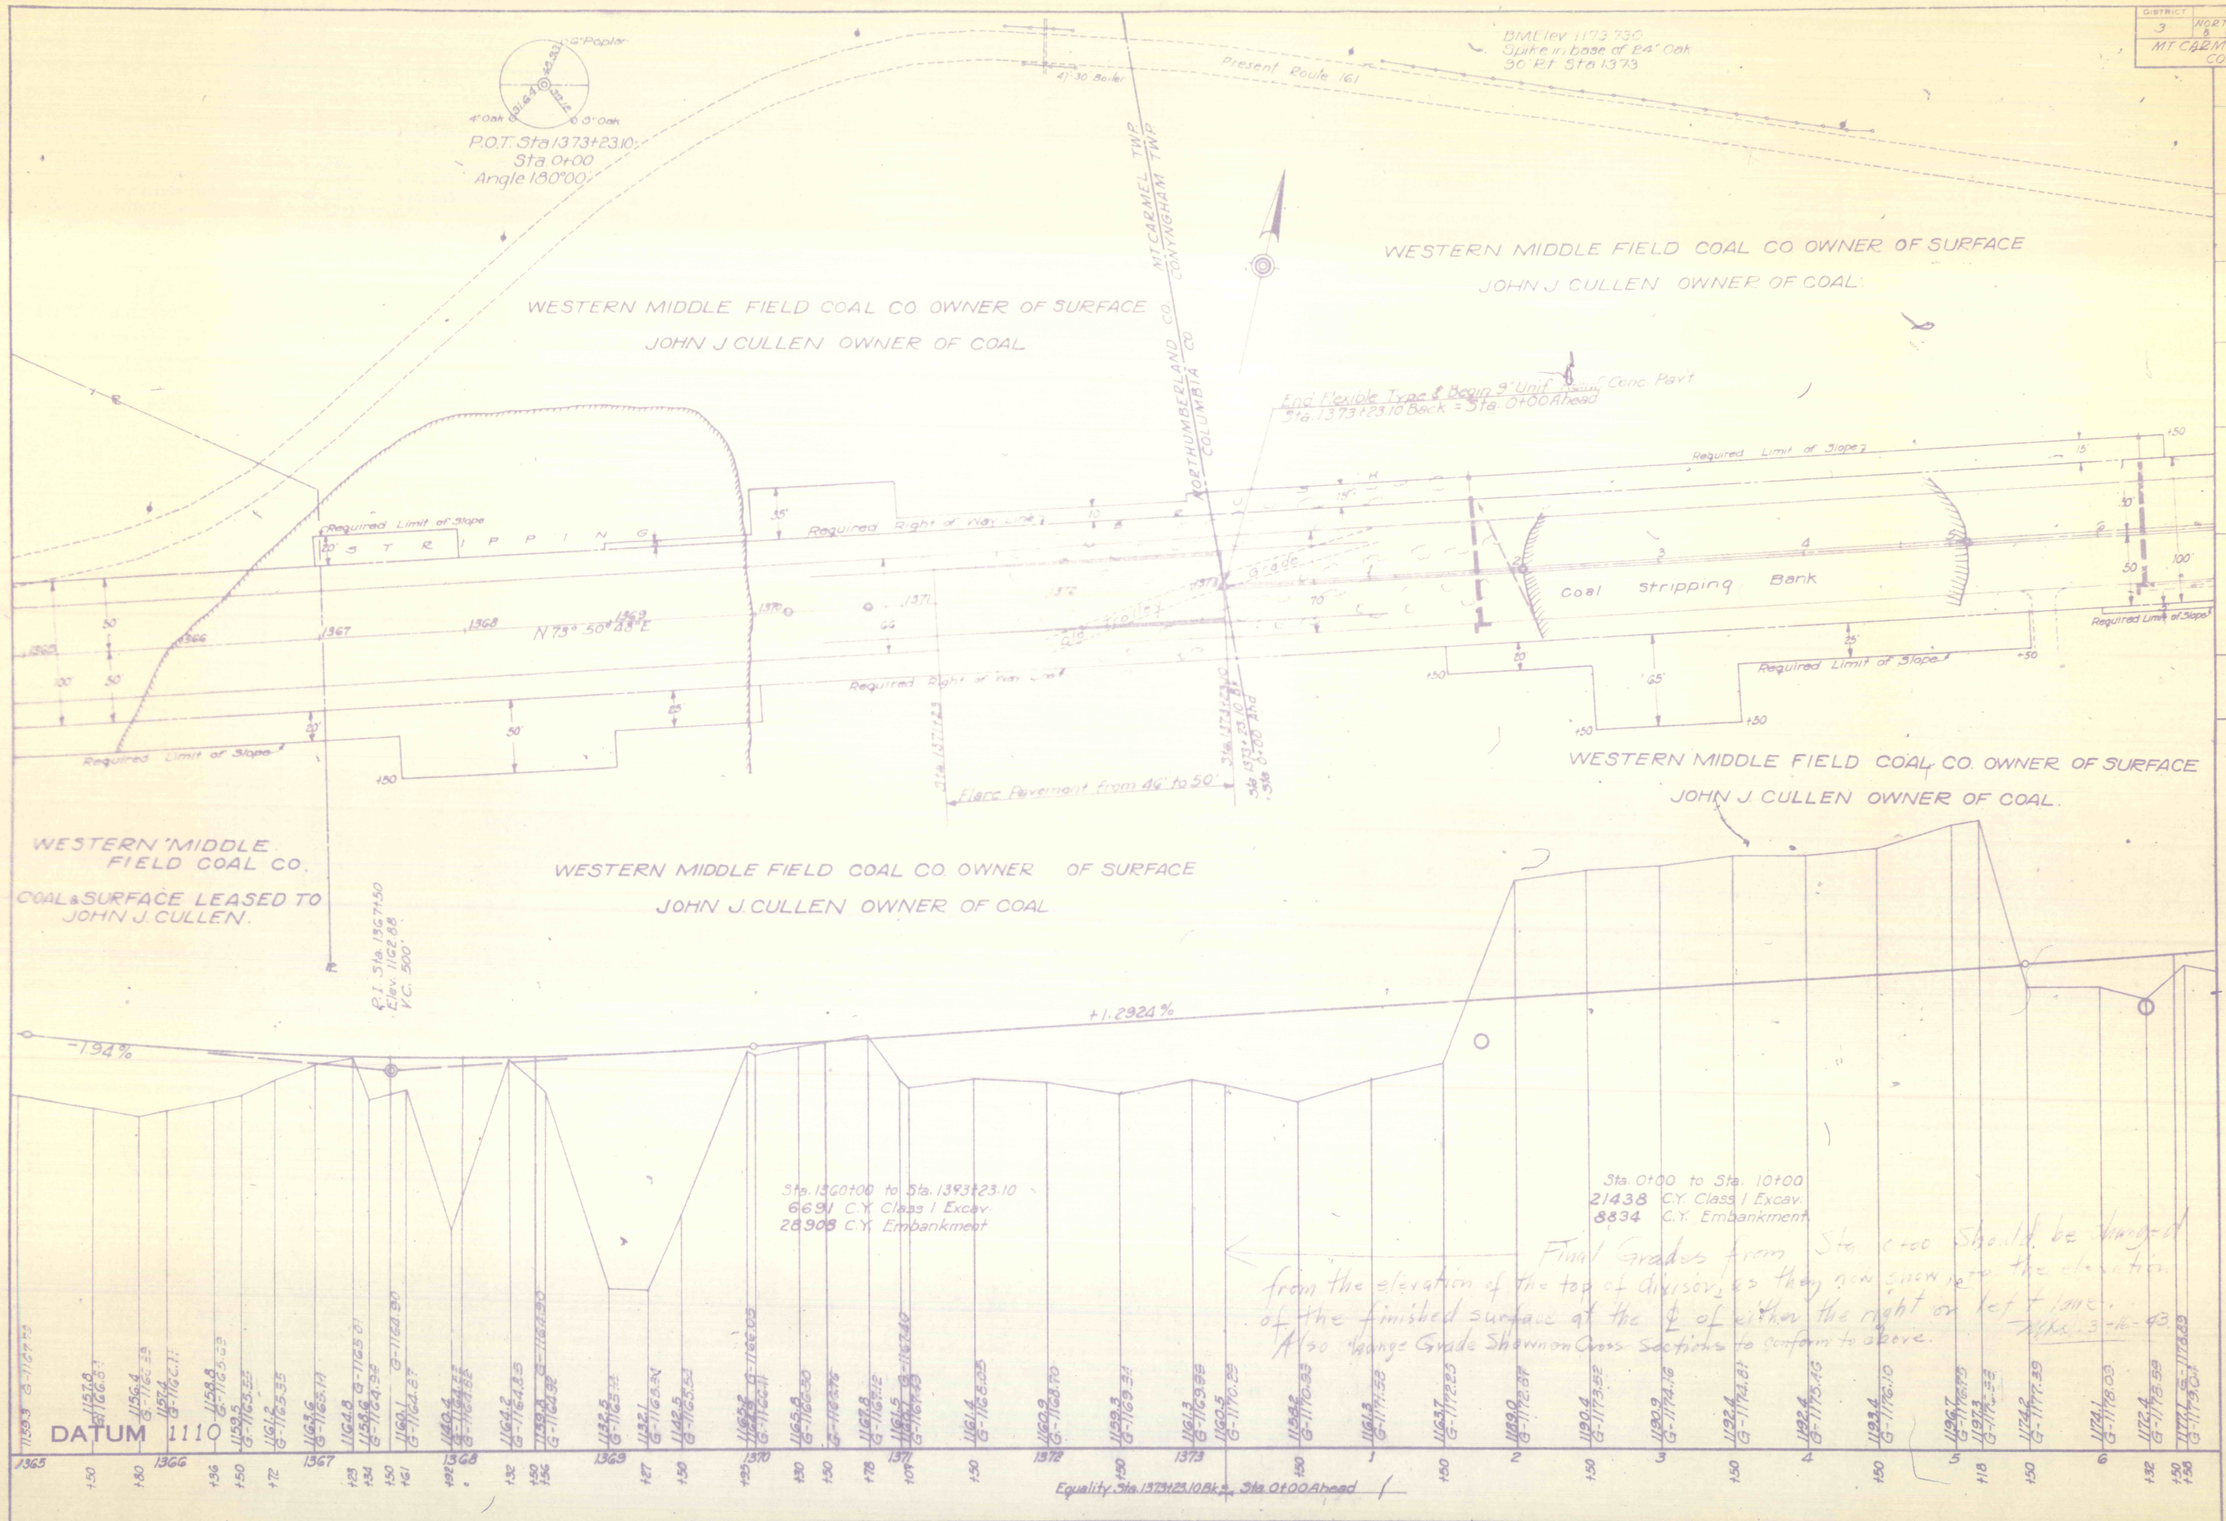

REQUIRED LIST

Sta. 1+75
88'-24" R.C.P.
"E" Endwall Rt.

Sta. 5+60
Grade Drive Rt. (16' Wide)
3 C.Y. Class I Excav.

Sta. 6+32
64'-18" R.C.P.
"E" Endwall Rt.

Sta. 1371+23 to Sta. 1373+23
Flare Pavt. Pt & Lt. 46' to 50'
44.0 S.Y. 10" N.S.B.C. (Type "A") or C.A.B.C.
5 Tons - 2" Bit. Surf. Course HE-1

Sta. 2+00
54'-6" Tile Foundation
Underdrain Type "A"
15'-6" Tile Outlets.

Sta. 0+00 to Sta. 21+62.14
Divisor Area (See Sheet No. 2)
4328 Lin. Ft. Spec. Integral Curb
721 Sq. Yds. 8" N.S. Type "B" or C.A.B.C.
30 Tons B.S.C. HE-6