Western MIDDLE FIELD

STANTON & LAWRENCE COLLIERIES

MAP OF FOUR FOOT & LEADER VEIN UNDER FOUR FOOT.

SCALE - 100' = 1"

HARLEIGH-BROOKWOOD COAL CO.
MAHANOY PLANE, PA.
WEST MAH. TWP. SCHUYLKILL COUNTY.
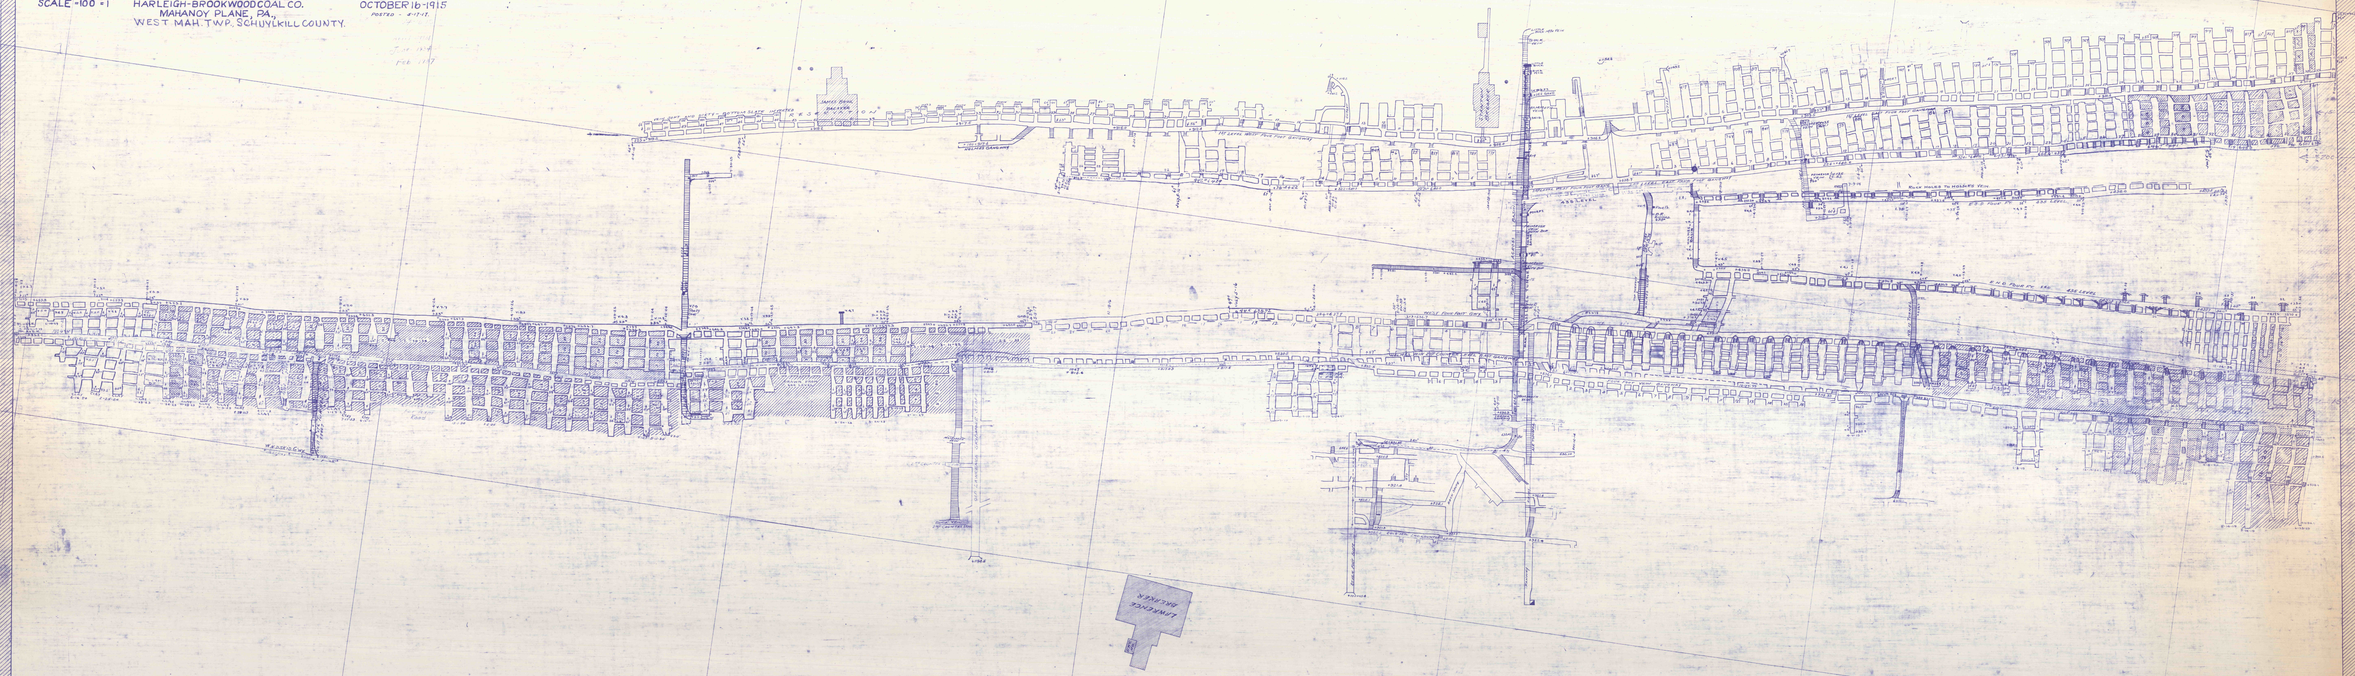
OCTOBER 16-1915