EAST BEAR RIDGE LEASE

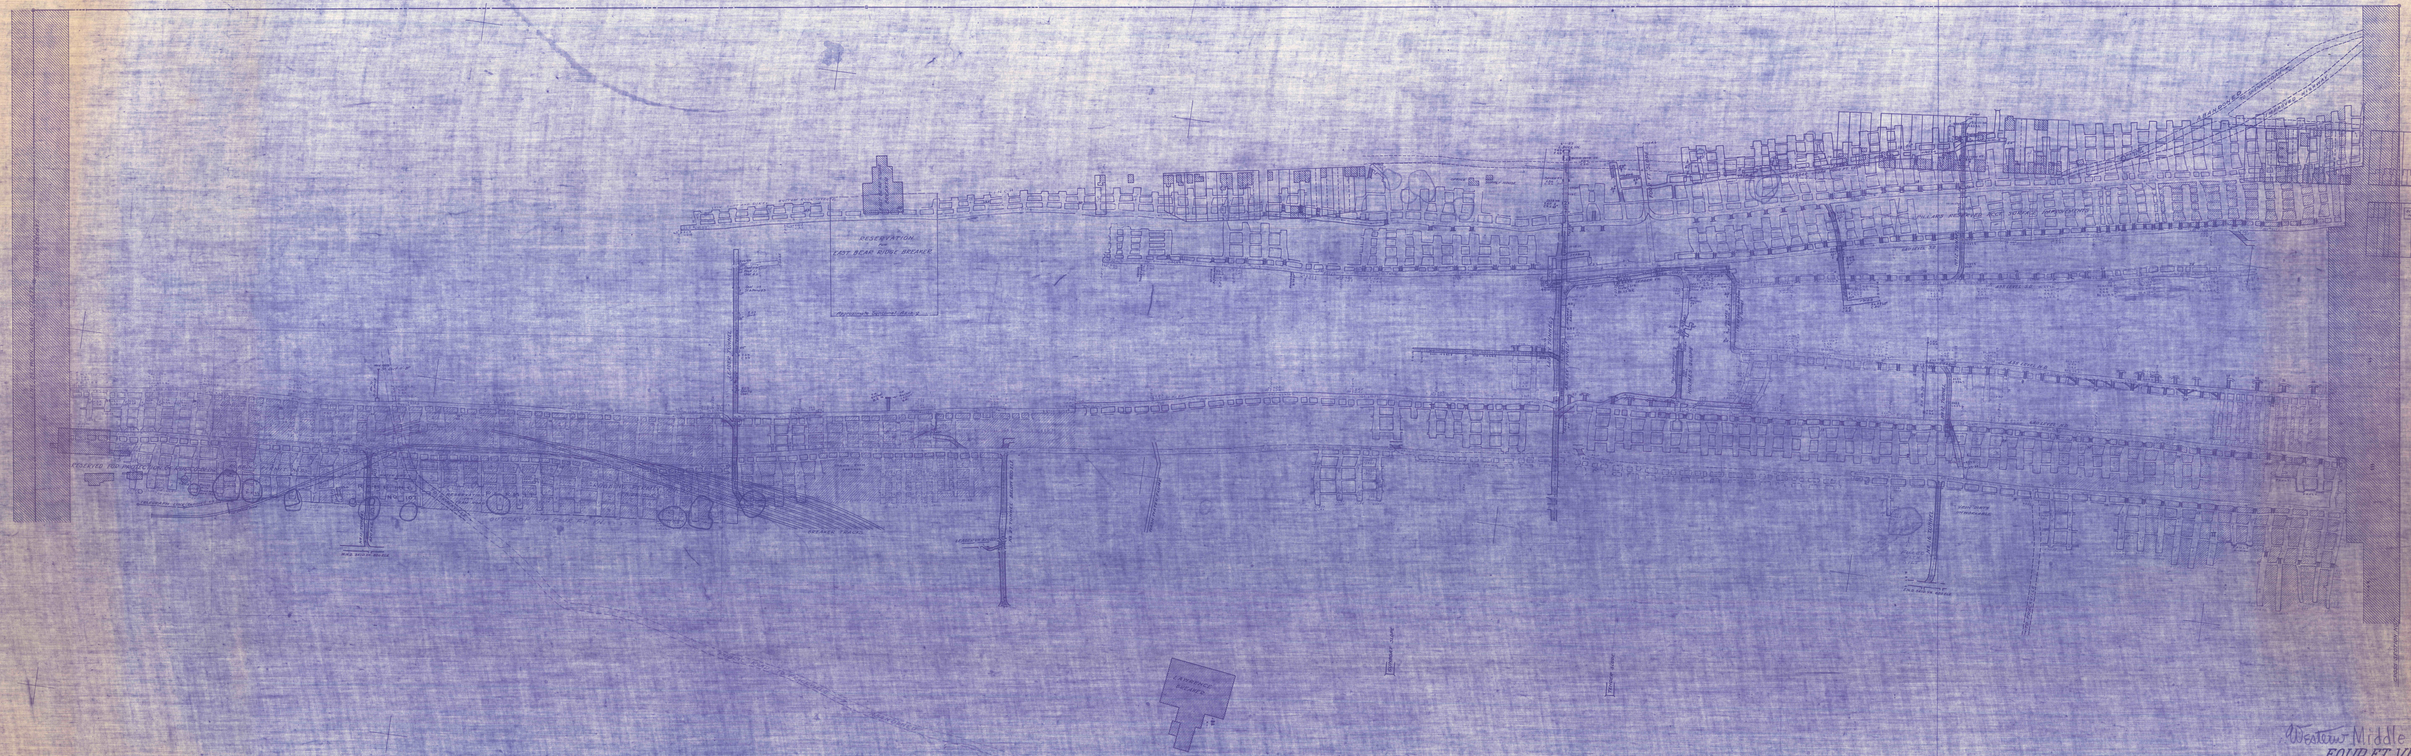

Western Middle Field
FOURTH VEIN
W. MAHANOY TWP. SCHUYLKILL Co., PA.
LAWRENCE COLLIERY
HARLEIGH-BROOKWOOD COAL COMPANY
FRACKVILLE, PA.
SCALE 1in.=100ft. JUNE 2, 1924
PLOTTED TO

TAG: L-11