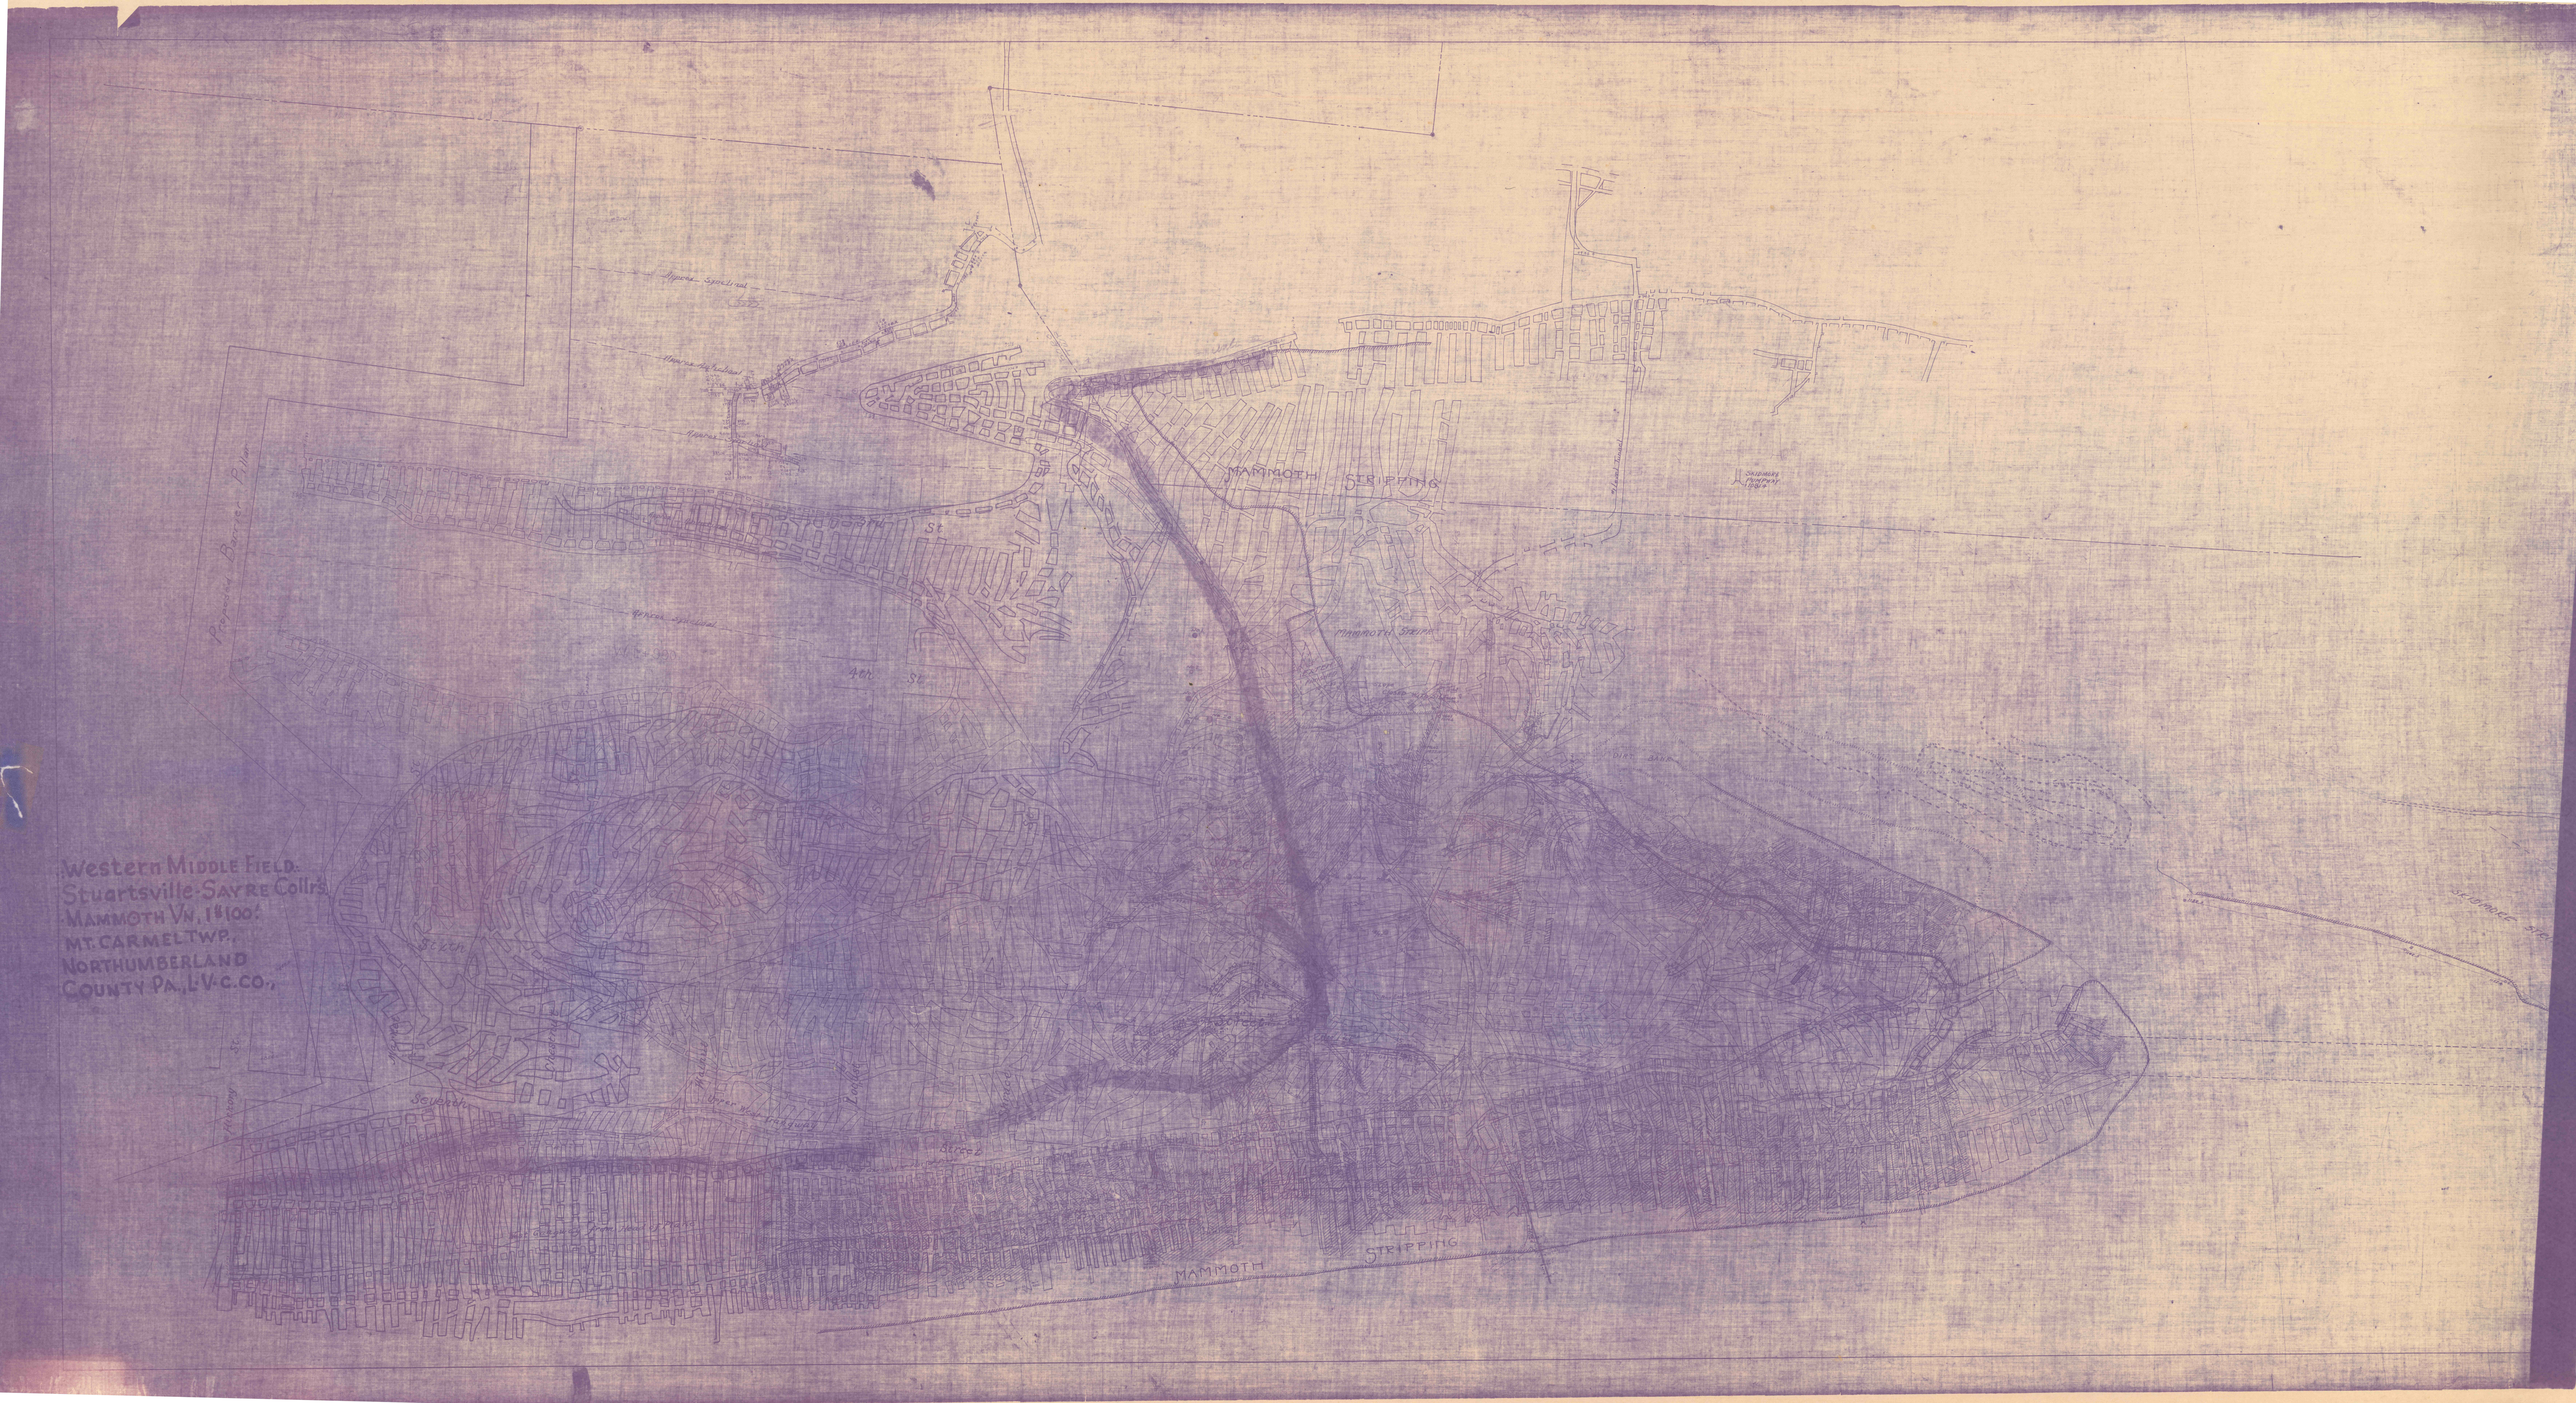
Western Middle Field.
Stuartsville-Sayre Coll'rs.
Mammoth Vn. 1"=100'
Mt. Carmel Twp.,
Northumberland
County Pa., L.V.C.Co.,
MAMMOTH
STRIPPING
MAMMOTH
STRIPPING