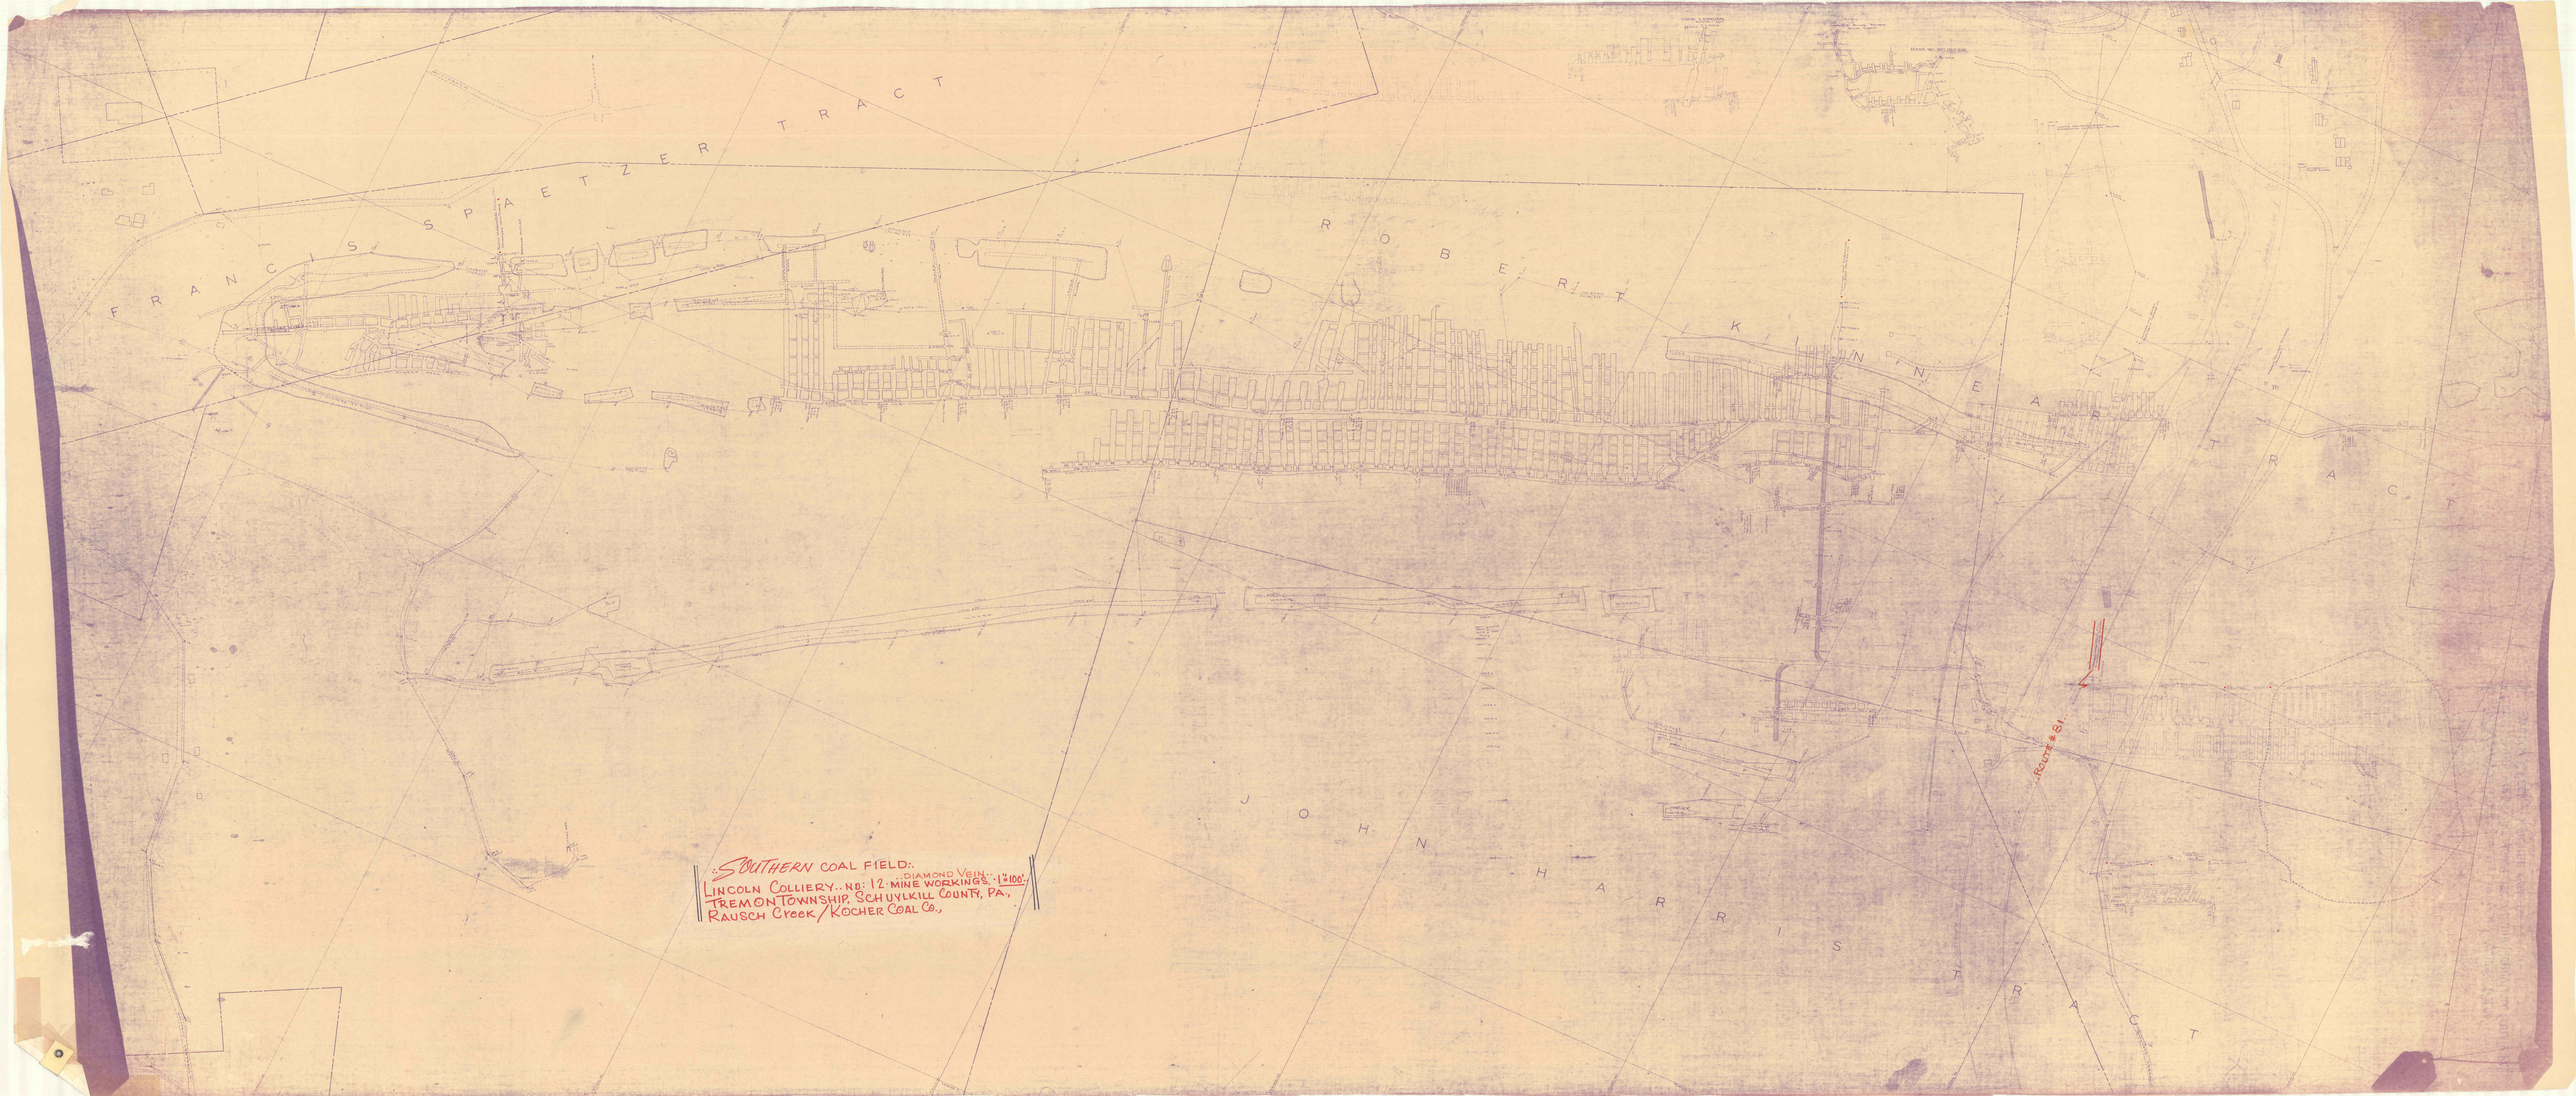
FRANCIS SPAETZER TRACT
ROBERT KINNEAR TRACT
JOHN HARRIS TRACT
ROUTE # 81
SOUTHERN COAL FIELD:
LINCOLN COLLIERY.. No: 12 MINE WORKINGS.
DIAMOND VEIN
1" = 100'
TREMONTOWNSHIP, SCHUYLKILL COUNTY, PA.
RAUSCH Creek / KOCHER COAL Co.,