KASKA NO. 1 SHAFT

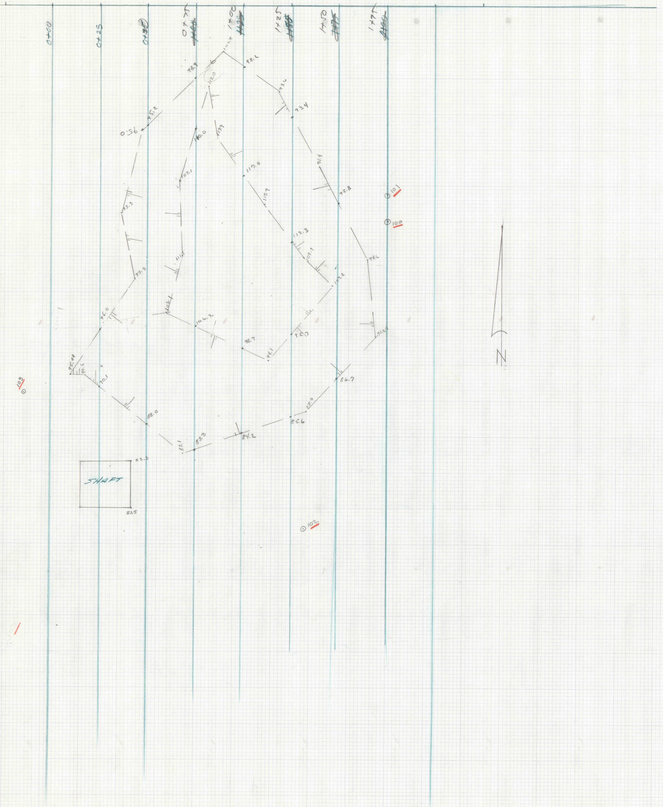


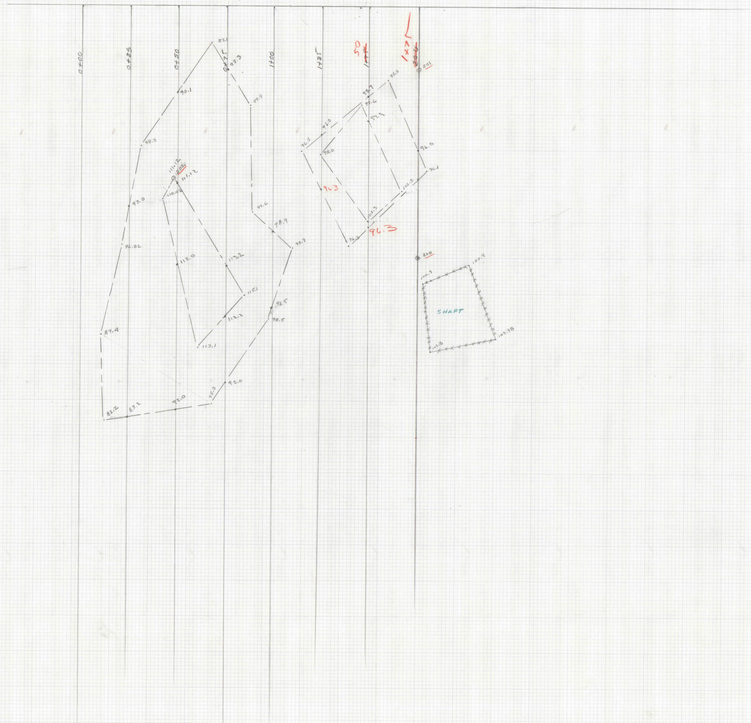


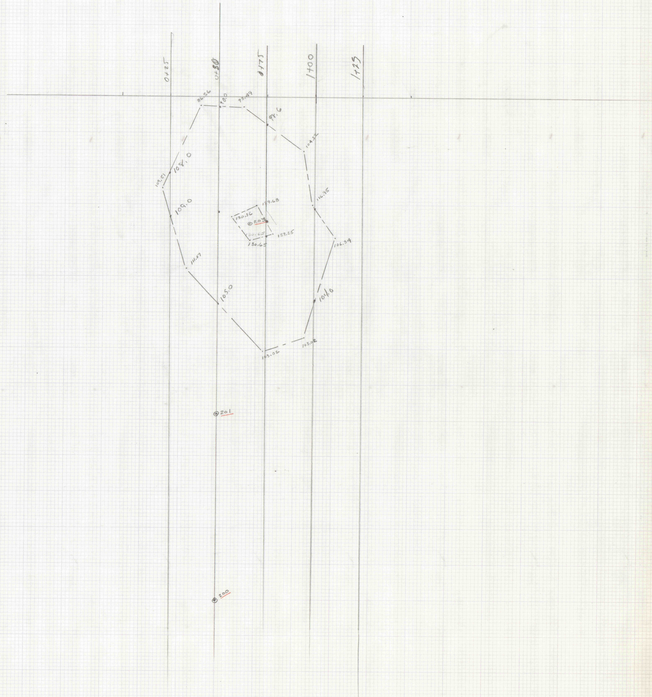

KASKA #1 SHAFT.
KASKA #2 SHAFT
Scale 1" = 20'
4-12-78 PY