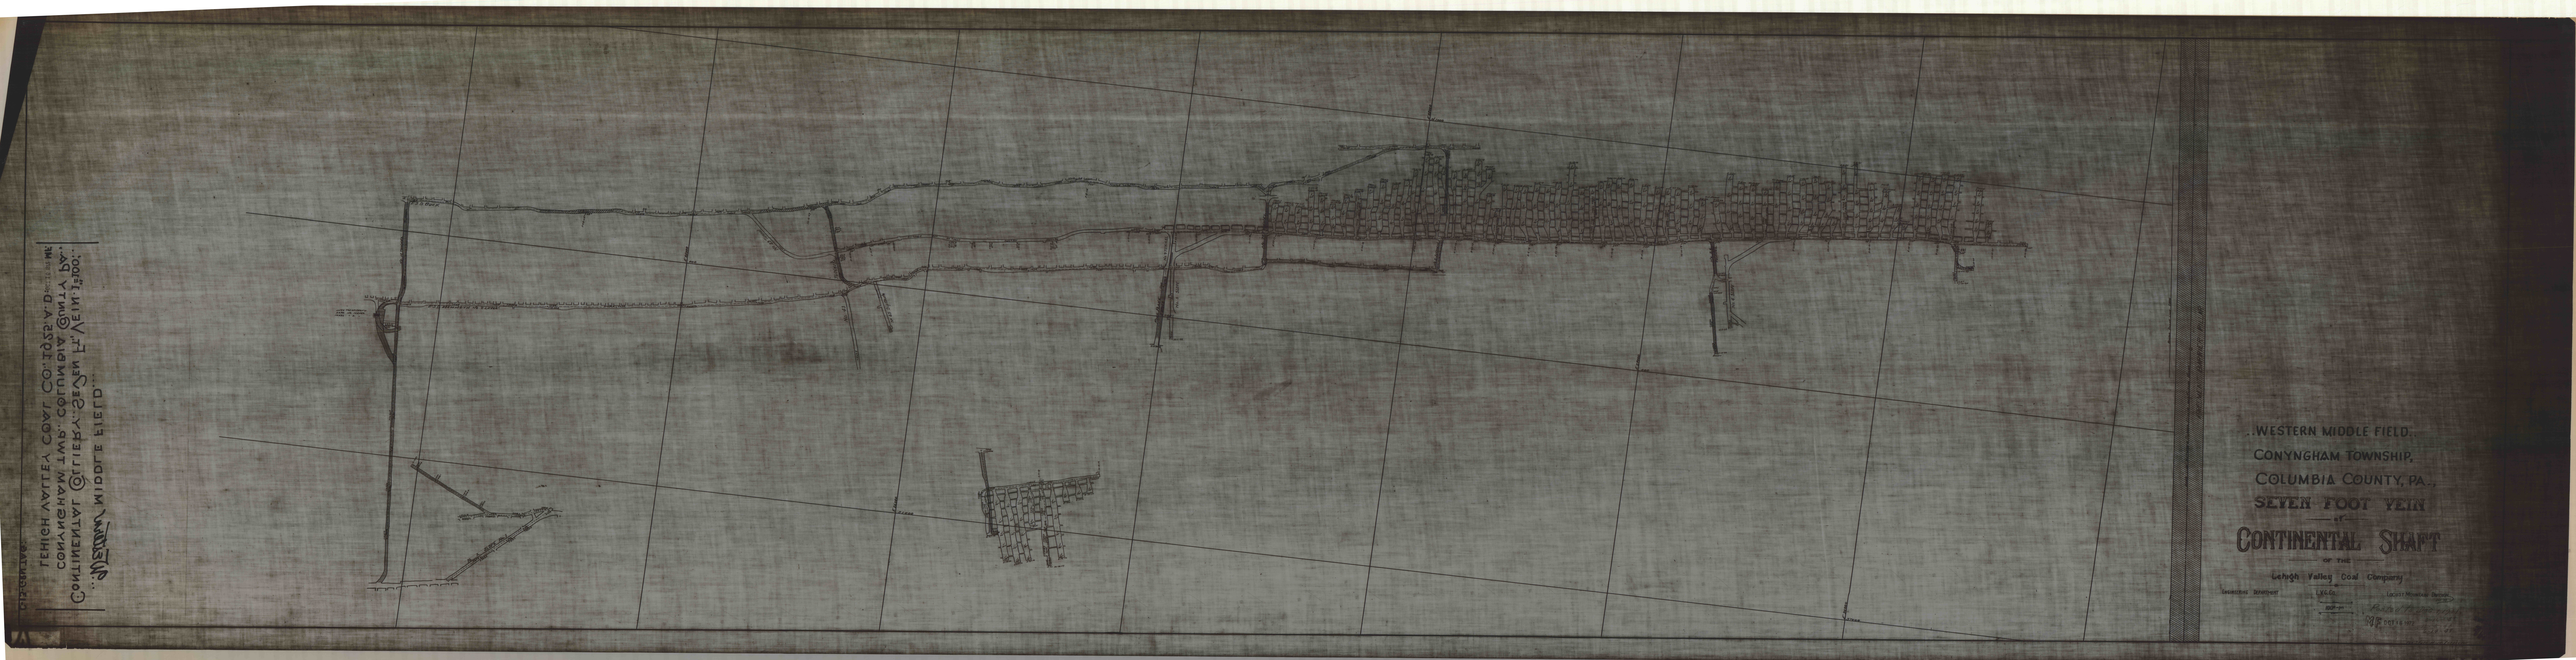
WESTERN MIDDLE FIELD.
CONYNGHAM TOWNSHIP,
COLUMBIA COUNTY, PA.,
SEVEN FOOT VEIN
OF
CONTINENTAL SHAFT
OF THE
Lehigh Valley Coal Company
ENGINEERING DEPARTMENT
LXC Co.
LOCUST MOUNTAIN DIVISION
100 FT.
OCT 16 1877
LEHIGH VALLEY COAL CO. 1925 A.D.
CONYNGHAM TWP. COLUMBIA COUNTY PA.
CONTINENTAL COLLIERY SEVEN FT. VEIN 1=100
WESTERN MIDDLE FIELD