COLUMBIA CO. COMPILED MAP
WESTERN MIDDLE COAL FIELD

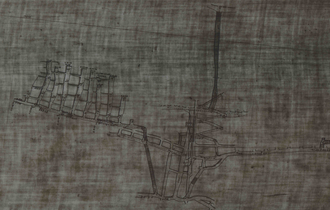

WESTERN MIDDLE COAL FIELD

FOUR FOOT VEIN

of

CONTINENTAL SHAFT

NORTH CONYNGHAM TOWNSHIP

and

COLUMBIA COUNTY

Lehigh Valley Coal Company

Scale 1 Inch = 100 Feet Mercer Co. Surveyor Date

FOR STATE MINE INSPECTORS USE