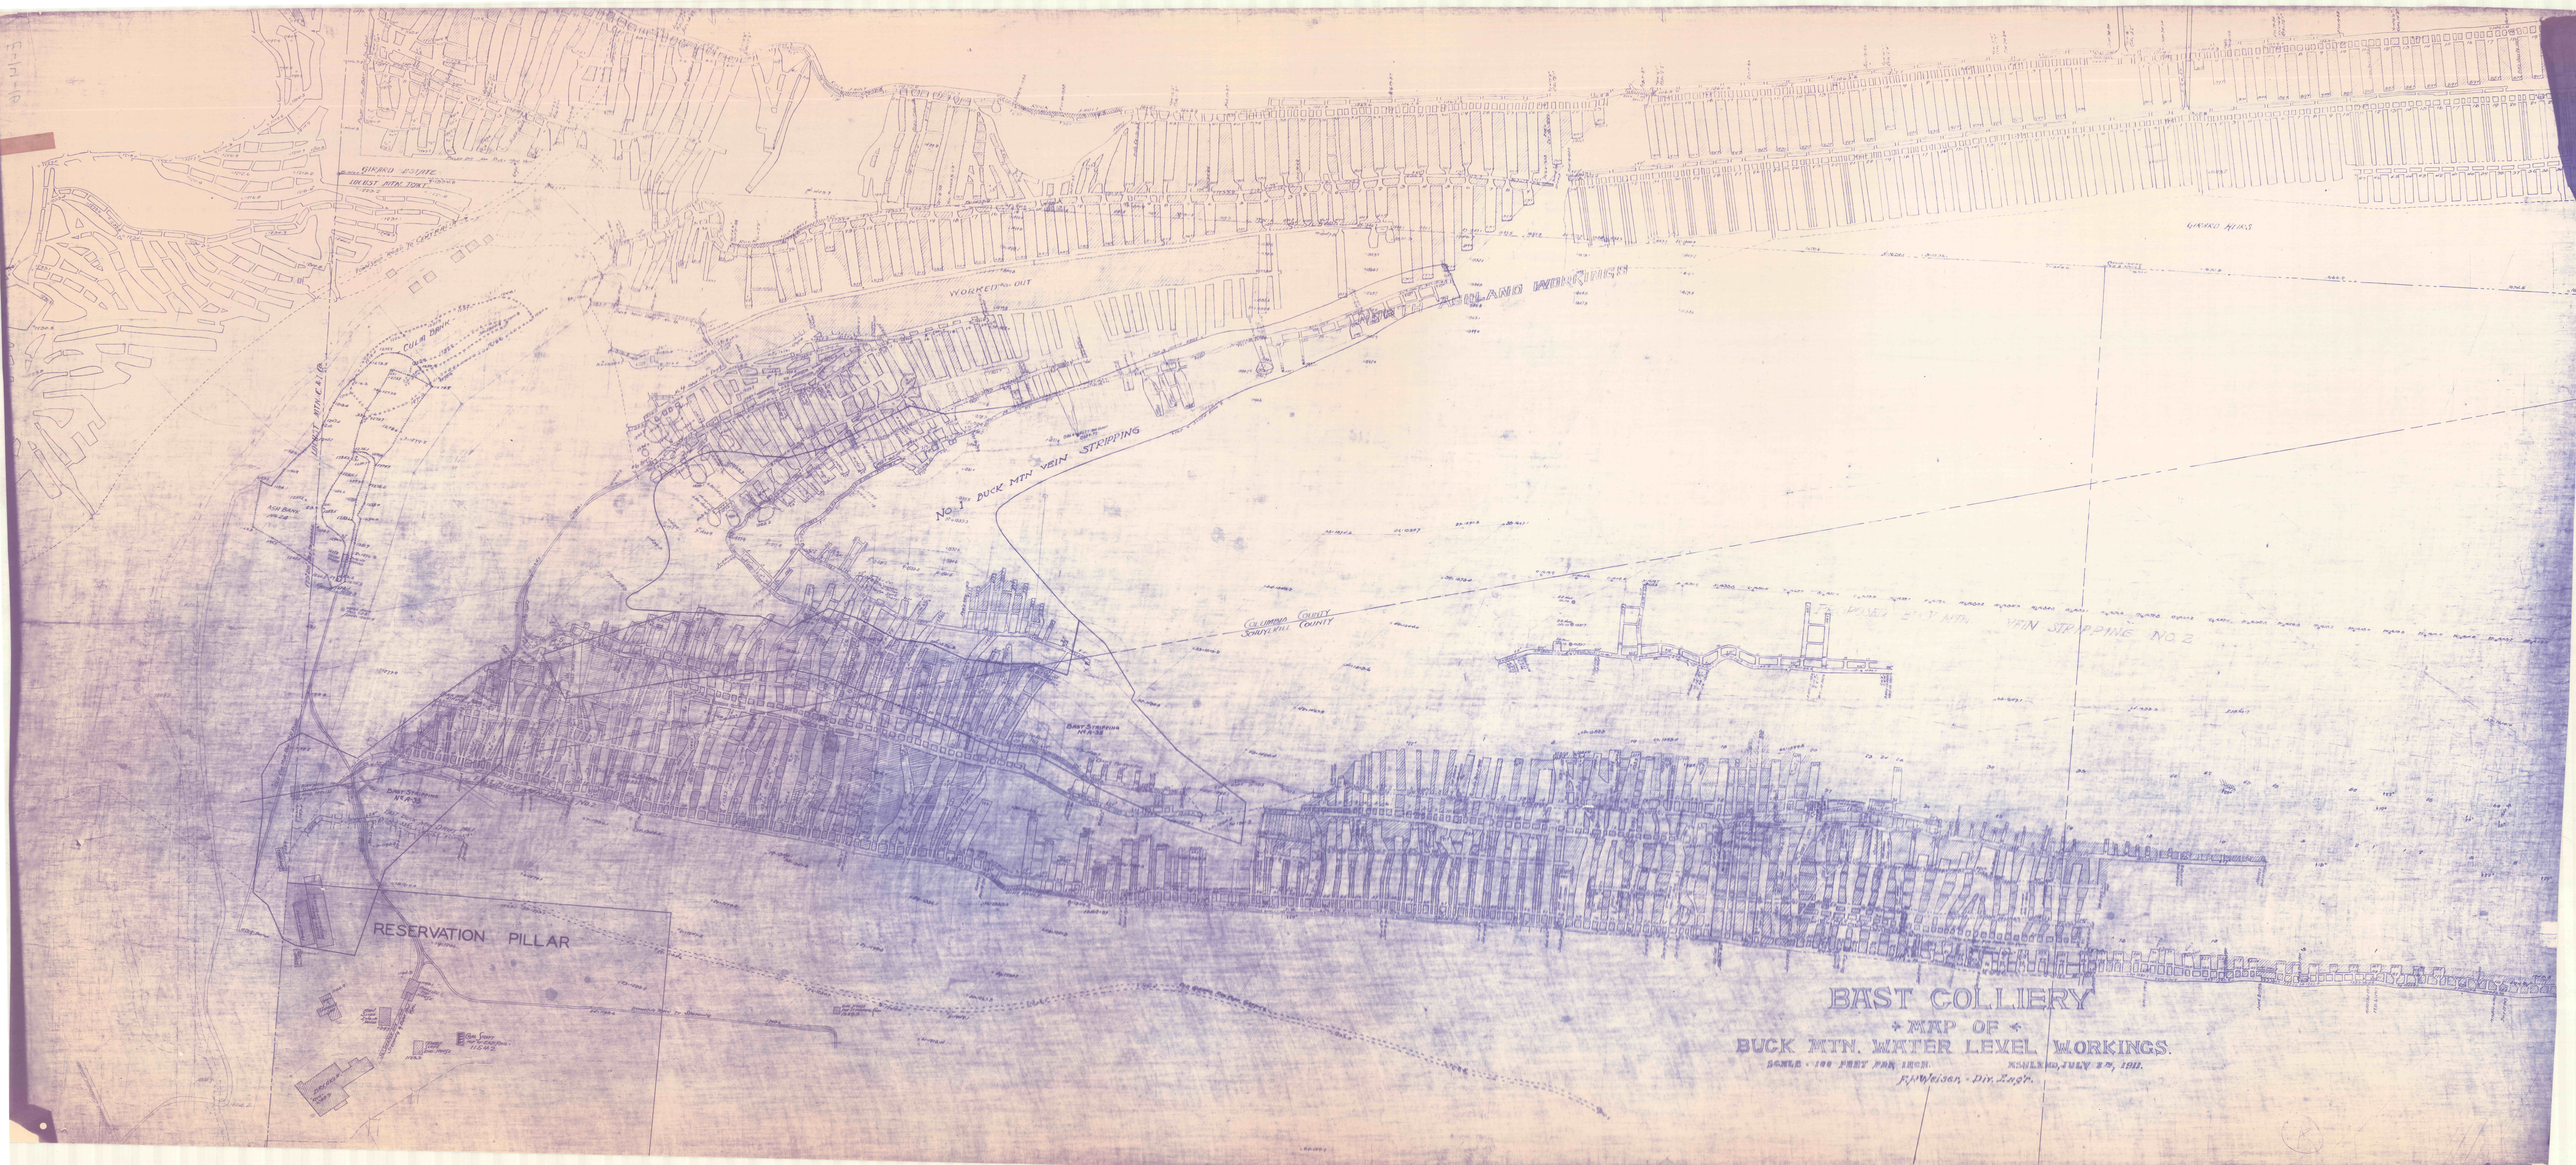
WORKED OUT
No. 1 BUCK MTN. VEIN STRIPPING
RESERVATION PILLAR
BAST COLLIERY
MAP OF
BUCK MTN. WATER LEVEL WORKINGS.
SCALE - 100 FEET PER INCH.
SCALED JULY 27, 1911.
F.M. Weiser - Div. Engr.