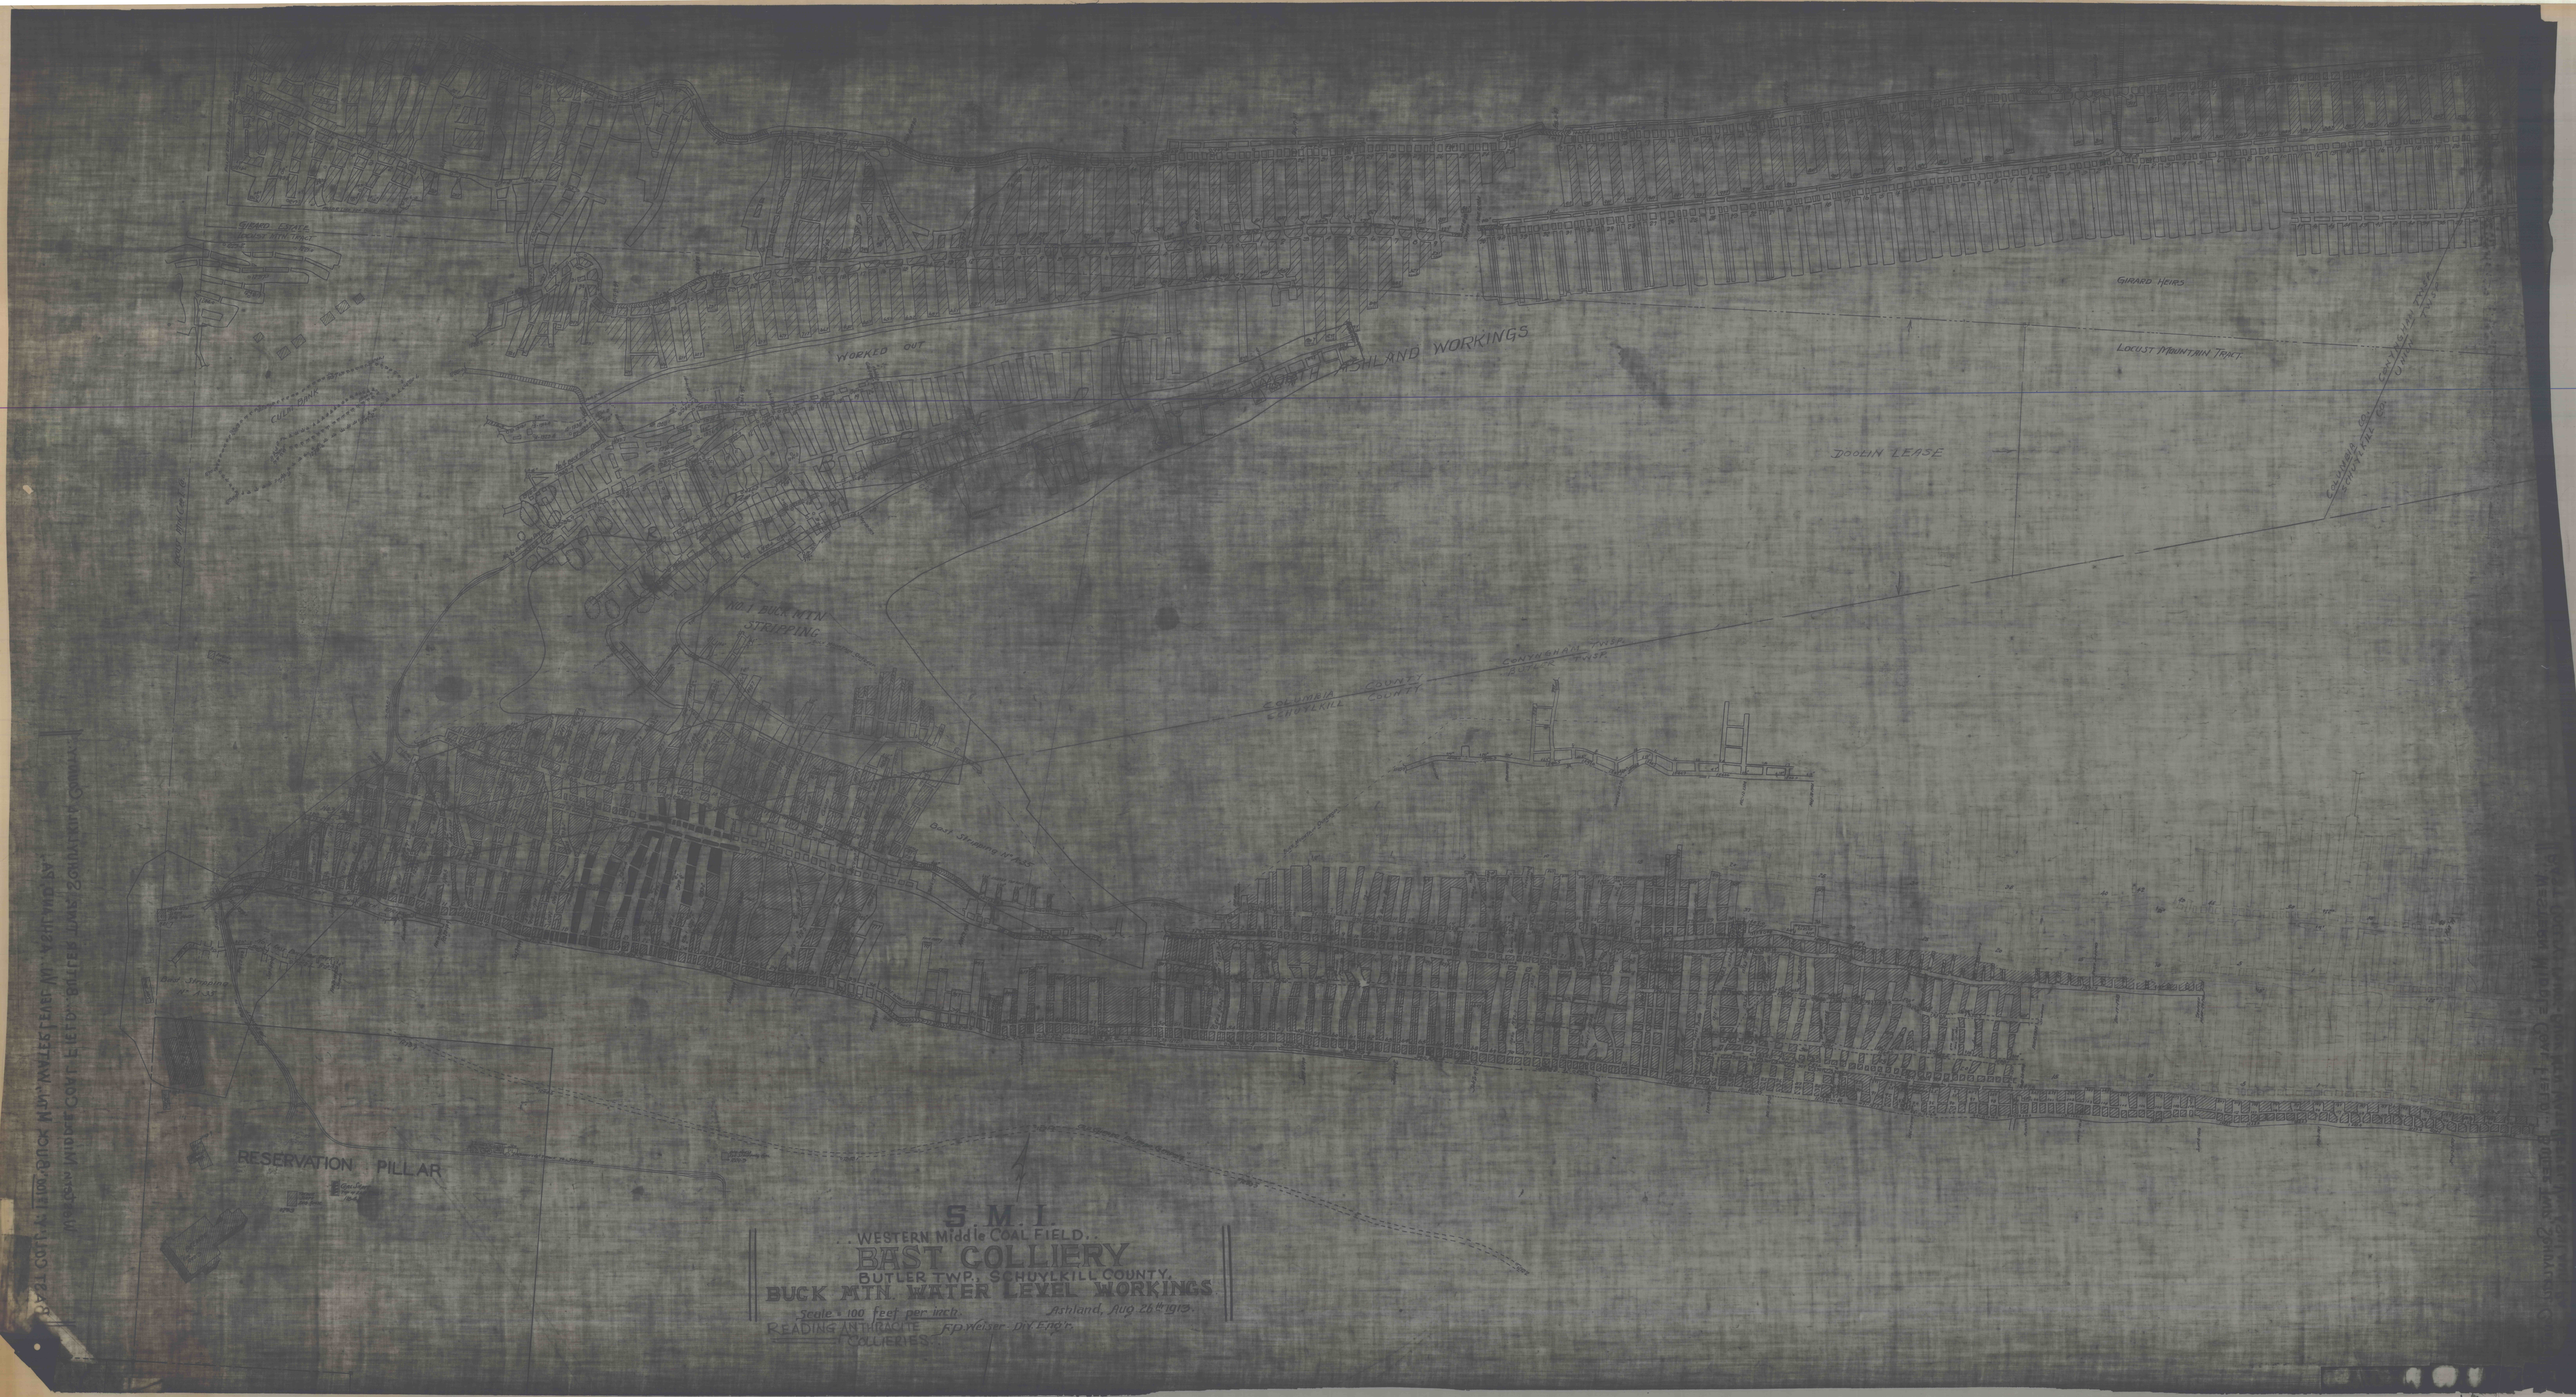
S.M.I.
WESTERN Middle COAL FIELD.
BAST COLLIERY
BUTLER TWP., SCHUYLKILL COUNTY.
BUCK MTN. WATER LEVEL WORKINGS
Scale 1 100 feet per inch.
Ashland, Aug 26th 1913.
READING ANTHRACITE COLLIERIES.
F.D. Weiser Div. Eng'r.
WORKED OUT
ASHLAND WORKINGS
GIRARD HEIRS
LOCUST MOUNTAIN TRACT
DOOLIN LEASE
COLUMBIA COUNTY
SCHUYLKILL COUNTY
RESERVATION PILLAR