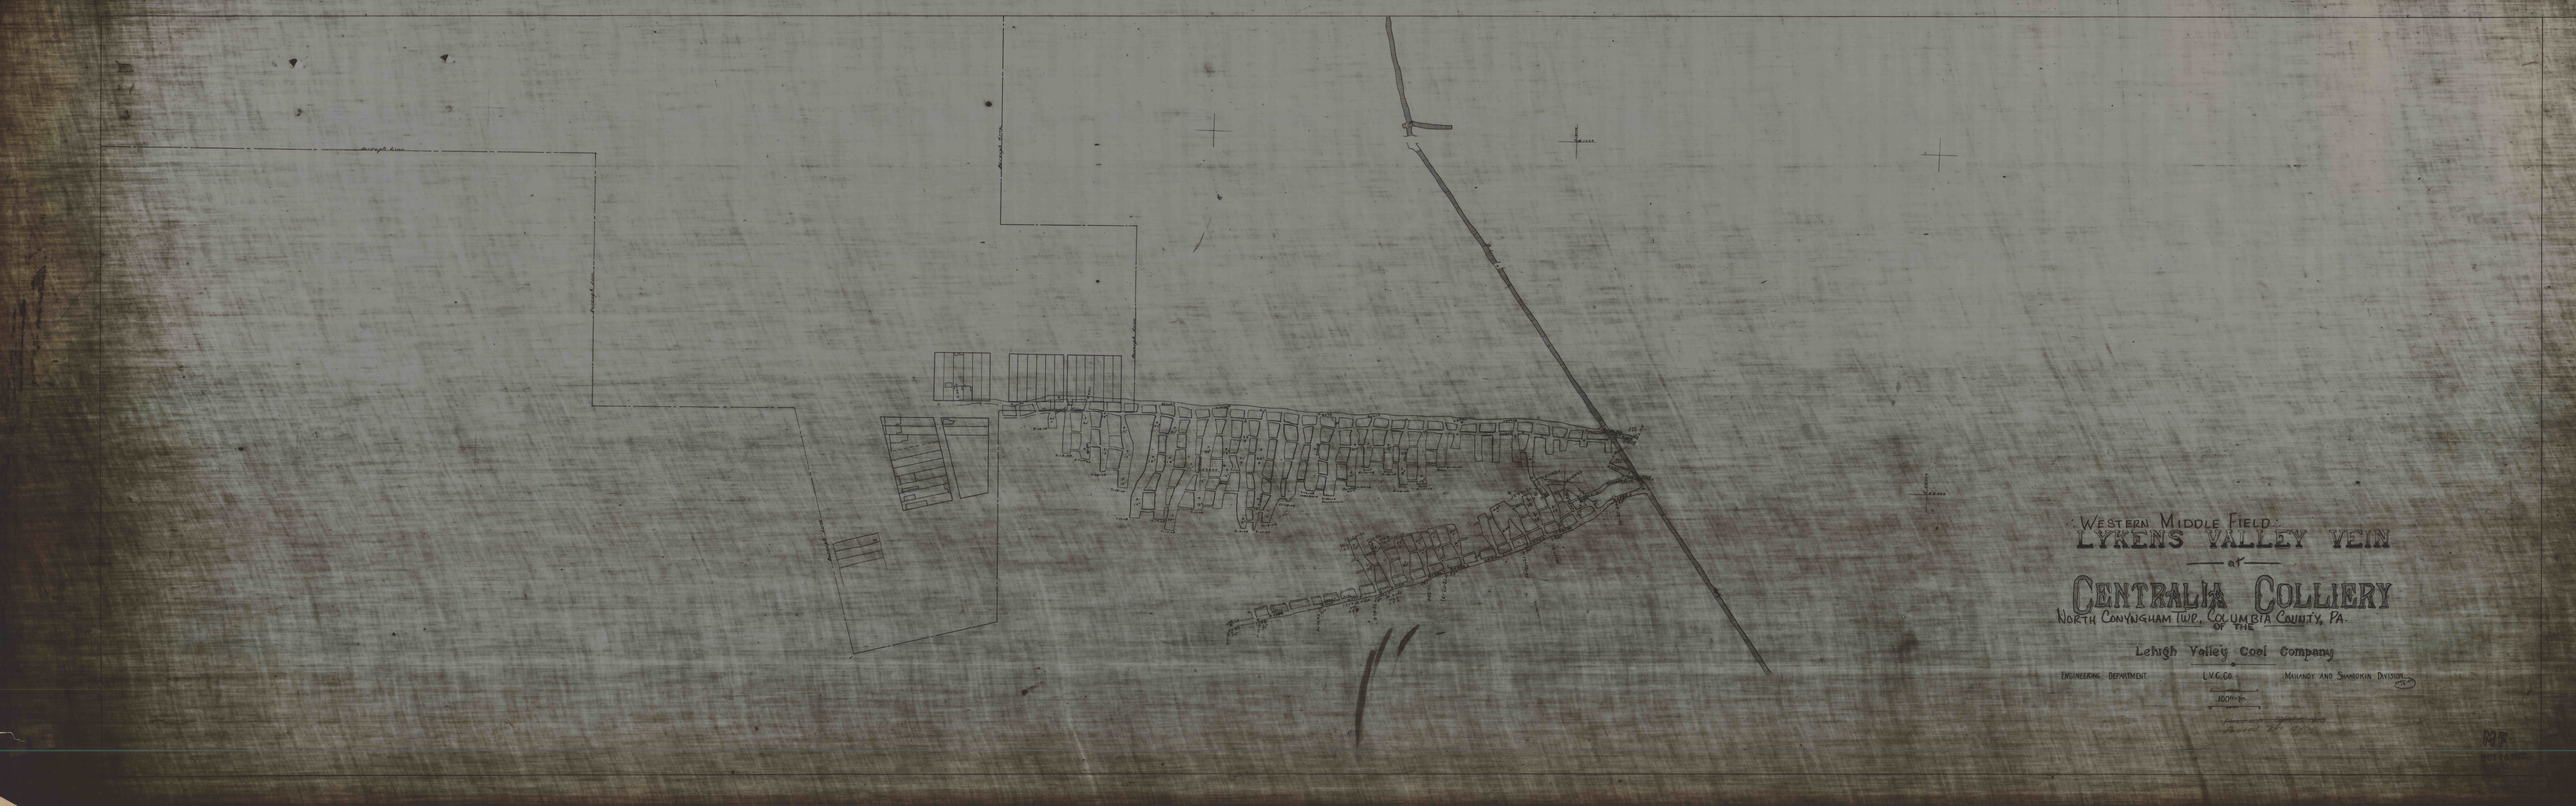
WESTERN MIDDLE FIELD
LYKENS VALLEY VEIN
at
CENTRALIA COLLIERY
NORTH CONYNGHAM TWP., COLUMBIA COUNTY, PA.
OF THE
Lehigh Valley Coal Company
ENGINEERING DEPARTMENT
L.V.C.Co
MAHANOY AND SHAMOKIN DIVISION
100 FT.