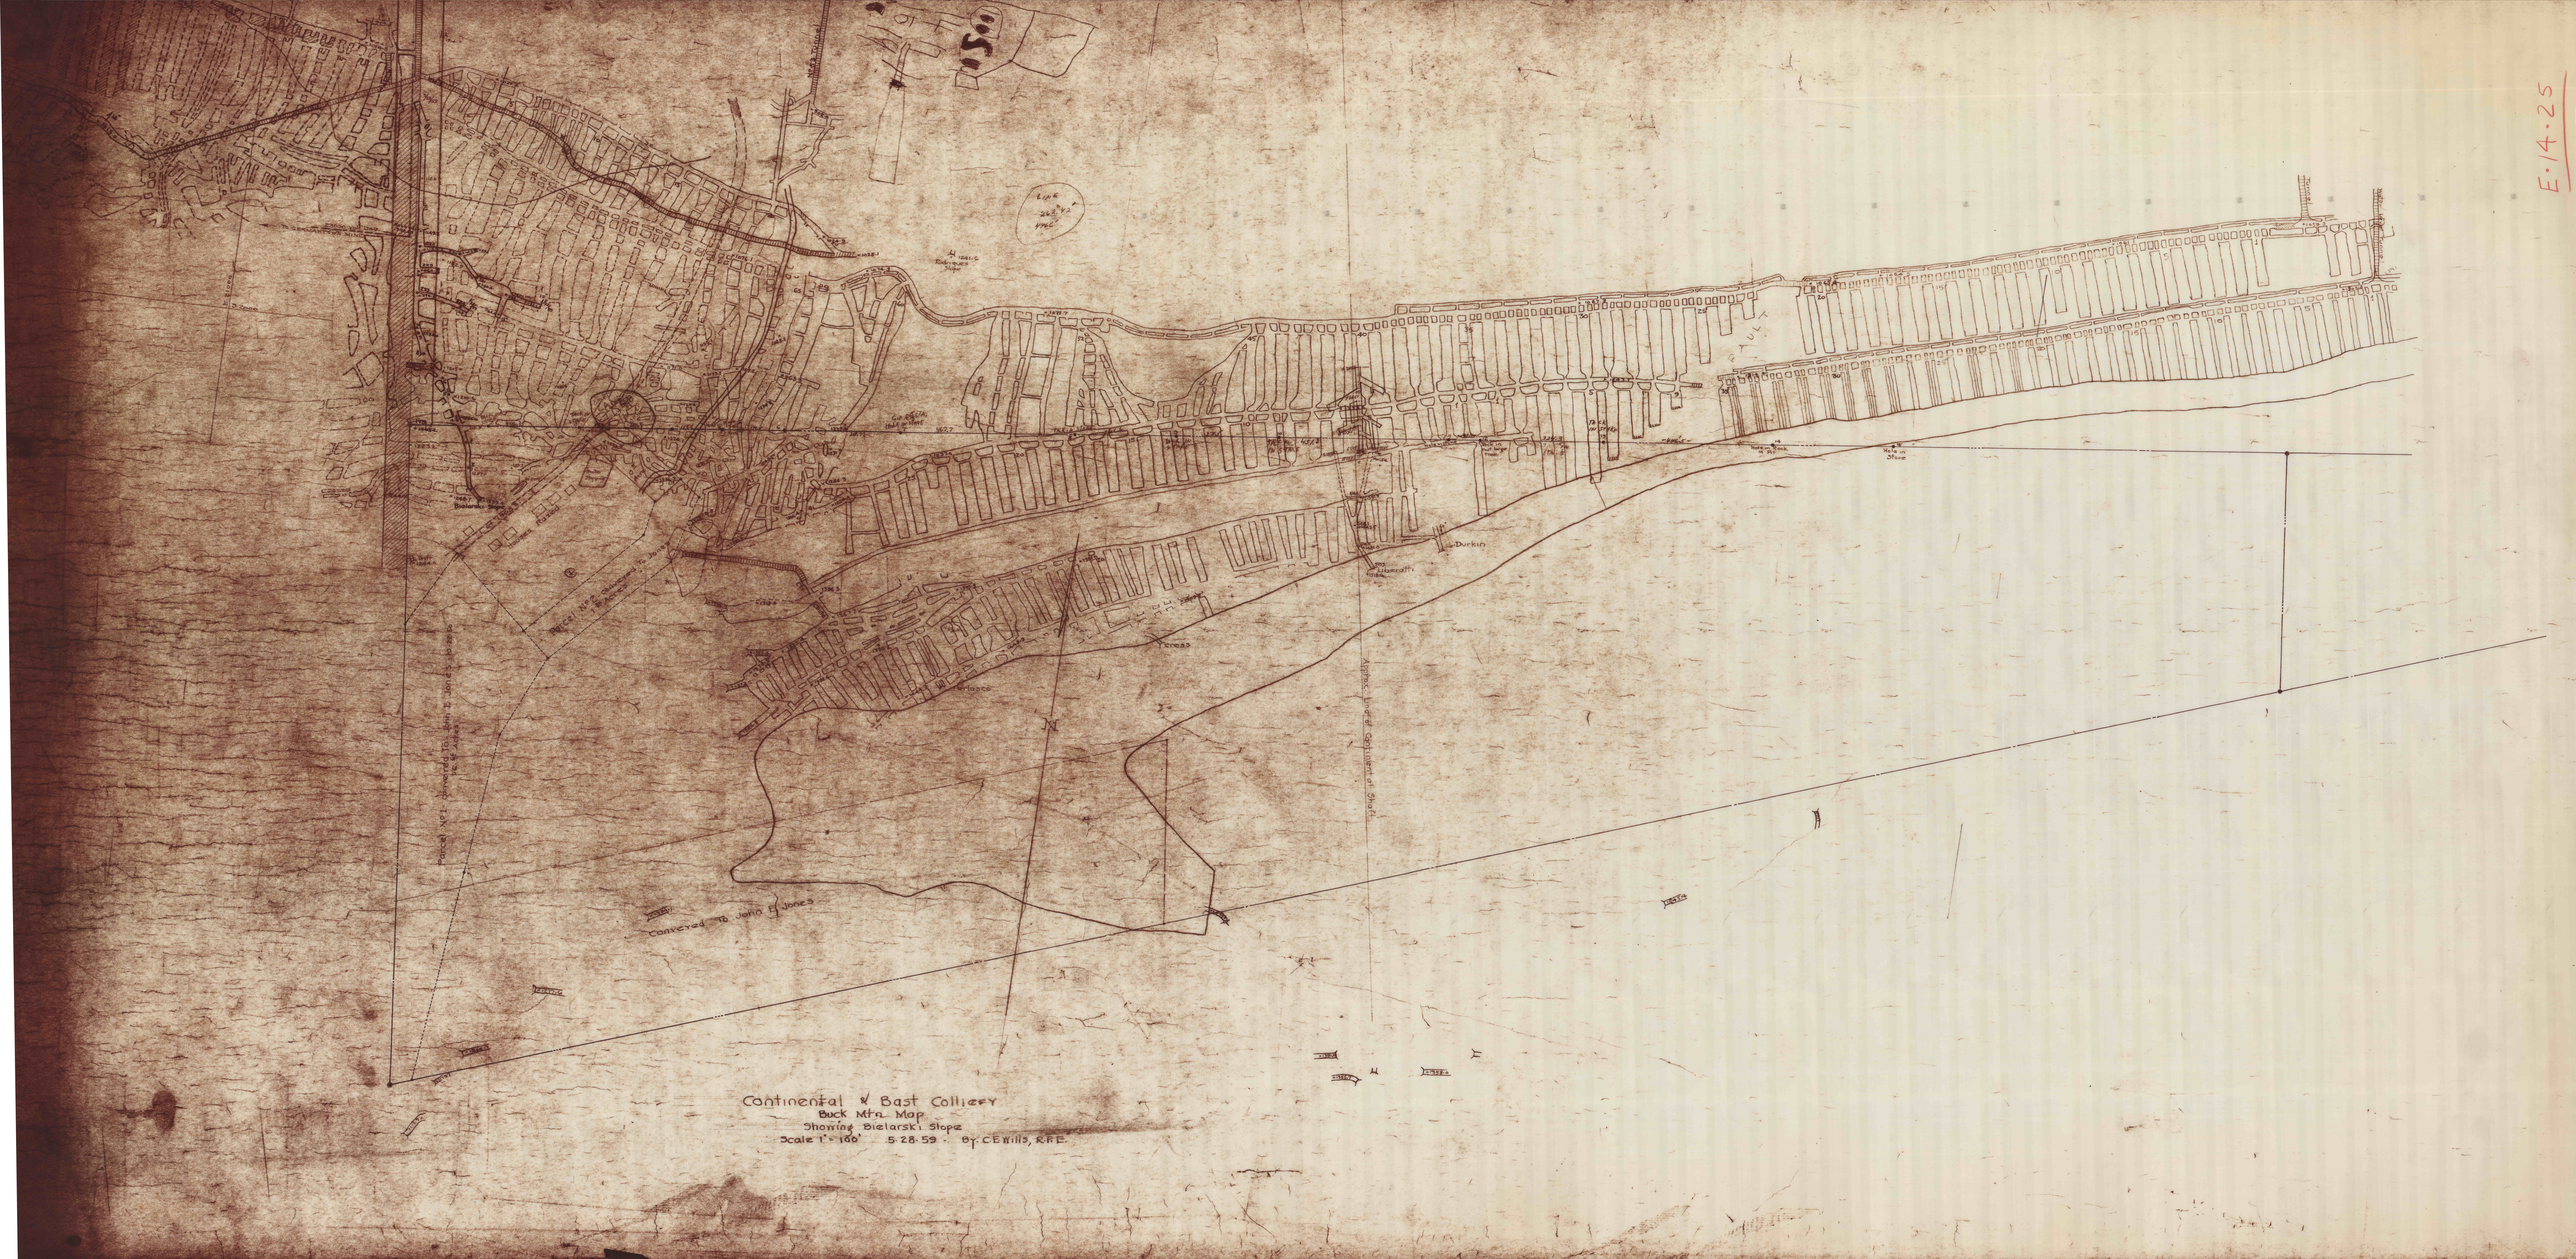
Continental & Bast Colliery
Buck Mtn. Map
Showing Bielarski Slope
Scale 1" = 100' 5-28-59 By C.E. Wills, R.F.E.
Converted To John H Jones
Durkin
Ykress
Parcel No 1 converted To John H Jones
Approx. Line of Continent of Shaft
FAULT
E.14.25