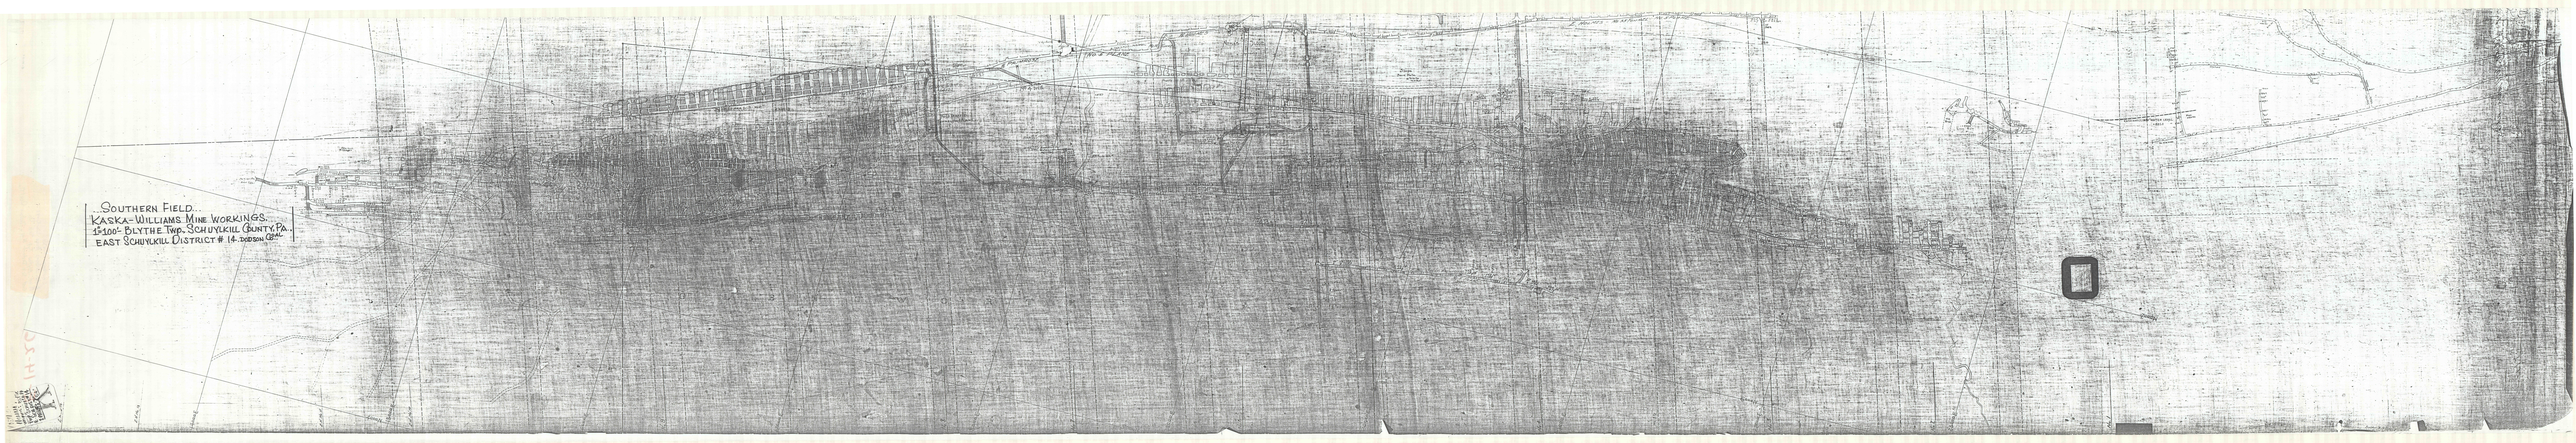
SOUTHERN FIELD.
KASKA-WILLIAMS MINE WORKINGS.
15-100'- BLYTHE TWP. SCHUYLKILL COUNTY, PA.
EAST SCHUYLKILL DISTRICT # 14. DODSON COAL CO.