EAST COLLIERY

SKIDMORE VEIN
AND
4th LIFT DEVELOPMENTS.
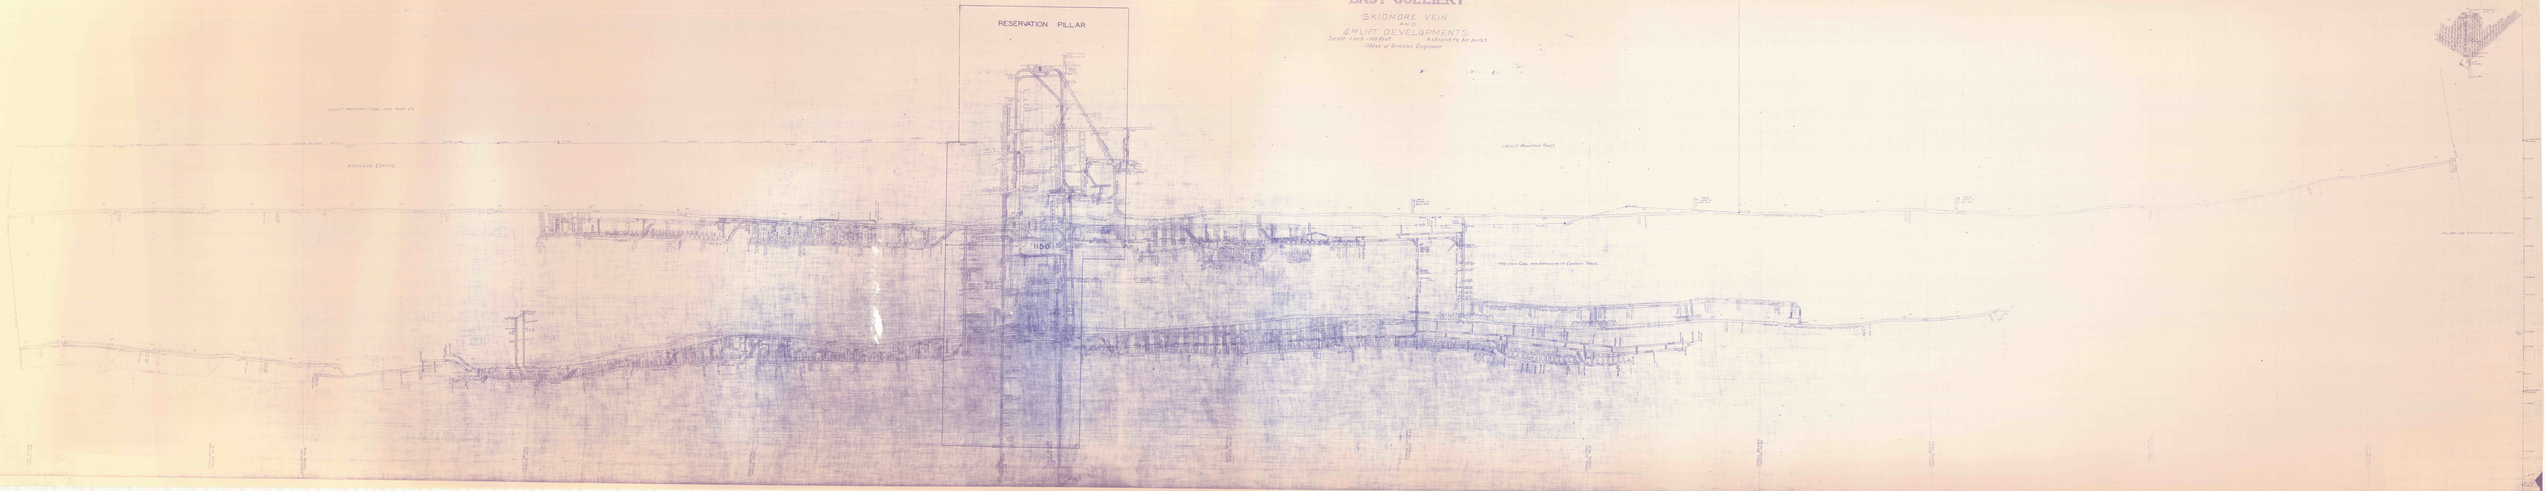
Scale 1 inch = 100 feet
Office of Division Engineer