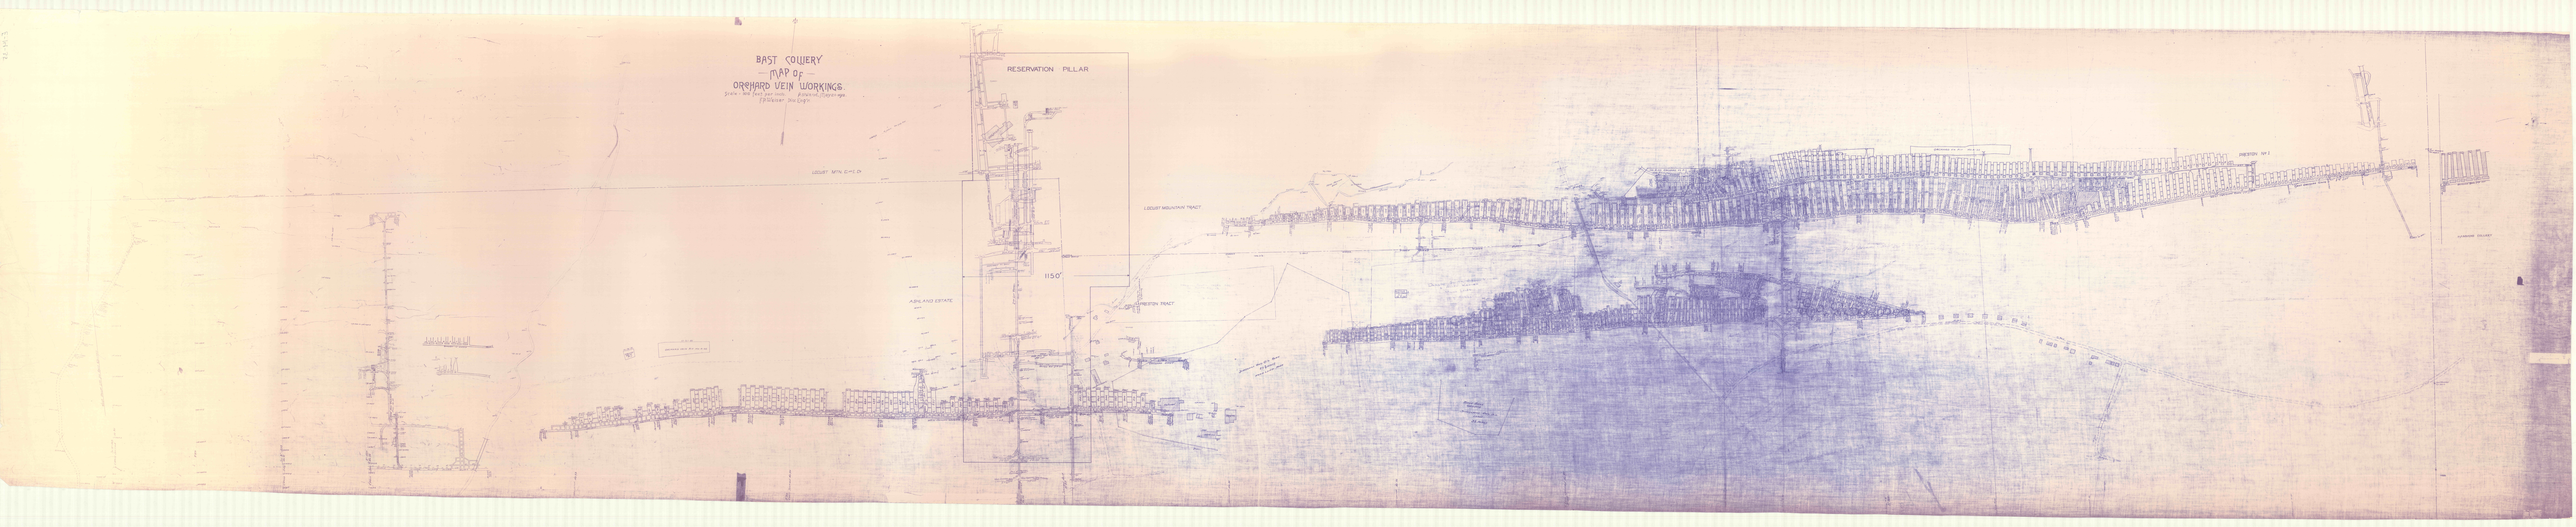
BAST COLLIERY
MAP OF
ORCHARD VEIN WORKINGS.
RESERVATION PILLAR
LOGGIT MTN. C.M.C.Co.
LOGGIT MOUNTAIN TRACT
1150'
ABNI AND ESTATE
