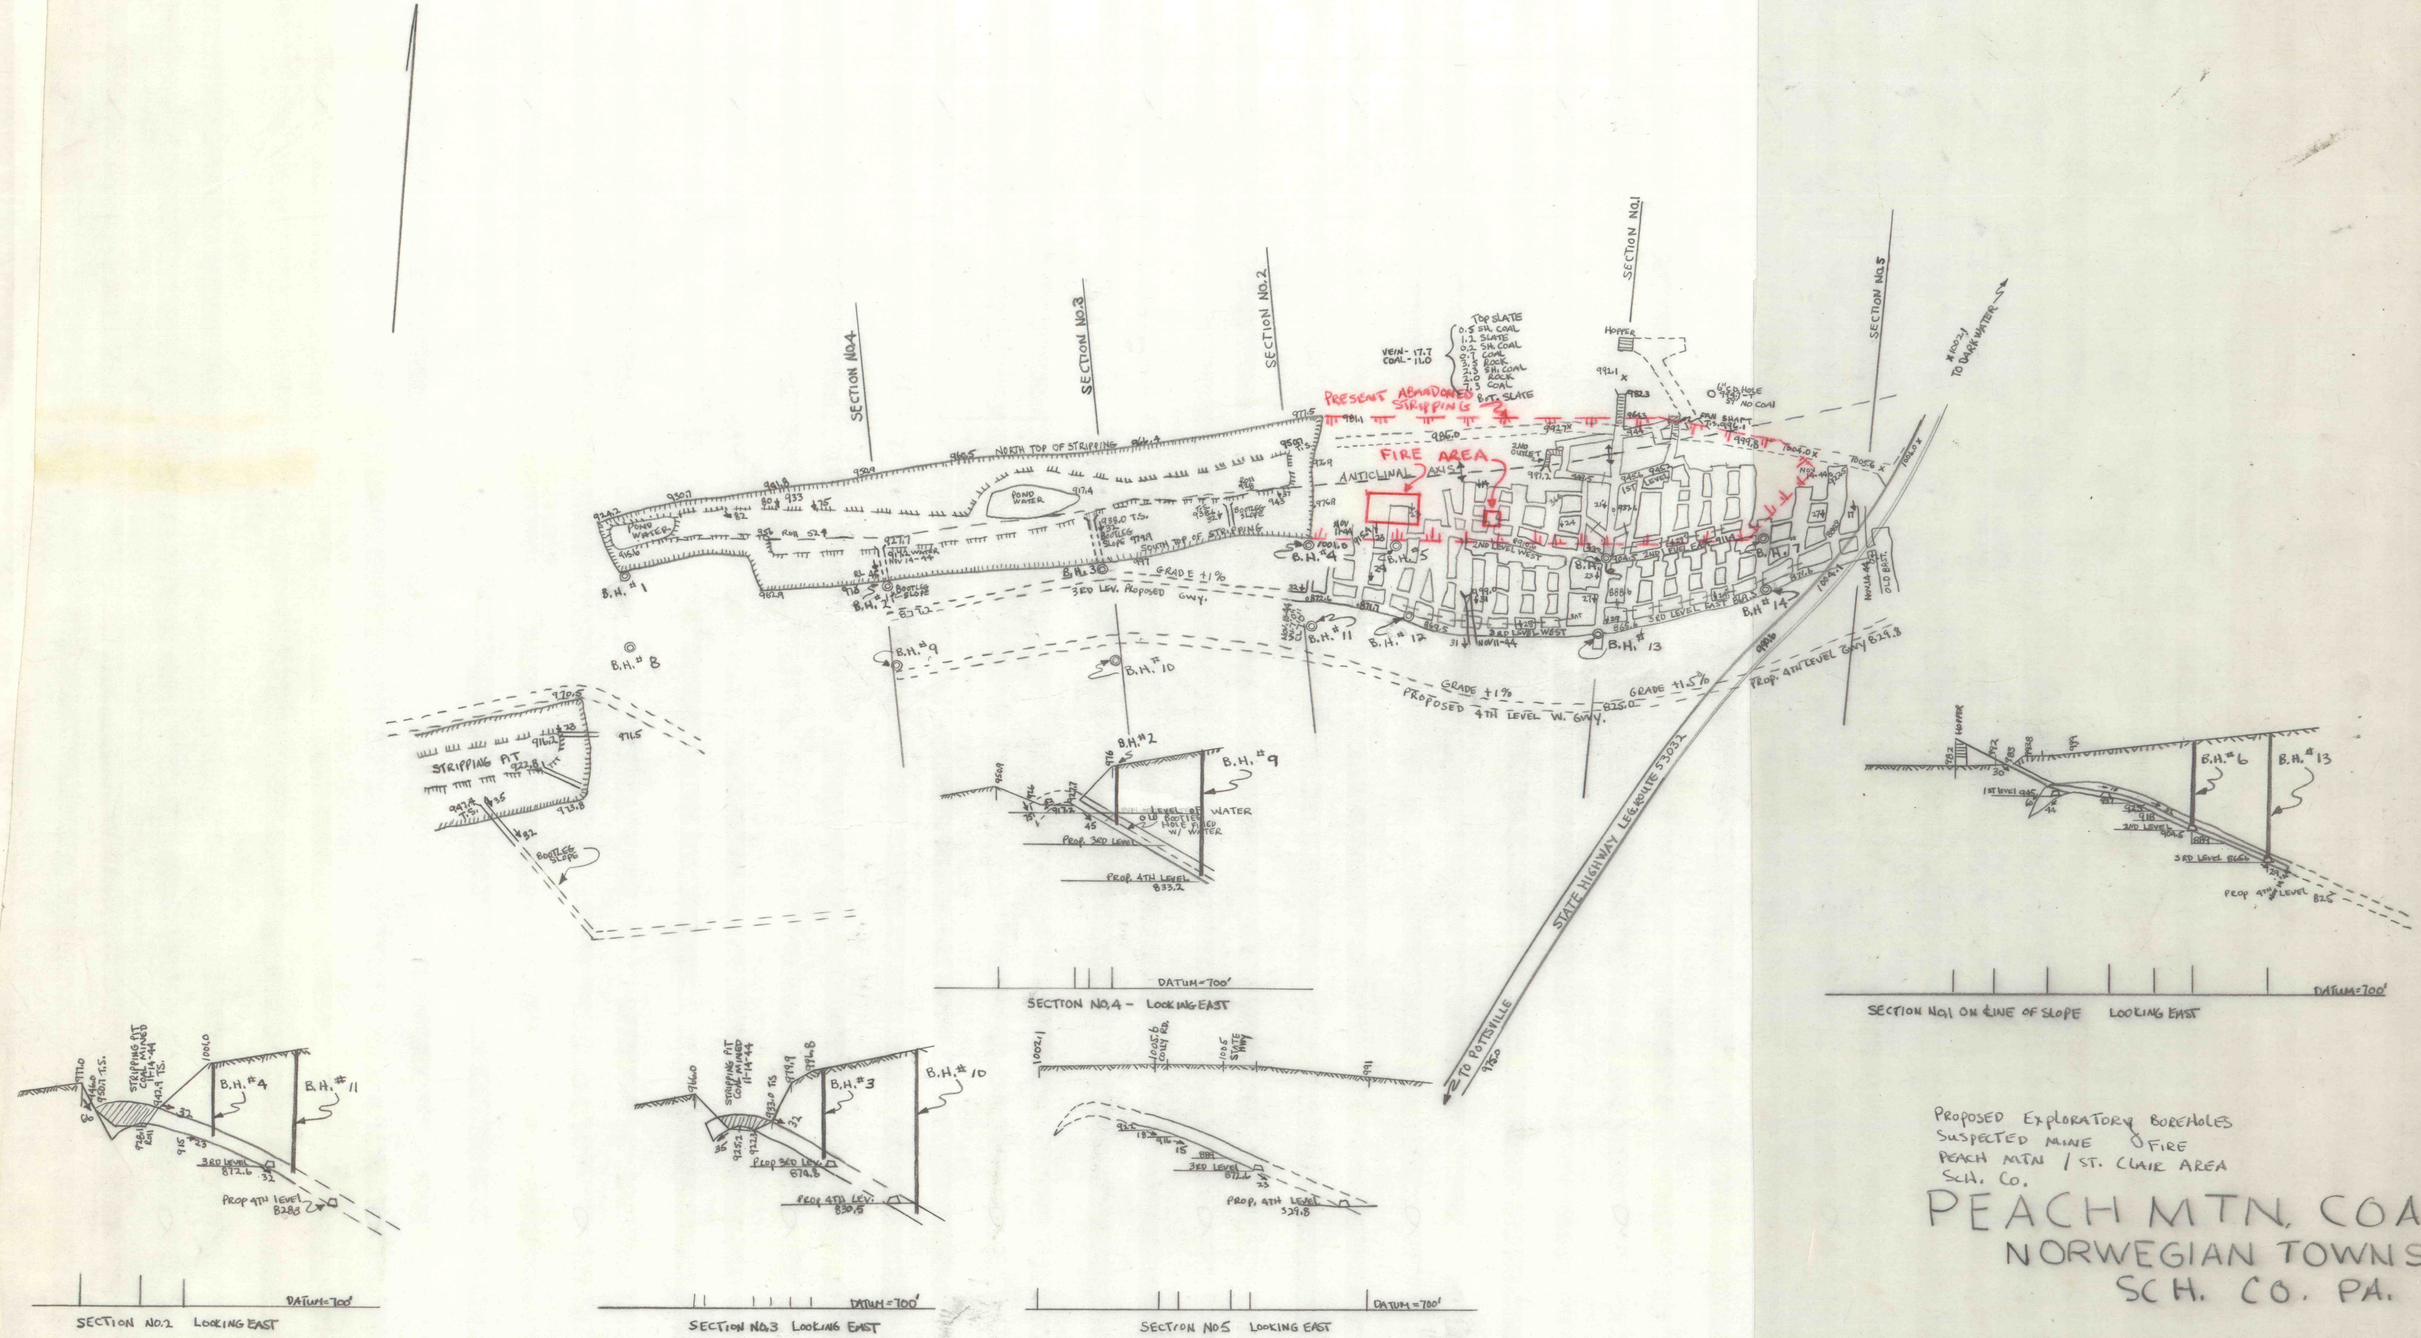

PROPOSED EXPLORATORY BOREHOLES
SUSPECTED MINE FIRE
PEACH MTN / ST. CLAIR AREA
SCH. CO.

PEACH MTN. COAL CO.
NORWEGIAN TOWNSHIP
SCH. CO. PA.

SURVEYED NOV. 14, 1944 (P & R, C & I CO. DATUM) SCALE: 1" = 100'

DEC. 1978

Department of Environmental Resources
Office of Resources Management
Room 2[illegible] [illegible] Box 83[illegible]
108 Claude A. Lord Blvd.
Pottsville, Pennsylvania 17901