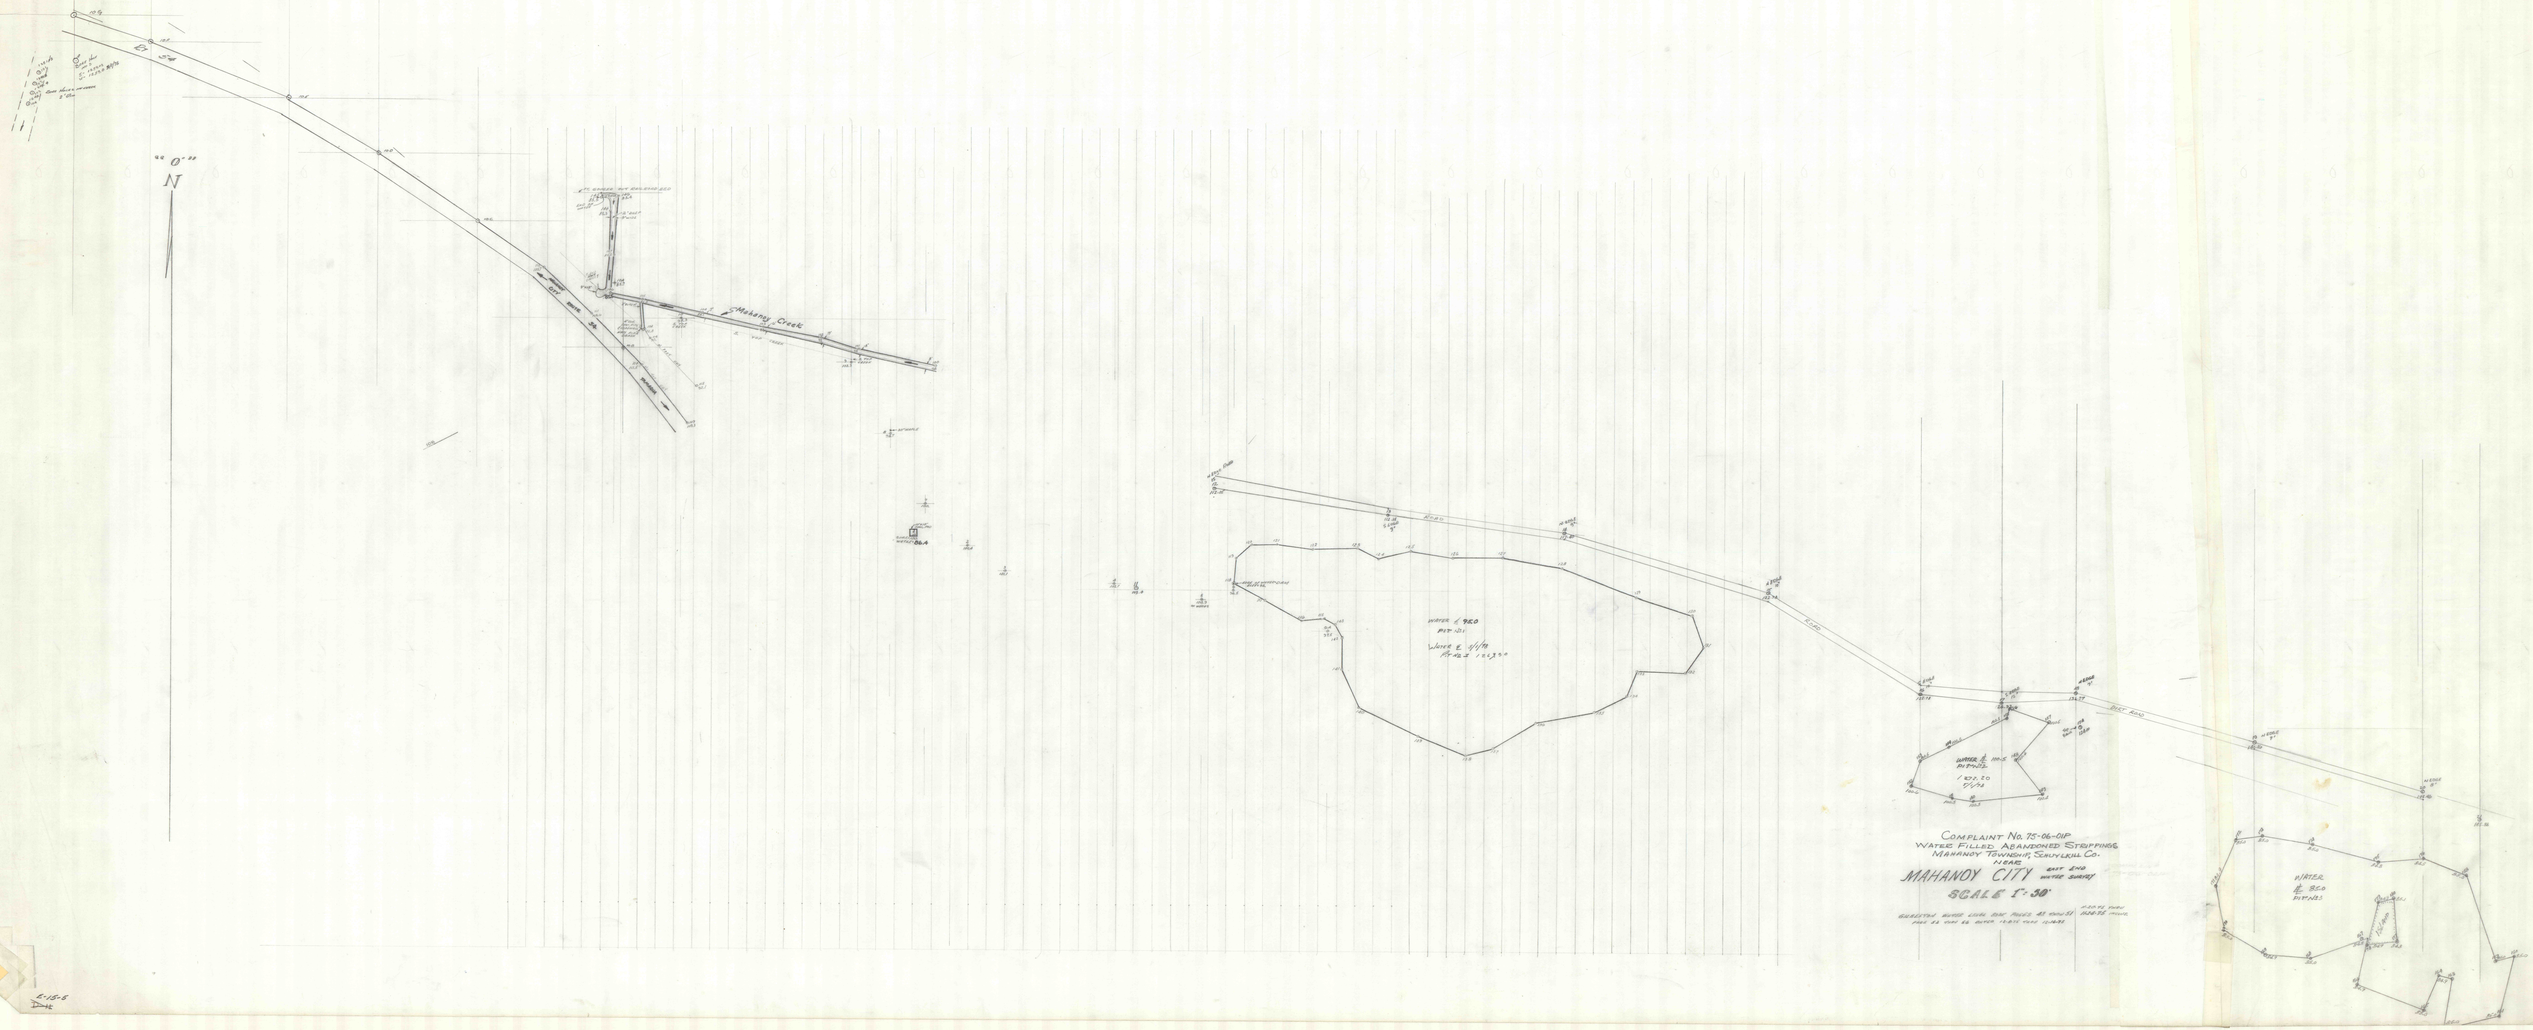
N
Mahanoy Creek
Road
Dirt Road
COMPLAINT No. 75-06-OIP
WATER FILLED ABANDONED STRIPPING
MAHANOY TOWNSHIP, SCHUYLKILL CO.
NEAR
MAHANOY CITY
SCALE 1"=50'

E-15-5