


BREAKER

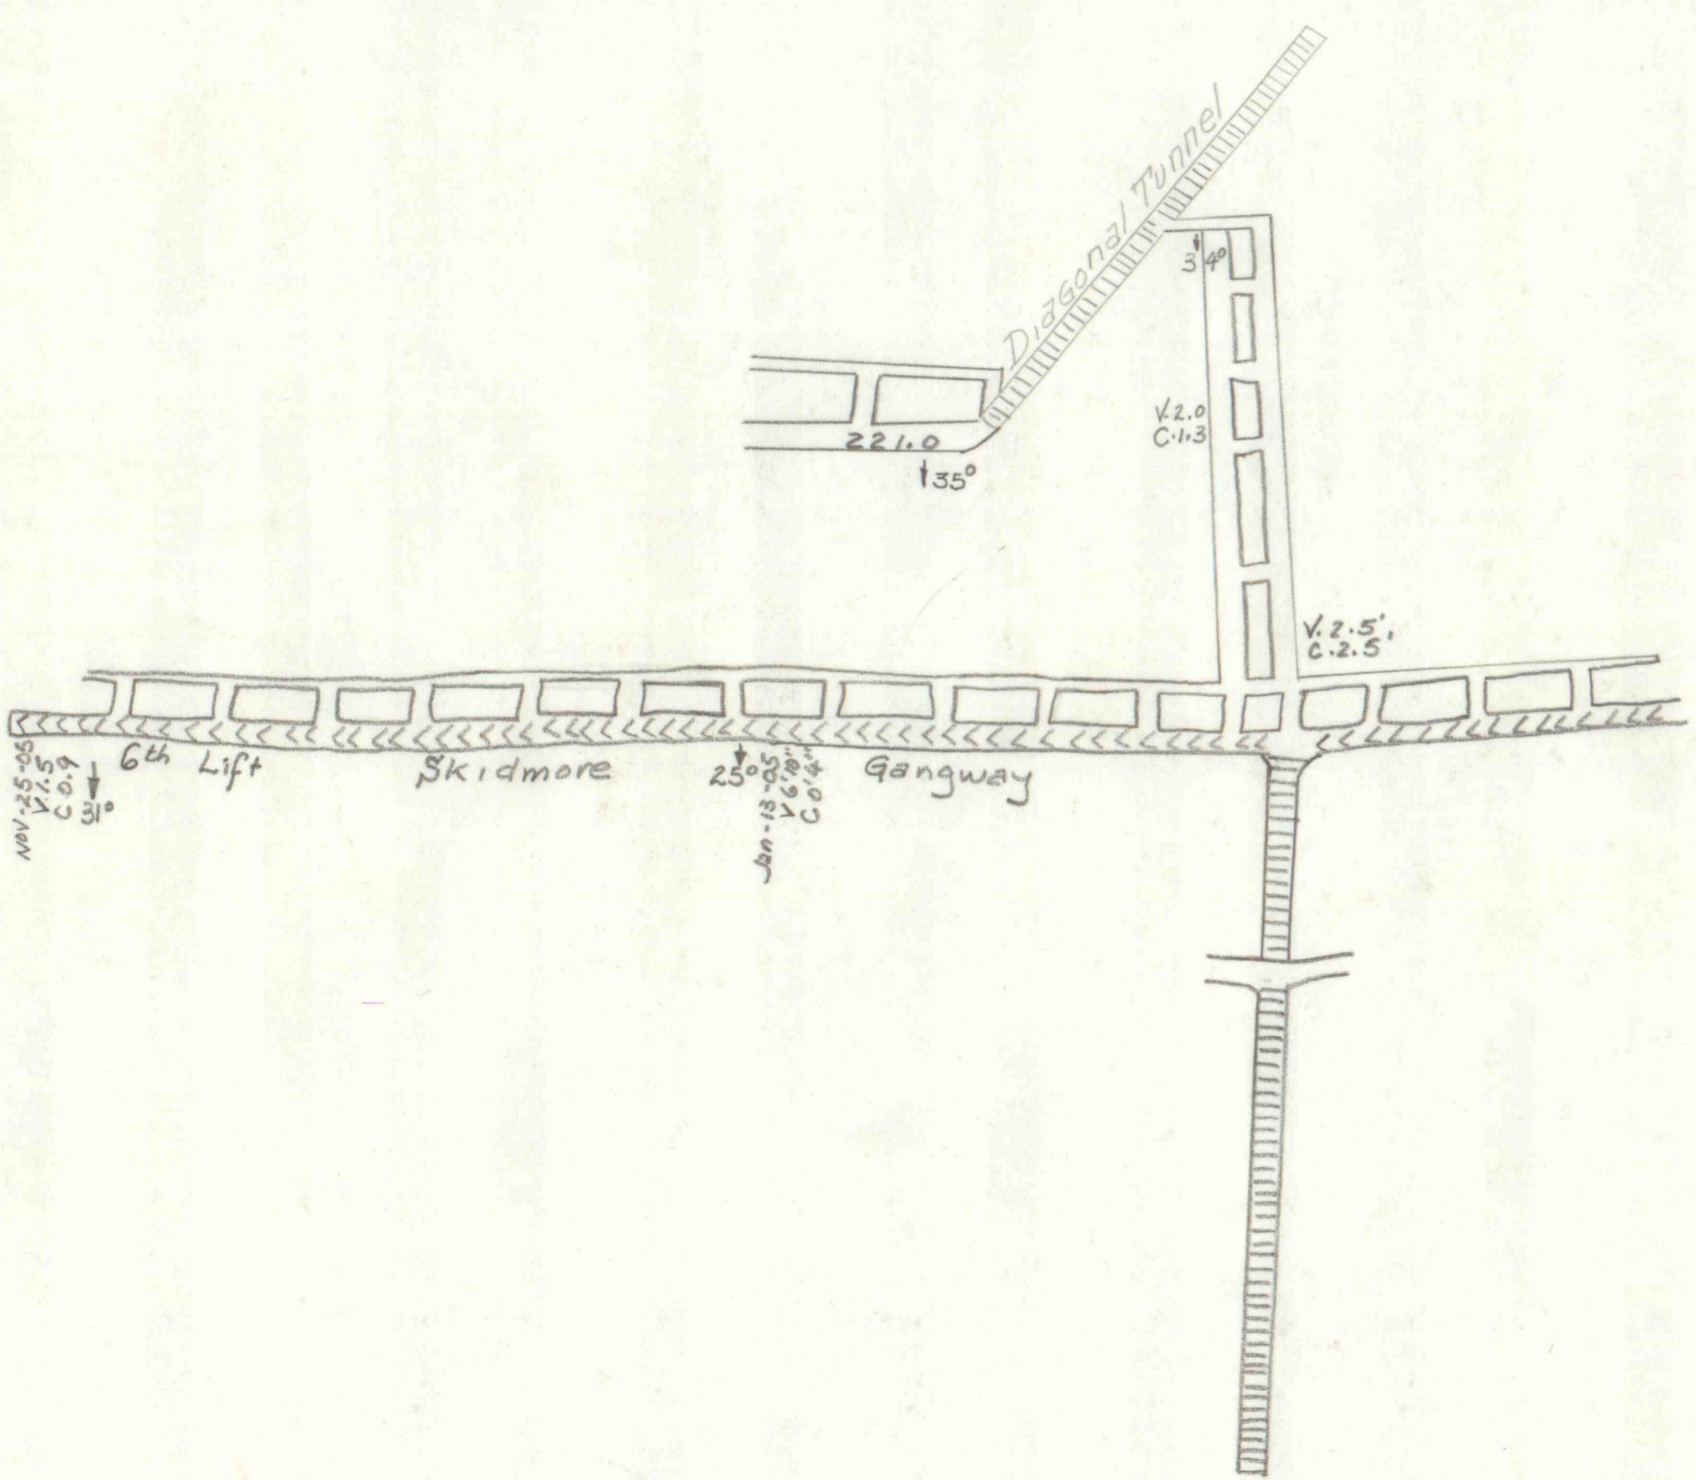

Otto Colliery
Skidmore Vein
1" = 100'