


WEST MAHANOA TWP SCHUYLKILL CO PA  
LOST CREEK: D.M.Z.

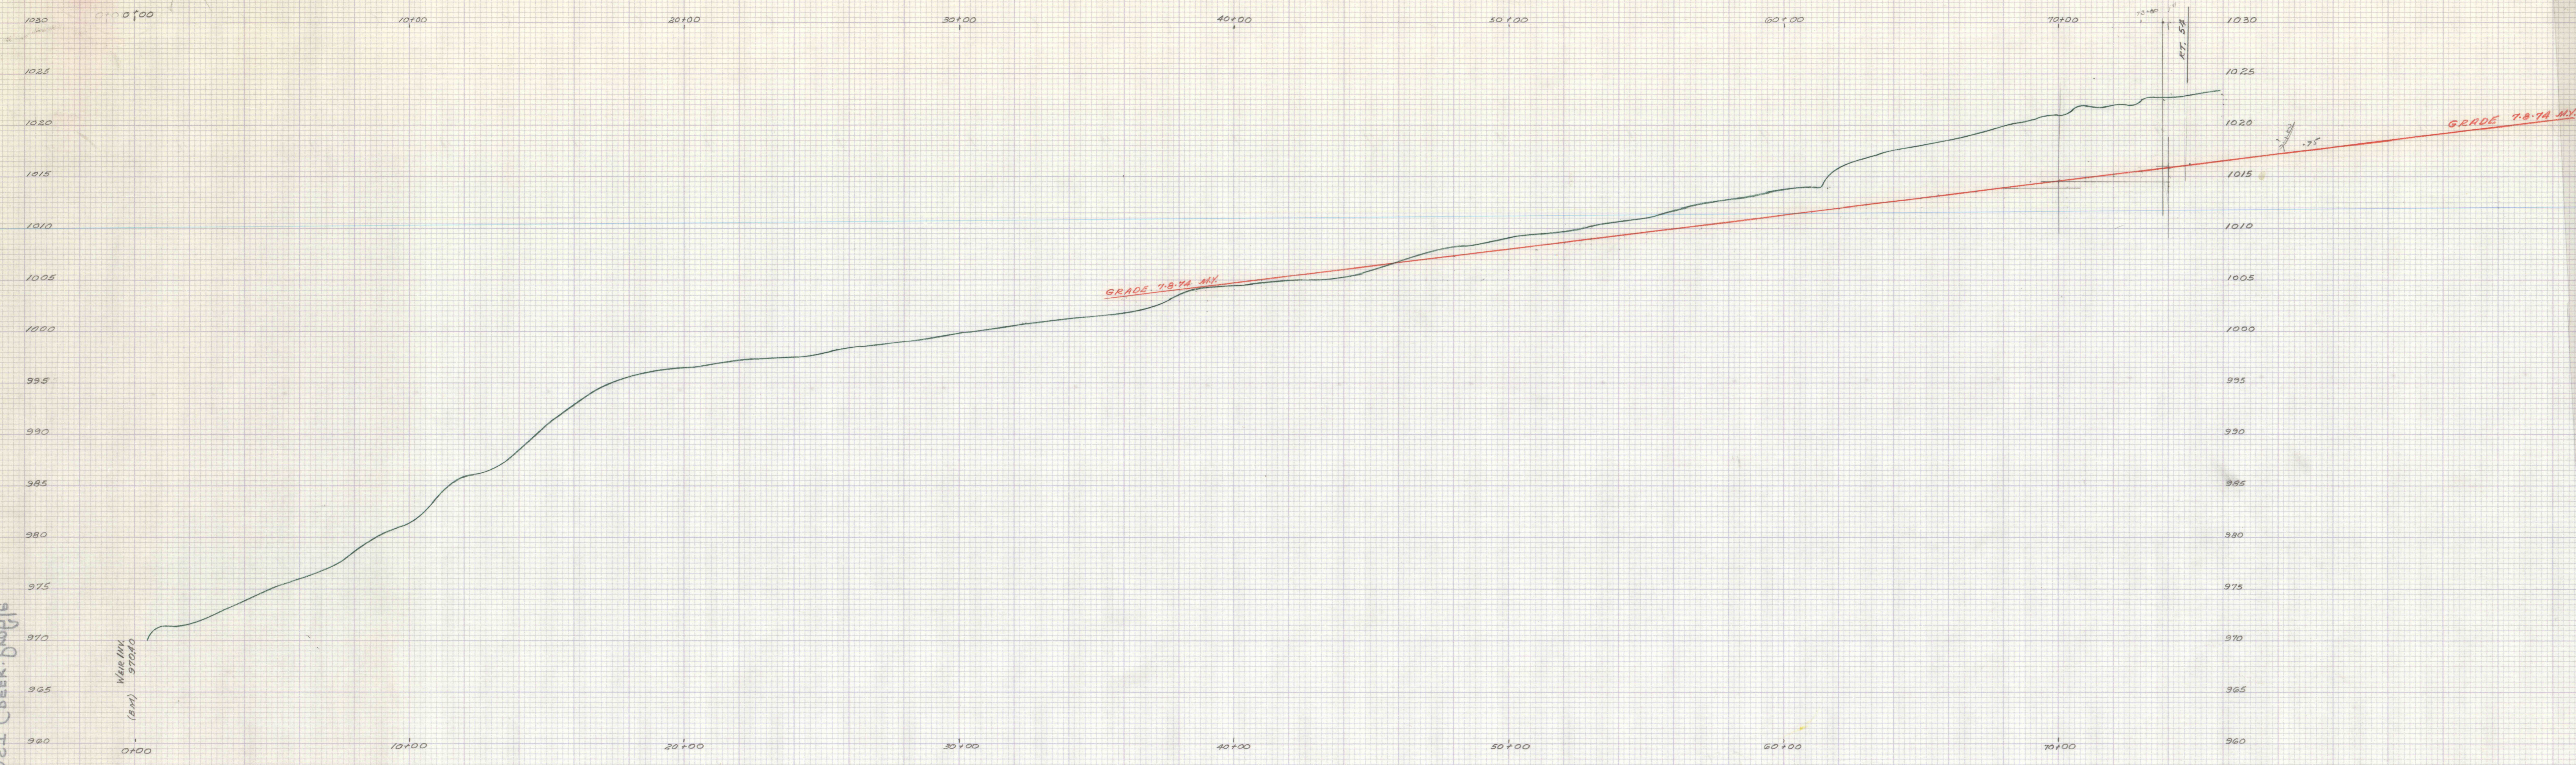

PROFILE  
LOST CREEK  
WEST MAHANOA TOWNSHIP  
SCHUYLKILL COUNTY  
PENNSYLVANIA  
SCALE: VERTICAL 1" = 5'  
HORIZONTAL 1" = 200'  
REDRAWN 7.8-74 M.M.Z.