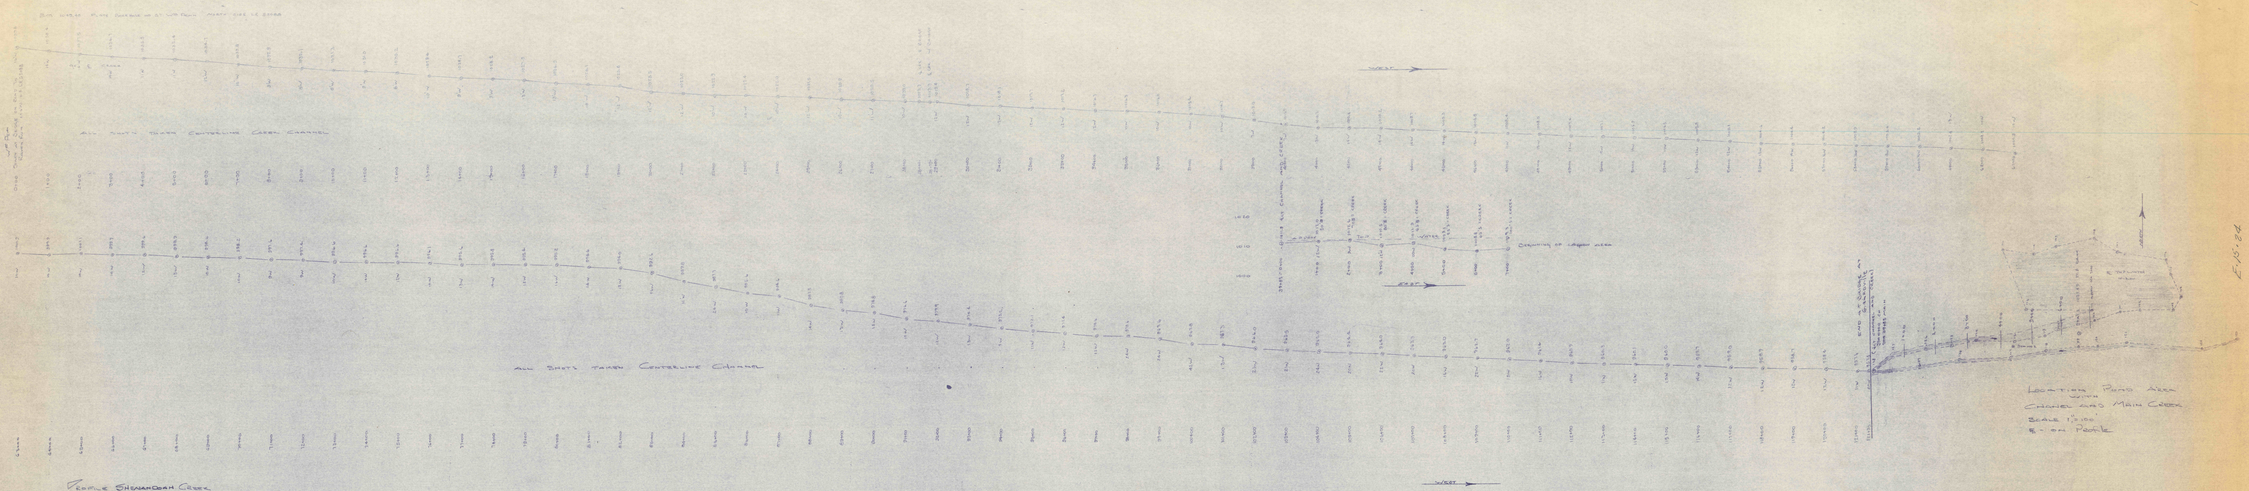
ALL SHOTS TAKEN CENTERLINE CHANNEL
ALL SHOTS TAKEN CENTERLINE CHANNEL
WEST
WEST
WEST
WEST
LOCATION PHOTO AREA
CHANNEL AND MAIN CREEK
SCALE 1:100
- on Photo
PROFILE SHENANDOAH CREEK
W.O. PENN TO GRANDVILLE
SCALE HORZ 1:20
VERT 1:100
DATE 6-27-71
SJD

E.15.24

E.15.24