

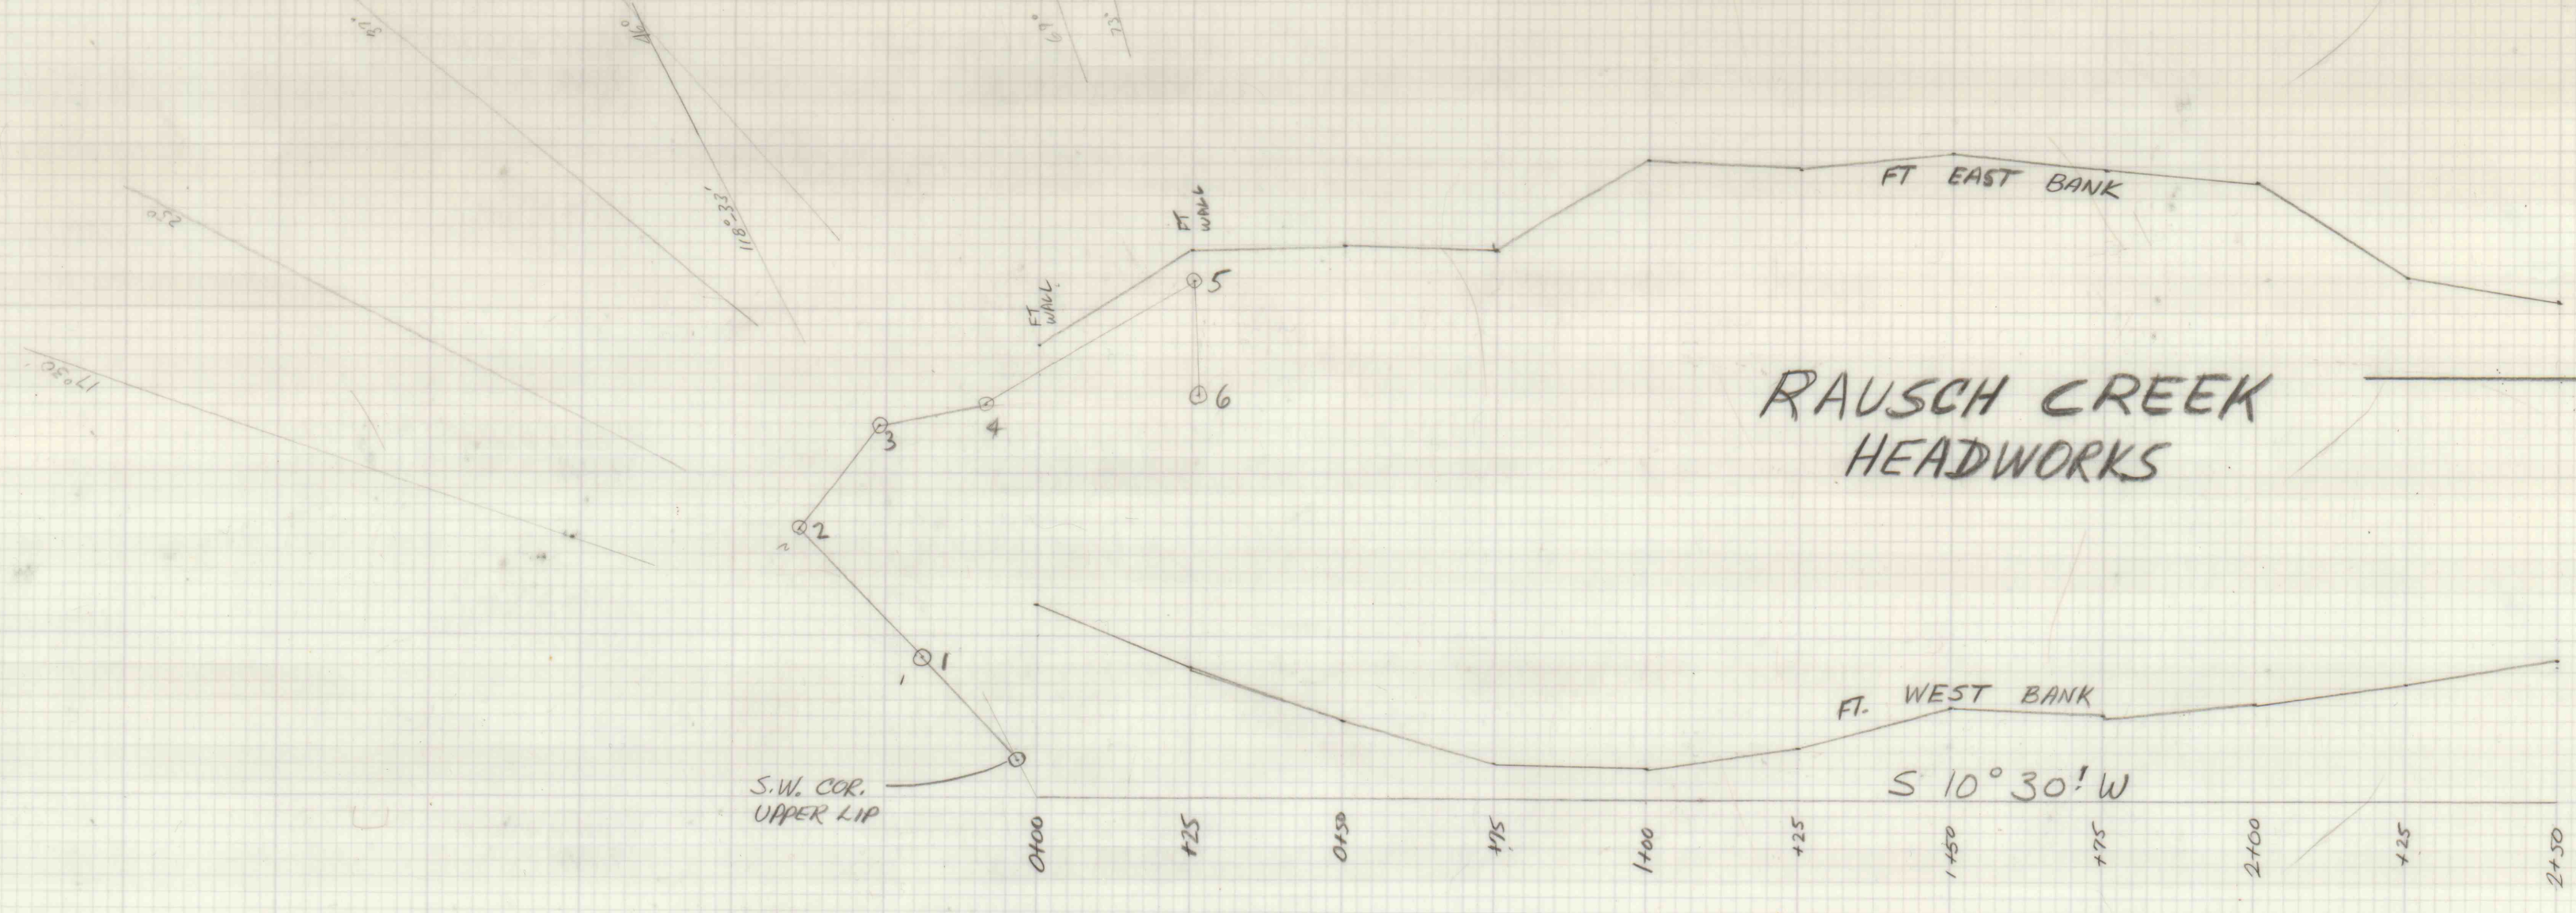
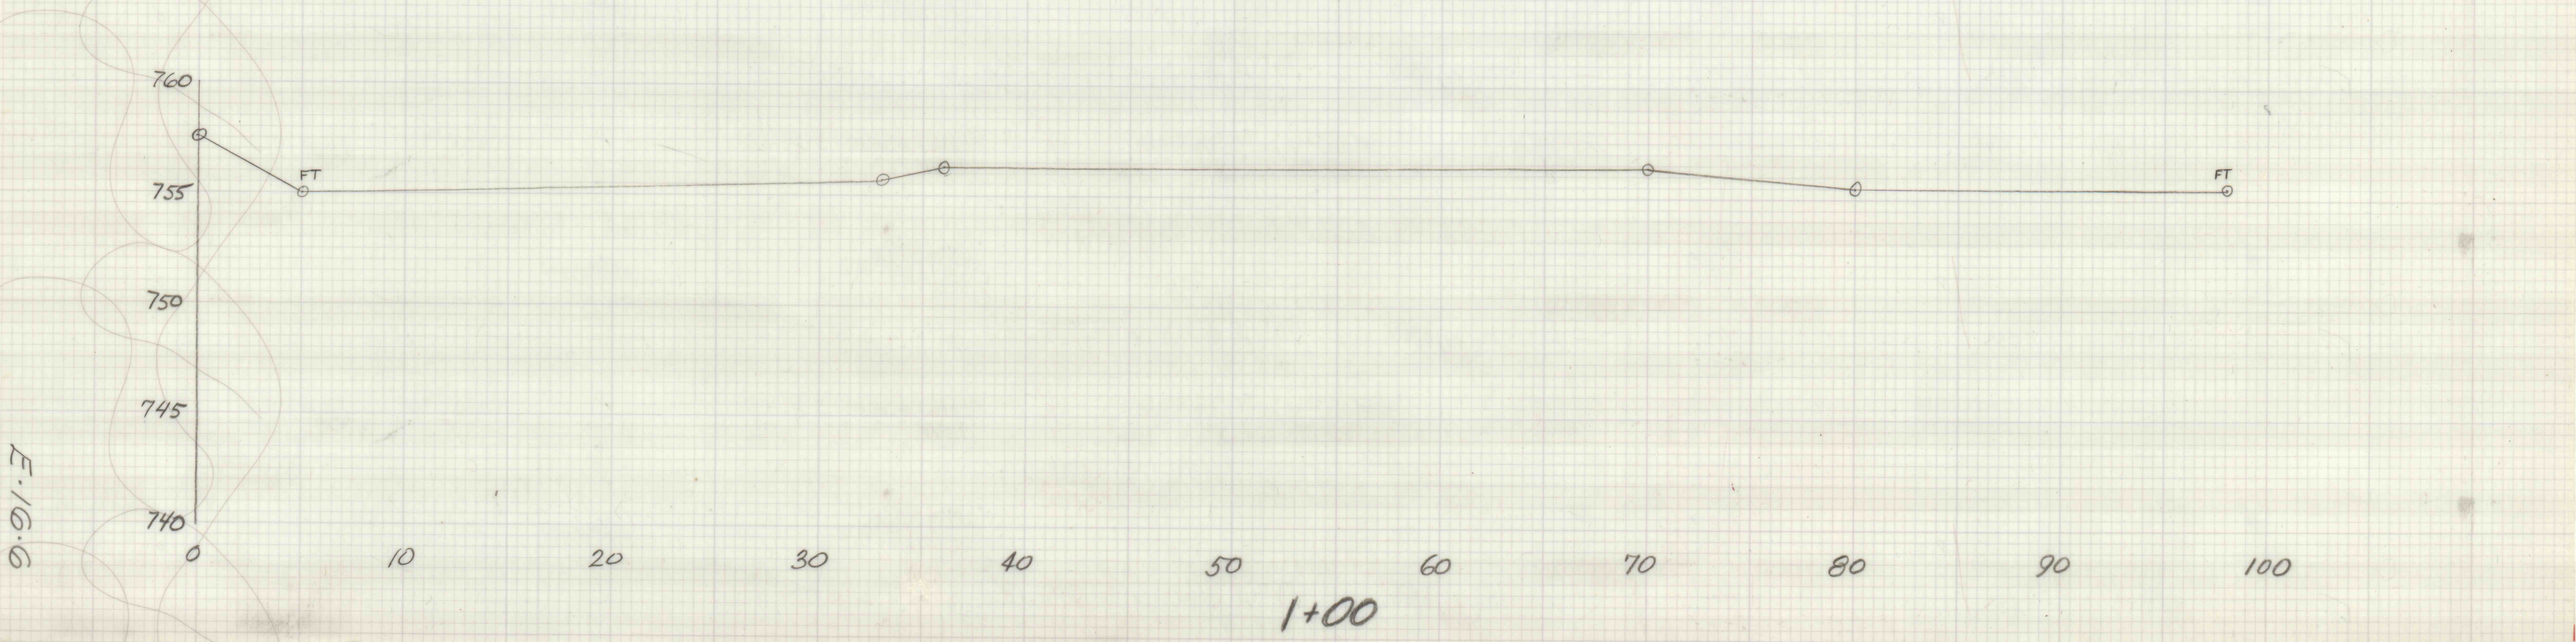


RAUSCH CREEK HEADWORKS PRELIM SEC'S, 5-1-79

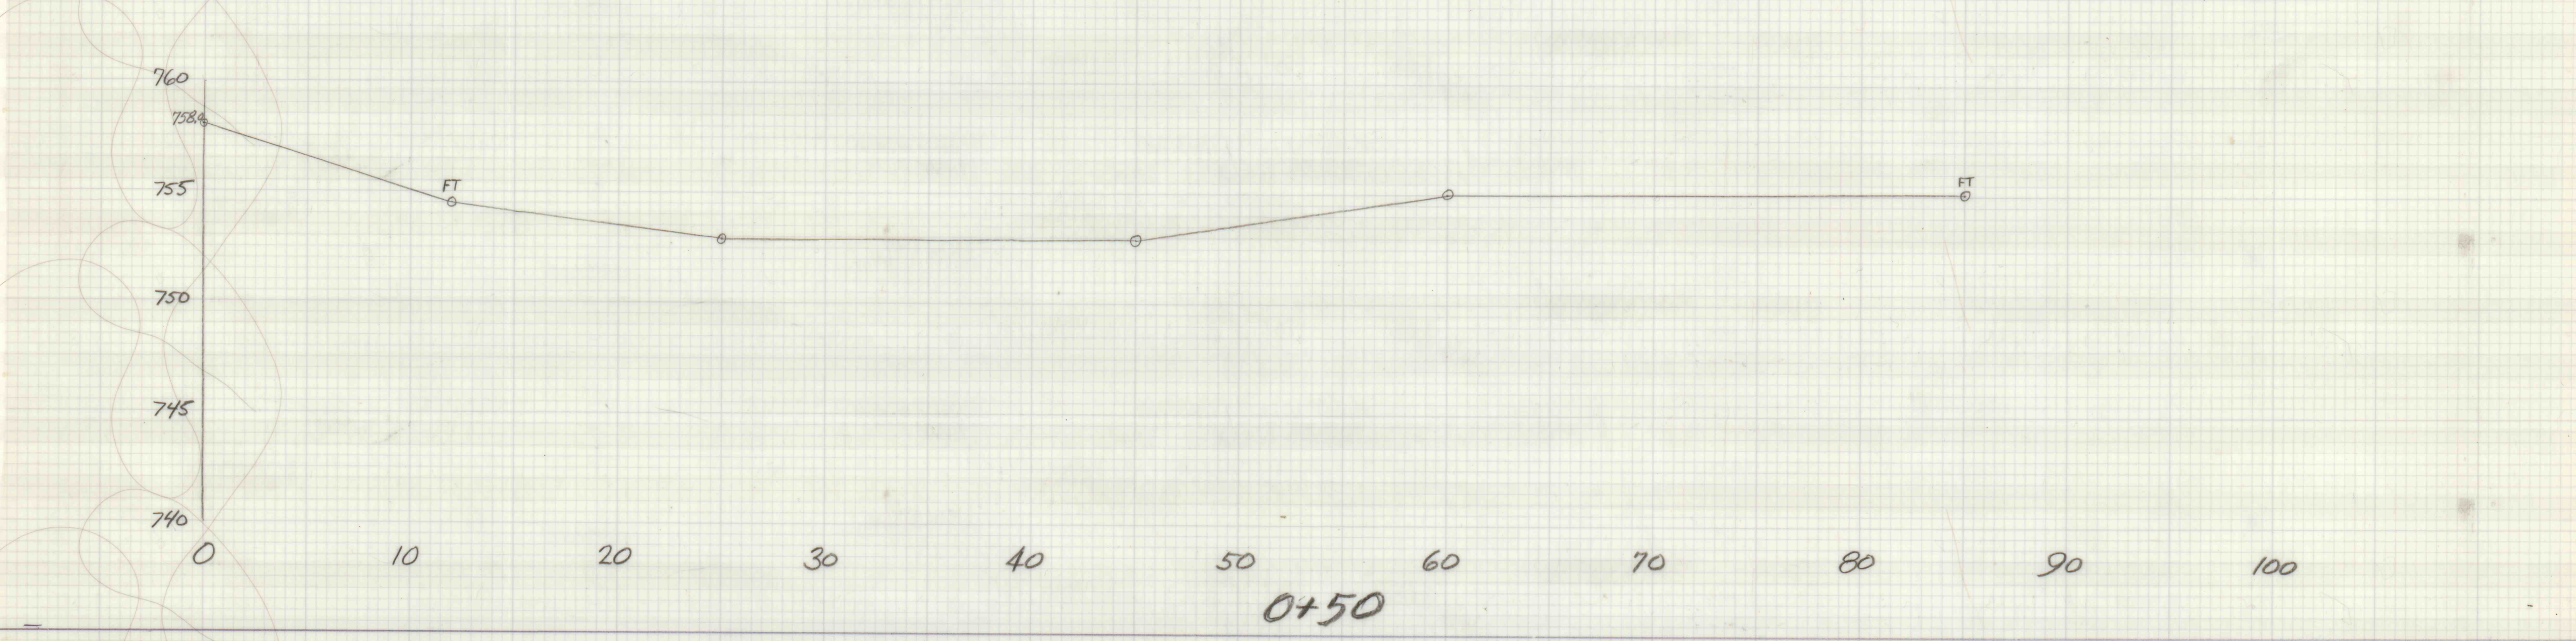

H: 1" = 5'
V: 1" = 5'

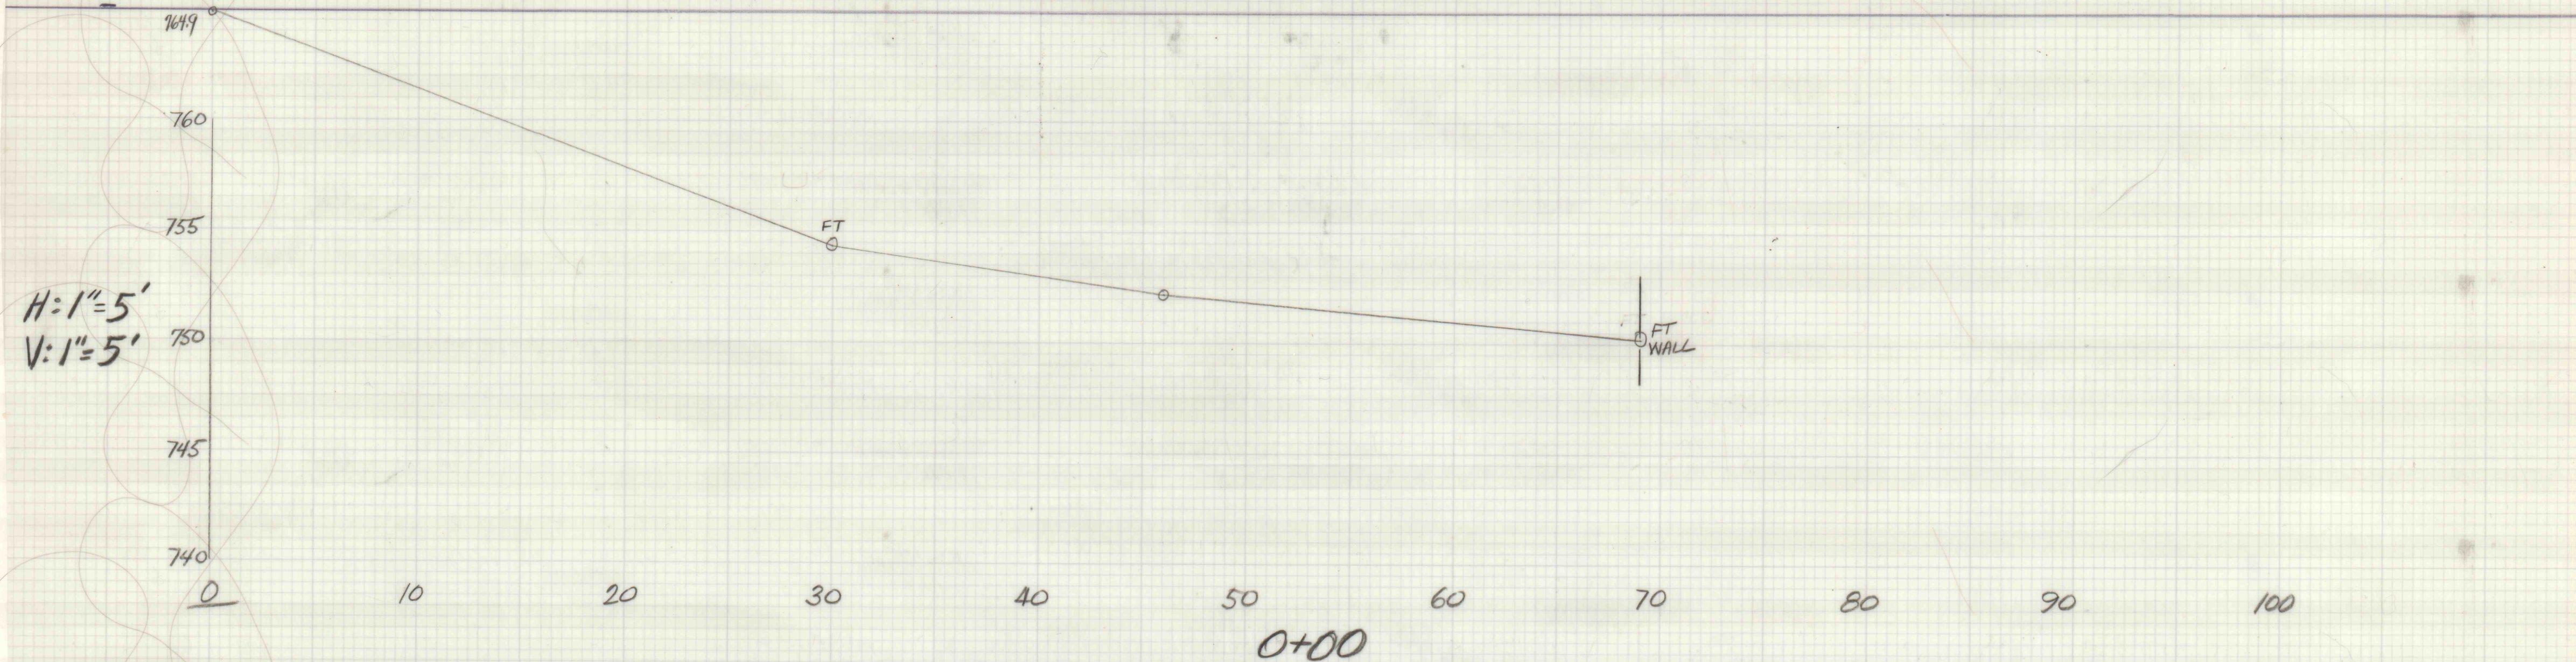

E-16.6