SL-112-11F

6+75N
297.6E

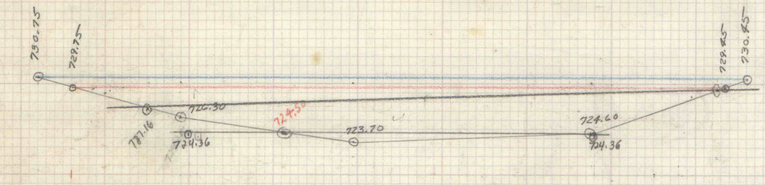

7+00N
297.6E

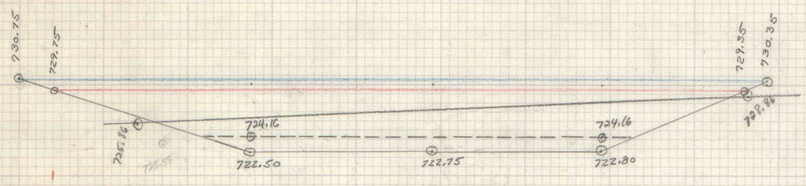

7+25N
297.6E

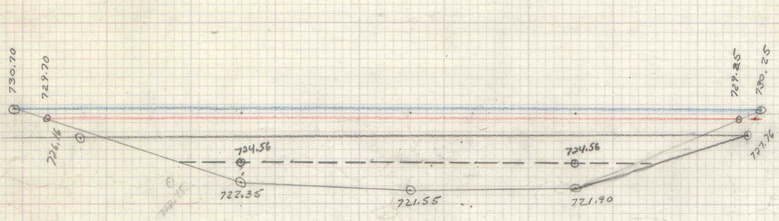

7+50N
297.6E

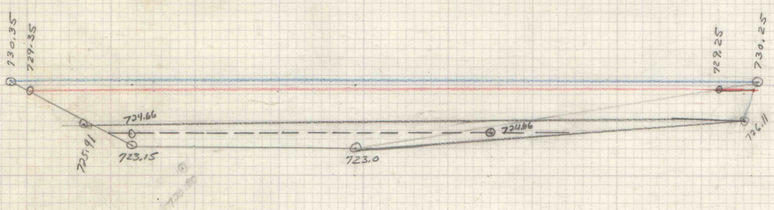

7+75N
297.6E

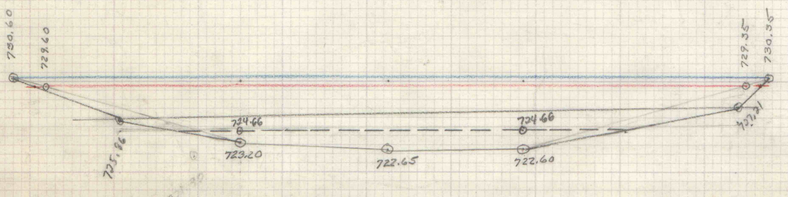

8+00N
297.6E

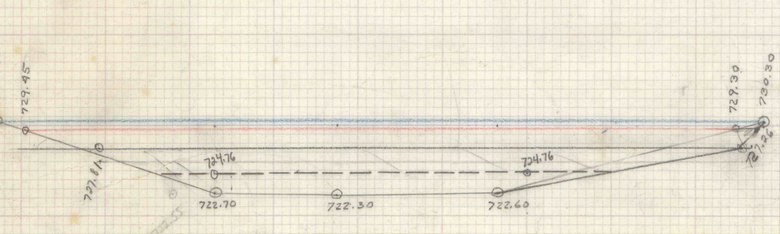

8+25N
297.6E

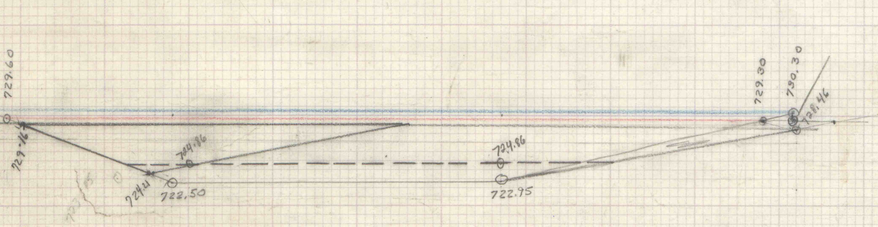

8+50N
297.6E

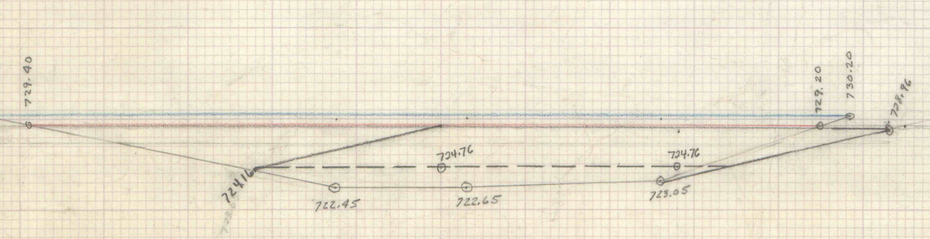

9+00N
297.6E

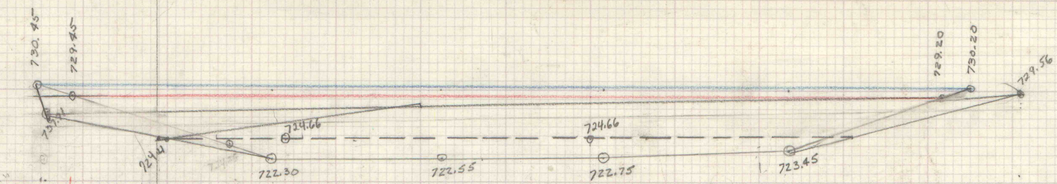

9+25N
297.6E

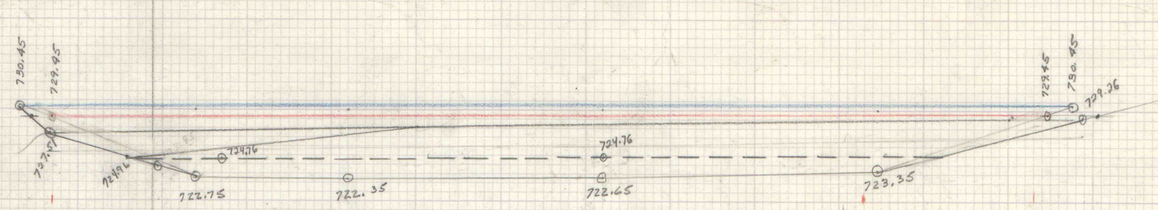

9+50N
297.6E

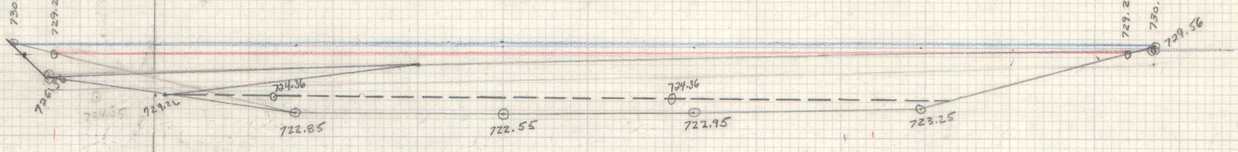

9+75N
297.6E

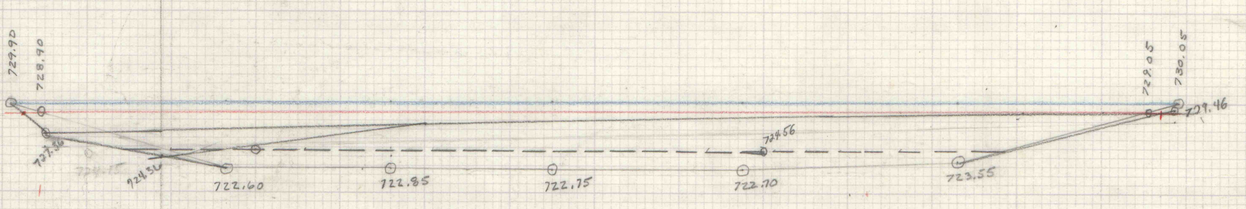

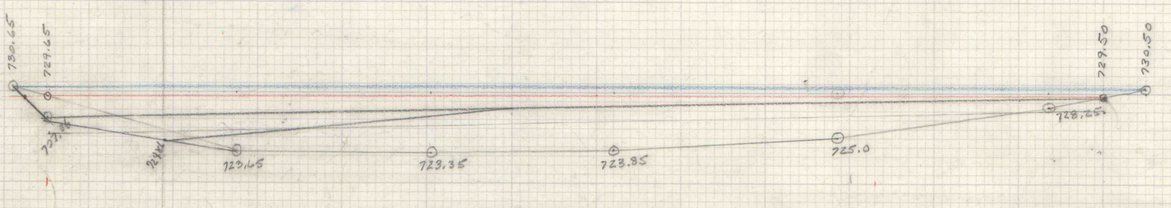

RAUSCH CREEK
LAGOON #1

SCALE 1" = 10' VERT.
1" = 20' HORZ.

Dpred 11/77