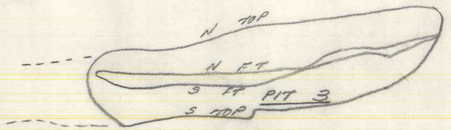

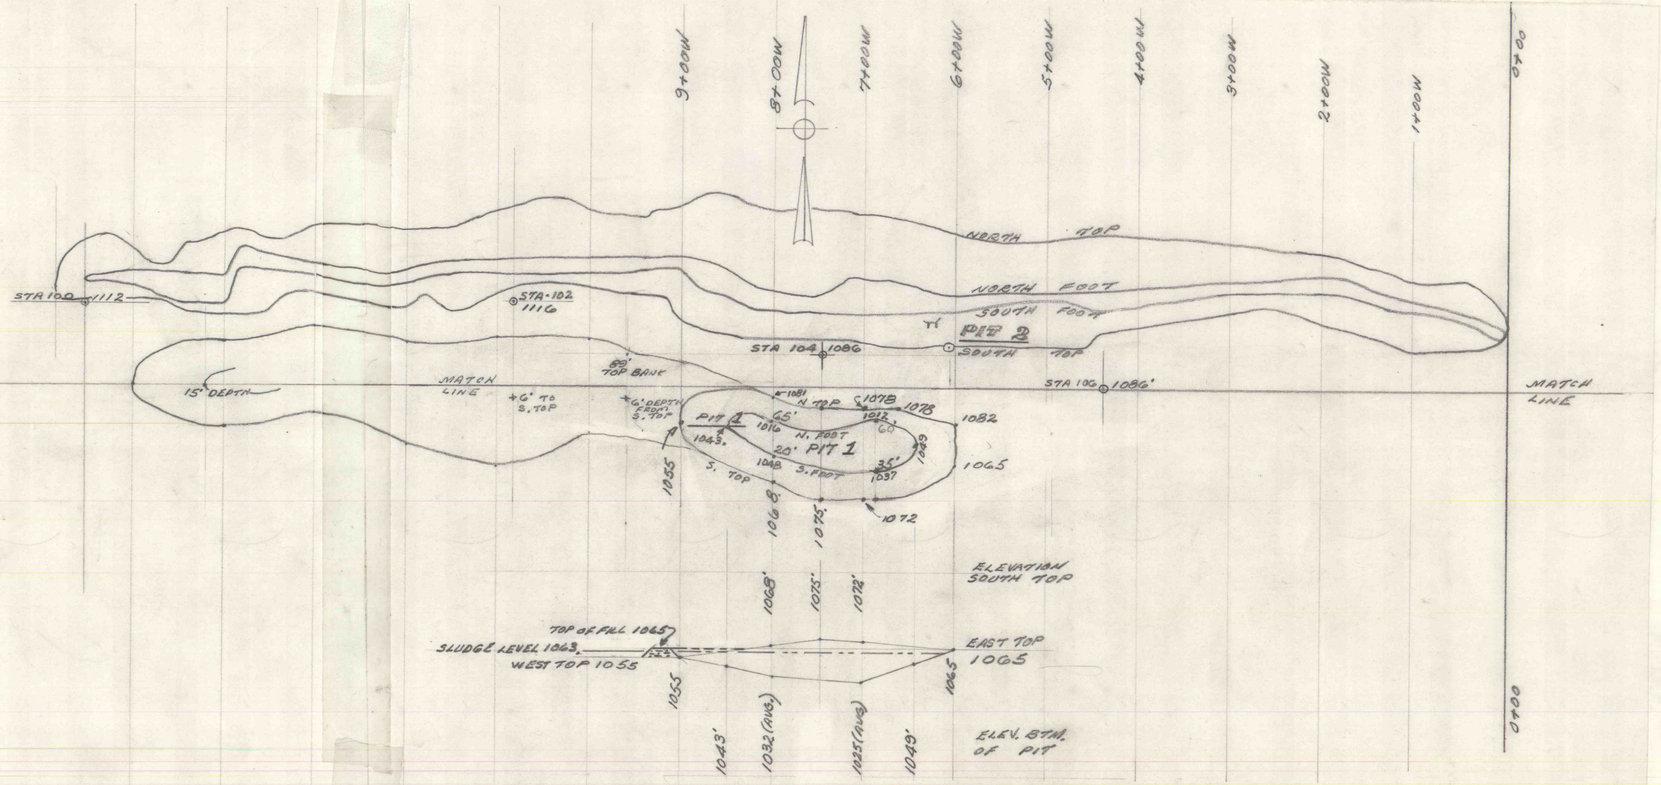

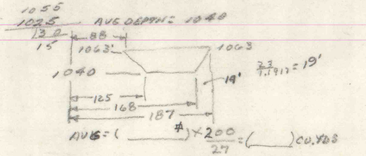

1" = 100'
12.17.79
RAUSCH CREEK STRIP PITS