



ANDREW RUSSELL TRACT

WM. MARSHALL TRACT

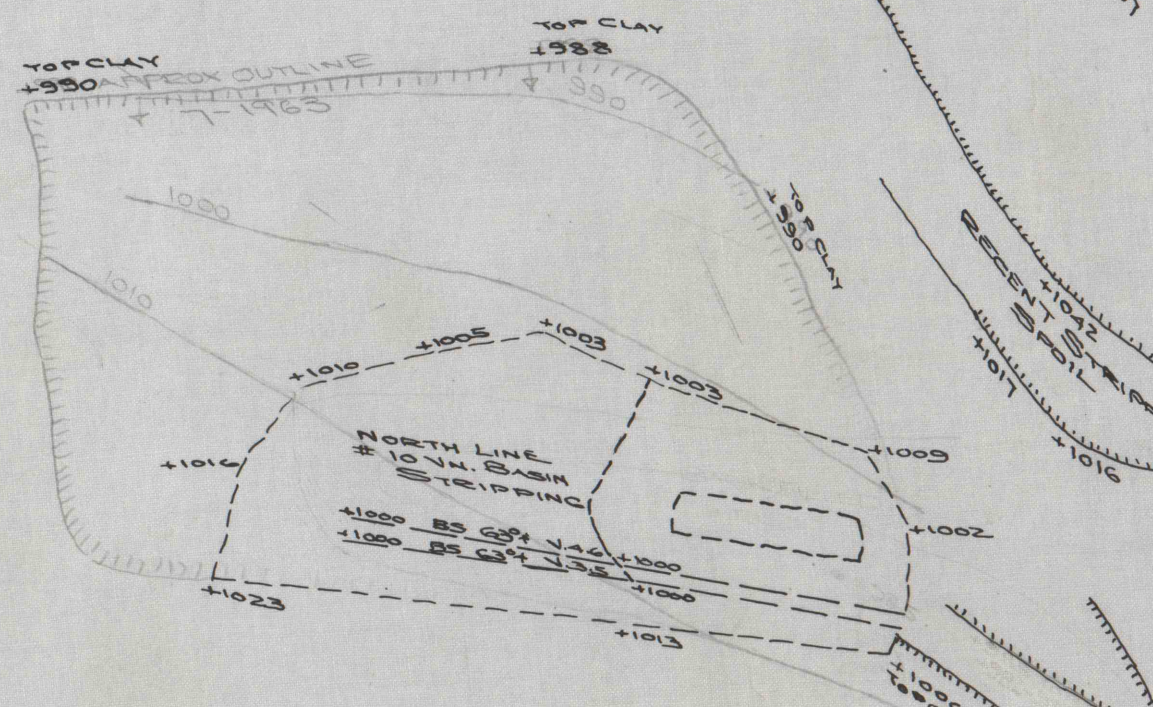

TOP CLAY
+990
TOP CLAY
+992
TOP CLAY
+996
RECENT STRIPPING
+1012
TOP CLAY
+1012
NORTH LINE
#10 V.M. BASIN
STRIPPING
+1000 BS

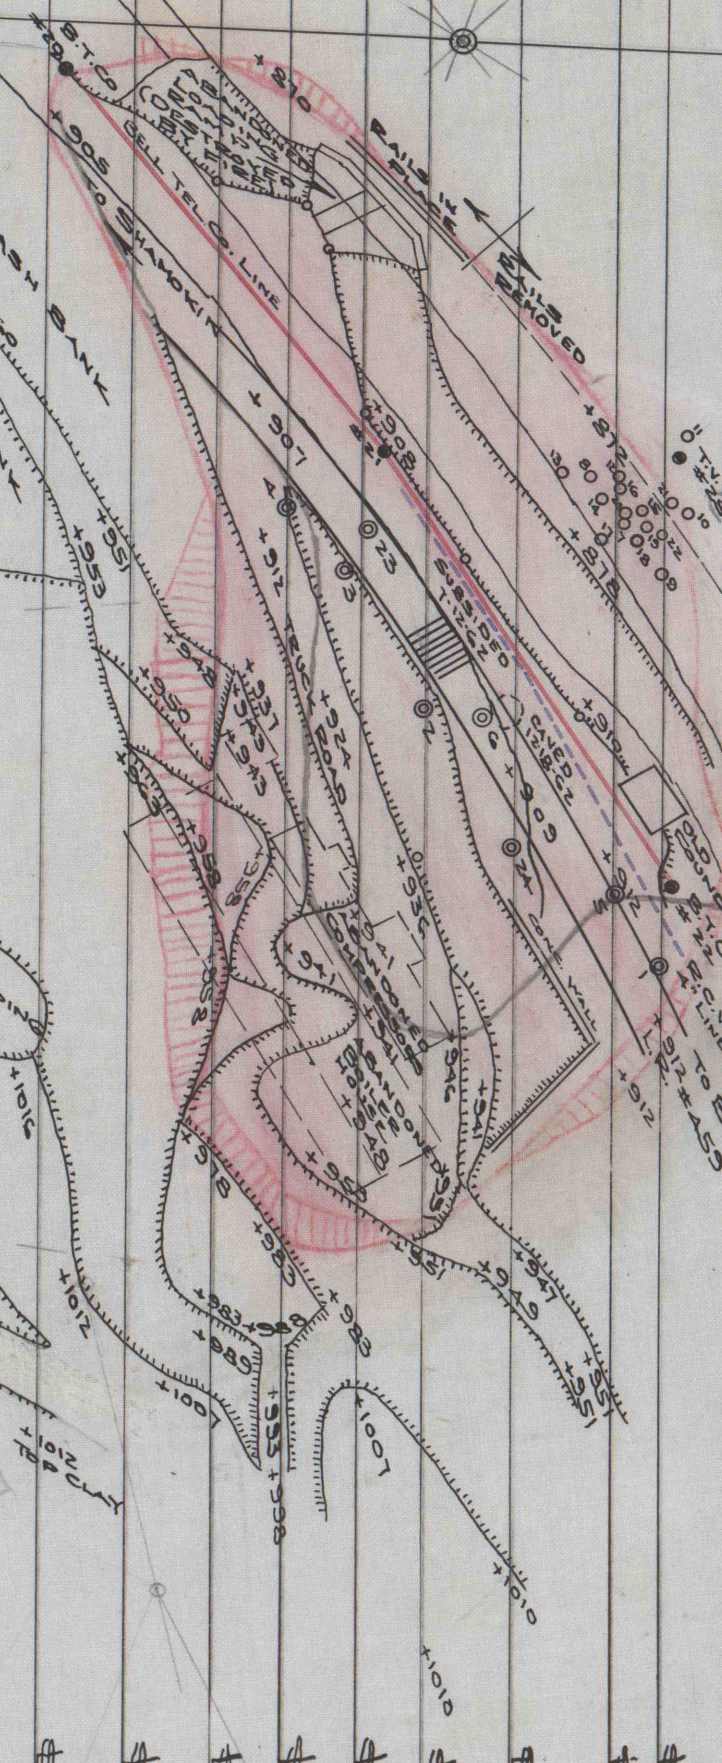

BURNSIDE COLLIERY
SURFACE FEATURES
ADJOINING FIRE IN HIGHWAY FILL
L.R. No. 459 NORTHWEST OF BURNSIDE
1" = 100'